


47-9

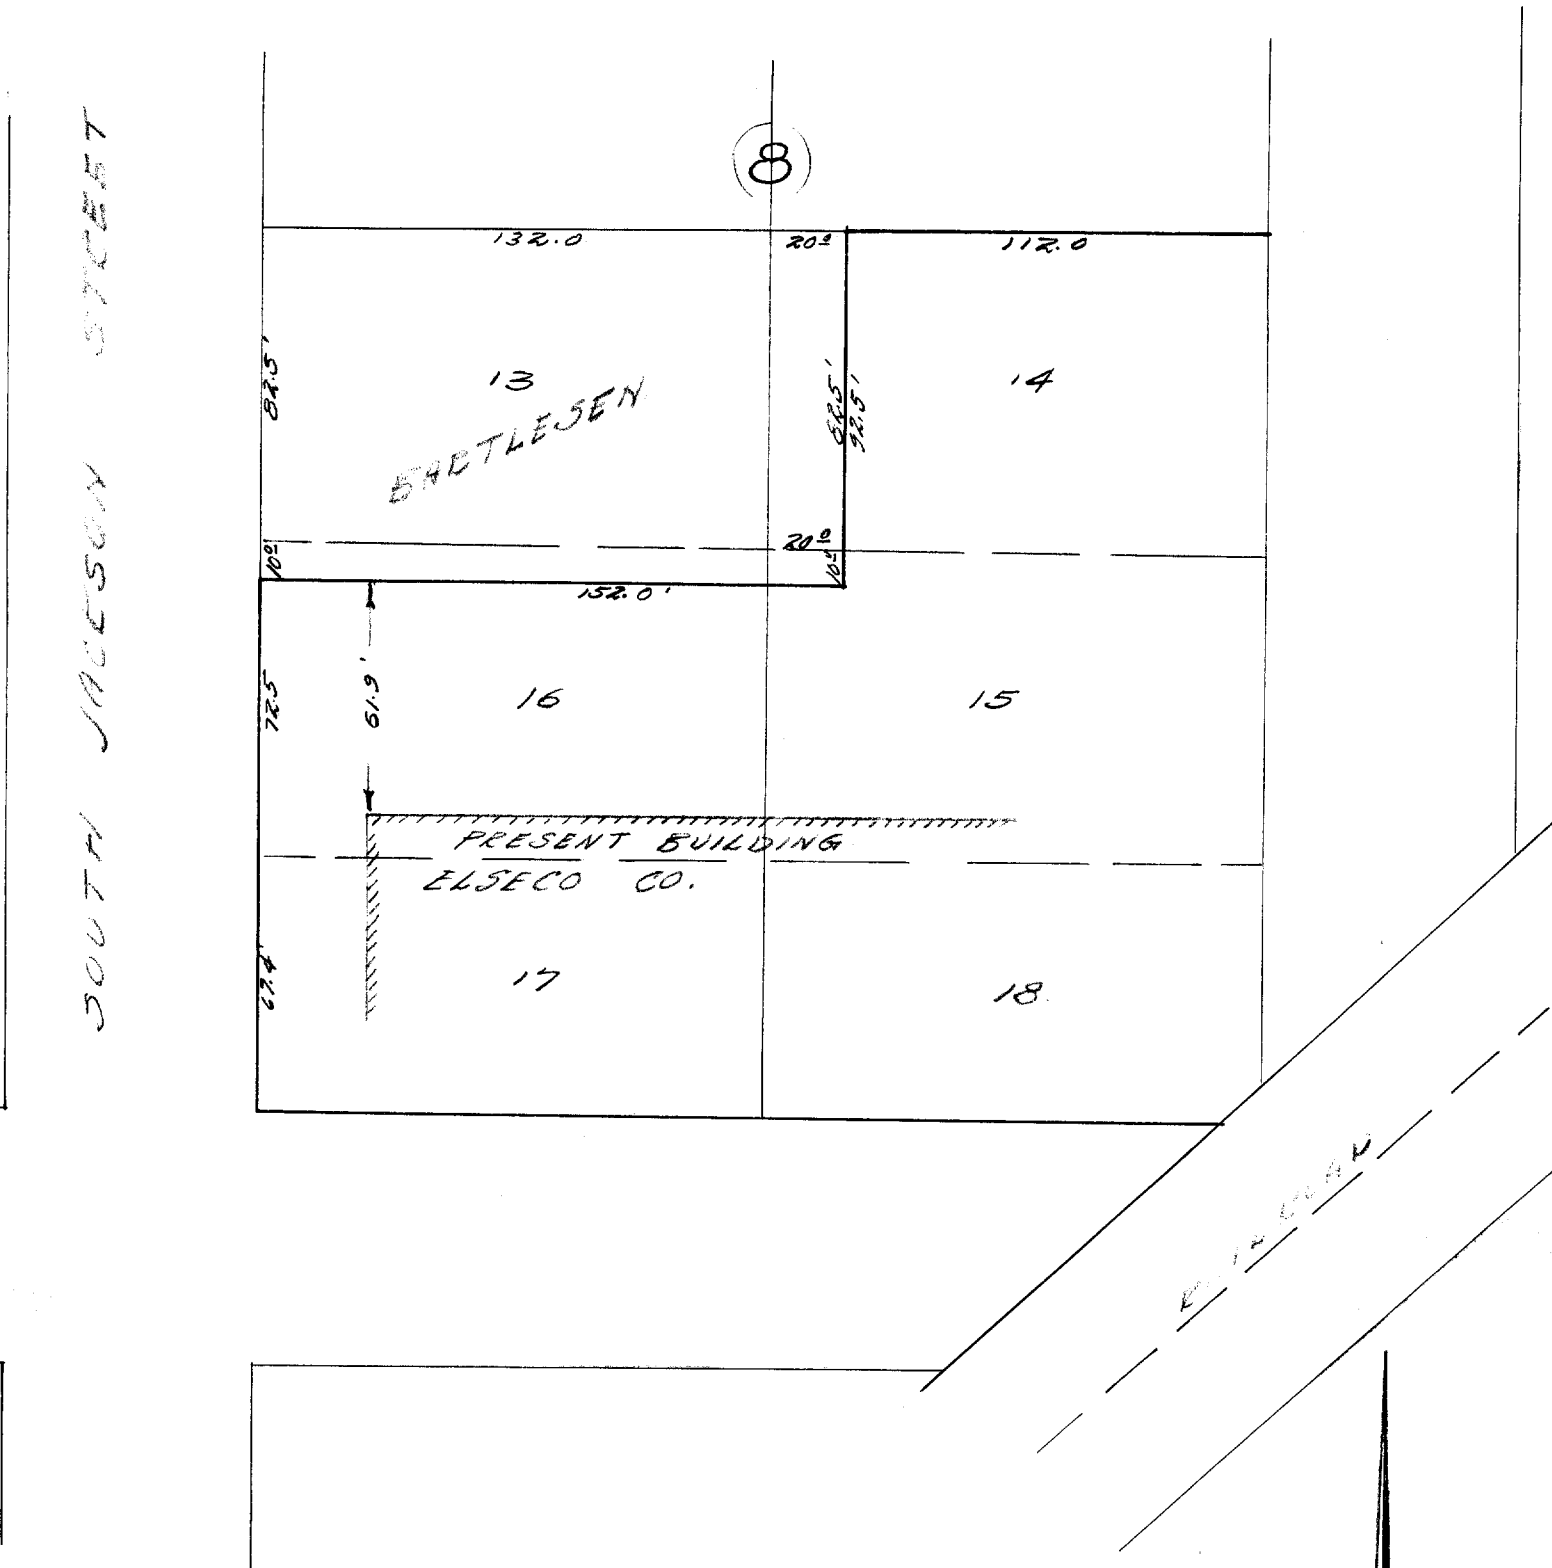

DESCRIPTION:

The north 10 feet of Lot 16, Block 8, Elderkins Addition to the City of Elkhorn; also the west 20 feet of Lot 14, Block 8 in said subdivision, and also the west 20 feet of the north 10 feet of Lot 15 Block 8, in said subdivision.

CERTIFICATE:

I, hereby certify that I have on this the 2nd day of October 1947, surveyed the above described property according to the official record on file in the office of the Recorder of Deeds in and for Walworth County, Wisconsin, and find that the measurements and bearings of the boundary lines of said property as taken at the site on this day, substantially agree with those in the above description and that no encroachments exist.

SIGNED AND SEALED THIS 2ND DAY OF OCTOBER 1947.

Joseph M. Biagi
Joseph M. Biagi, Professional Engineer
Elkhorn Wisconsin.