

Plat of Survey


of

Tax Parcel No: ...XUSW 0002...

Beginning at the Northeast corner of Lot 1 of Block No. 1 of Rockwell Brothers Addition to the City of Elkhorn according to the recorded plat thereof, thence South 8 rods, thence East 5 rods thence North 8 rods; thence West 5 rods to the place of beginning.

Surveyed for: Ken Whitmore
105 West Rockwell
Elkhorn Wisconsin. 53121

Bearings referenced to
C.S.M. 756.

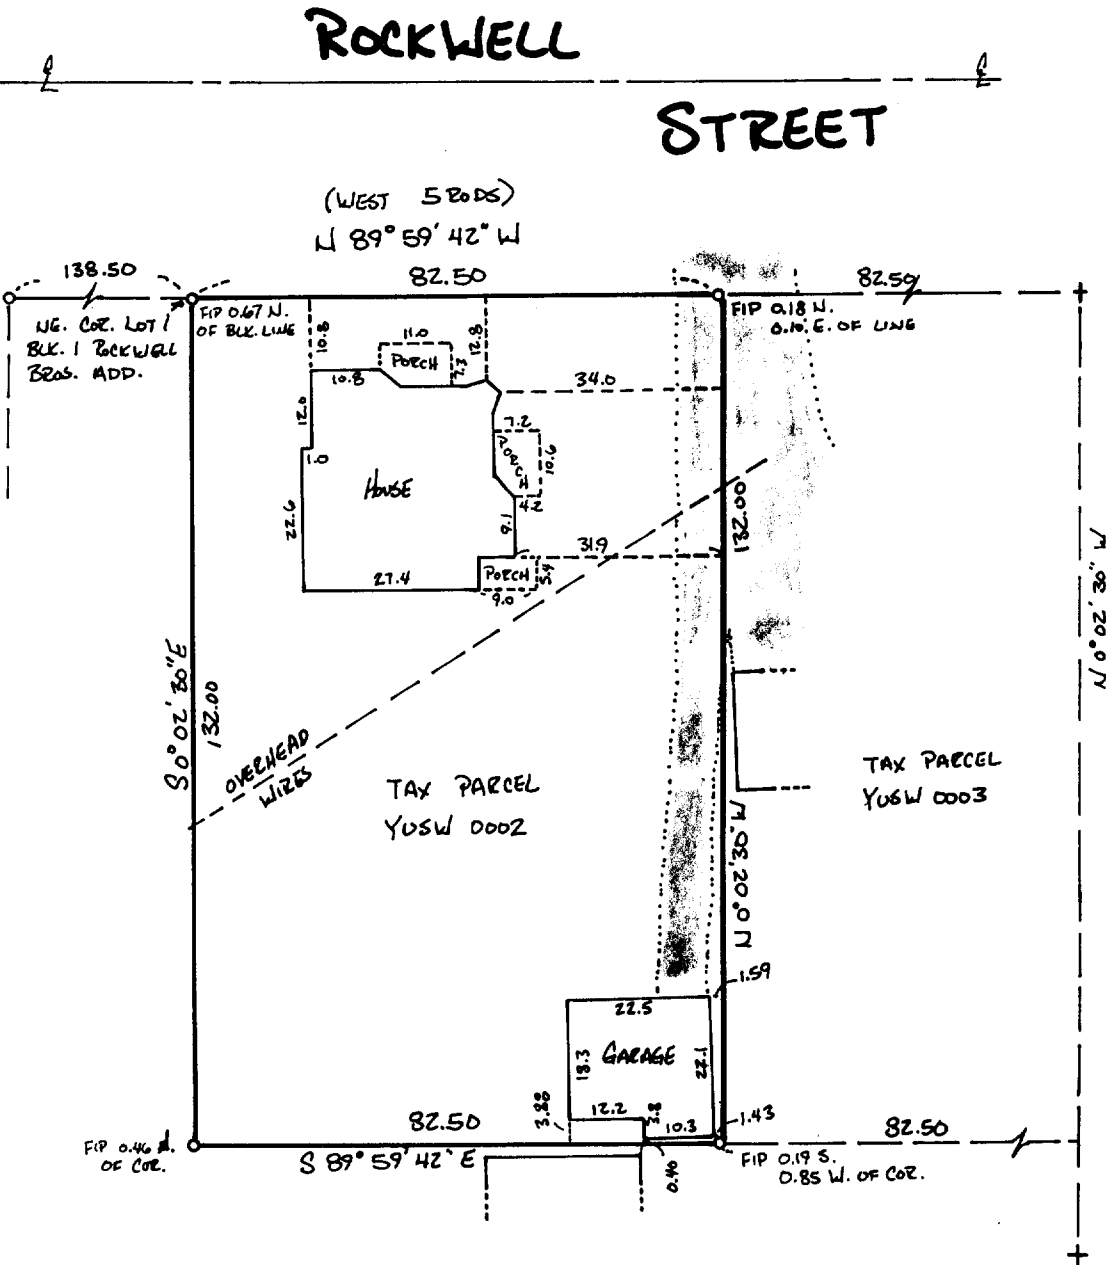

Copyright © 1989 by Jensen Surveying & Mapping S.C.
All rights reserved. No part of this survey plat may be reproduced or transmitted in any form by any means - graphic, electronic, or mechanical, including photocopying, tracing, or information storage and retrieval systems - without permission in writing from Thomas P.A. Jensen.


I, Thomas P.A. Jensen, Wisconsin Registered Land Surveyor, do hereby certify that this survey was performed by me, or under my direction, in full compliance with the owner's/agent's instructions and Chapter A-E 7 of the Wisconsin Administrative Code 'Minimum Standards For Property Surveys', and that this map is an accurate representation thereof to the best of my knowledge and belief.

Note: This survey plat is not
certified unless signed
and sealed in red ink.

Thomas P.A. Jensen R.L.S. 1084

- YUSW-2
Legend
- - Found iron pipe
 - () - Recorded as dimension
 - / - Gravel surface
 - + - Found chiselled cross

Jensen Surveying & Mapping S.C.
45 South Wisconsin Street P.O. Box 322
Elkhorn, Wisconsin. 53121.
(414) 723-3434

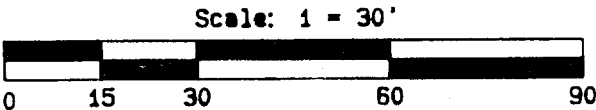

Mapping date: May 9, 1989
Revisions: _____
Sheet 1 of 1 Sheets
Job reference number:
1989.048