


LOCKWELL ST

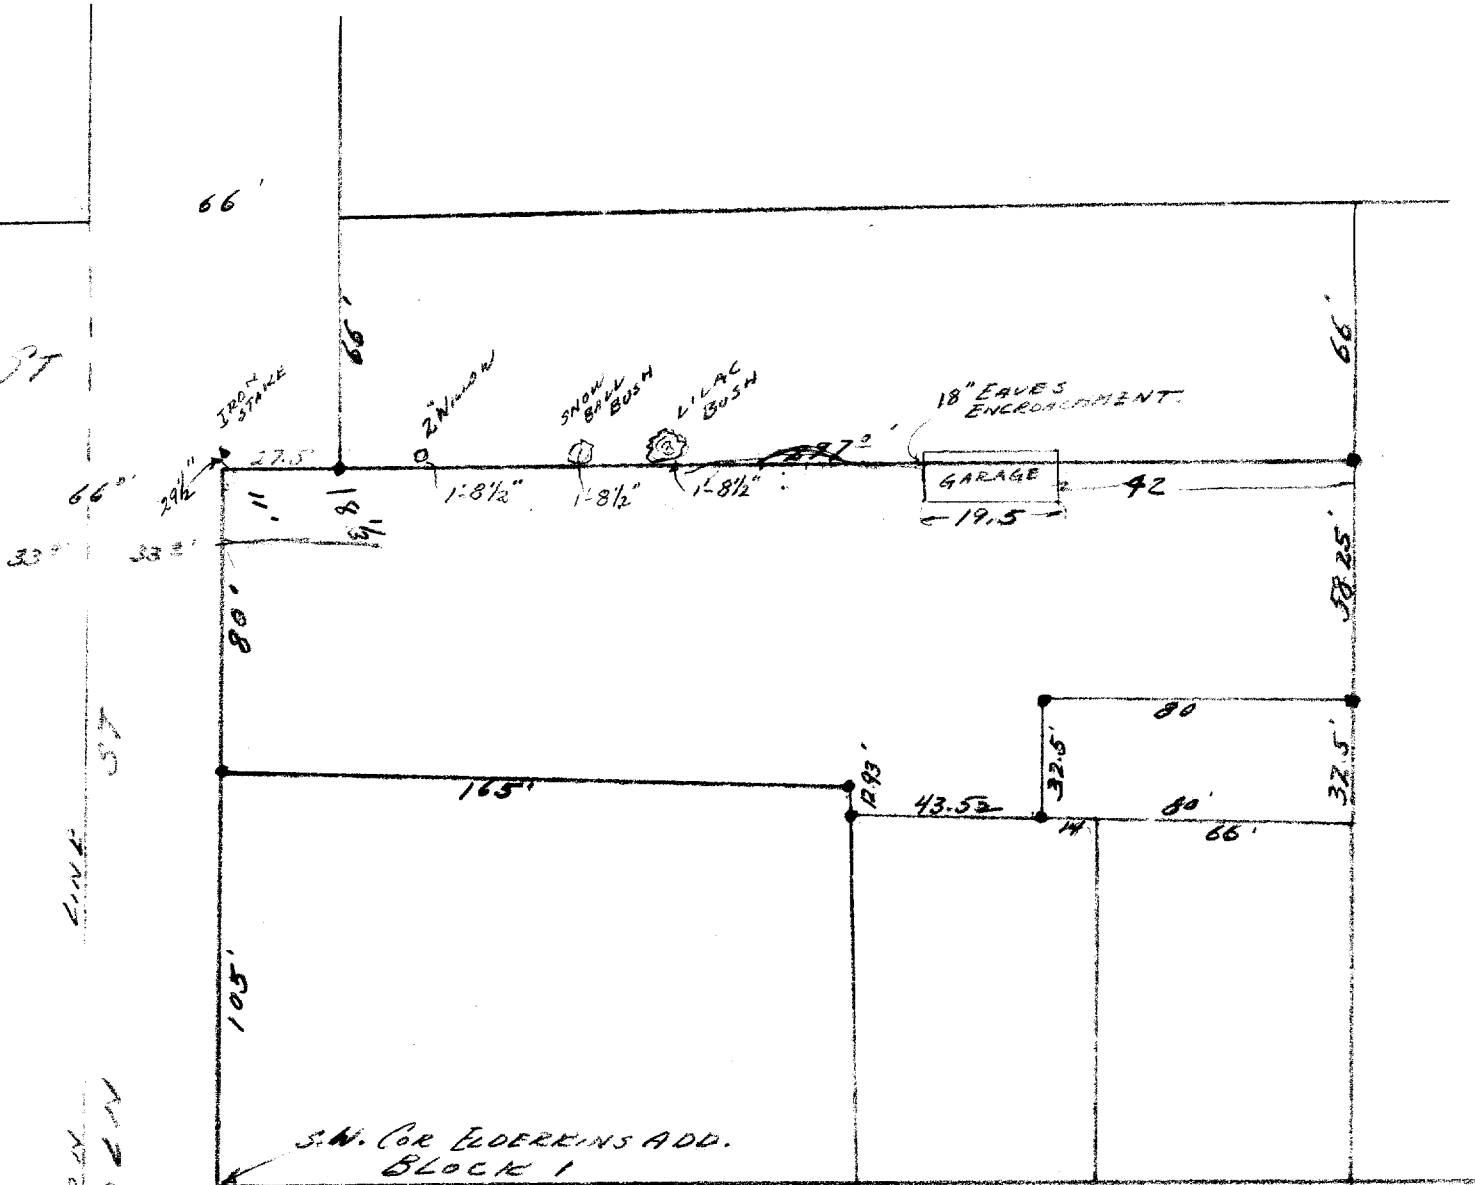

MARSHALL ST

4-23B

no date
Biosh

- FK 12 - 2 acres out of this tract,
- FK 13 - (no date given)
- 14
- 15