


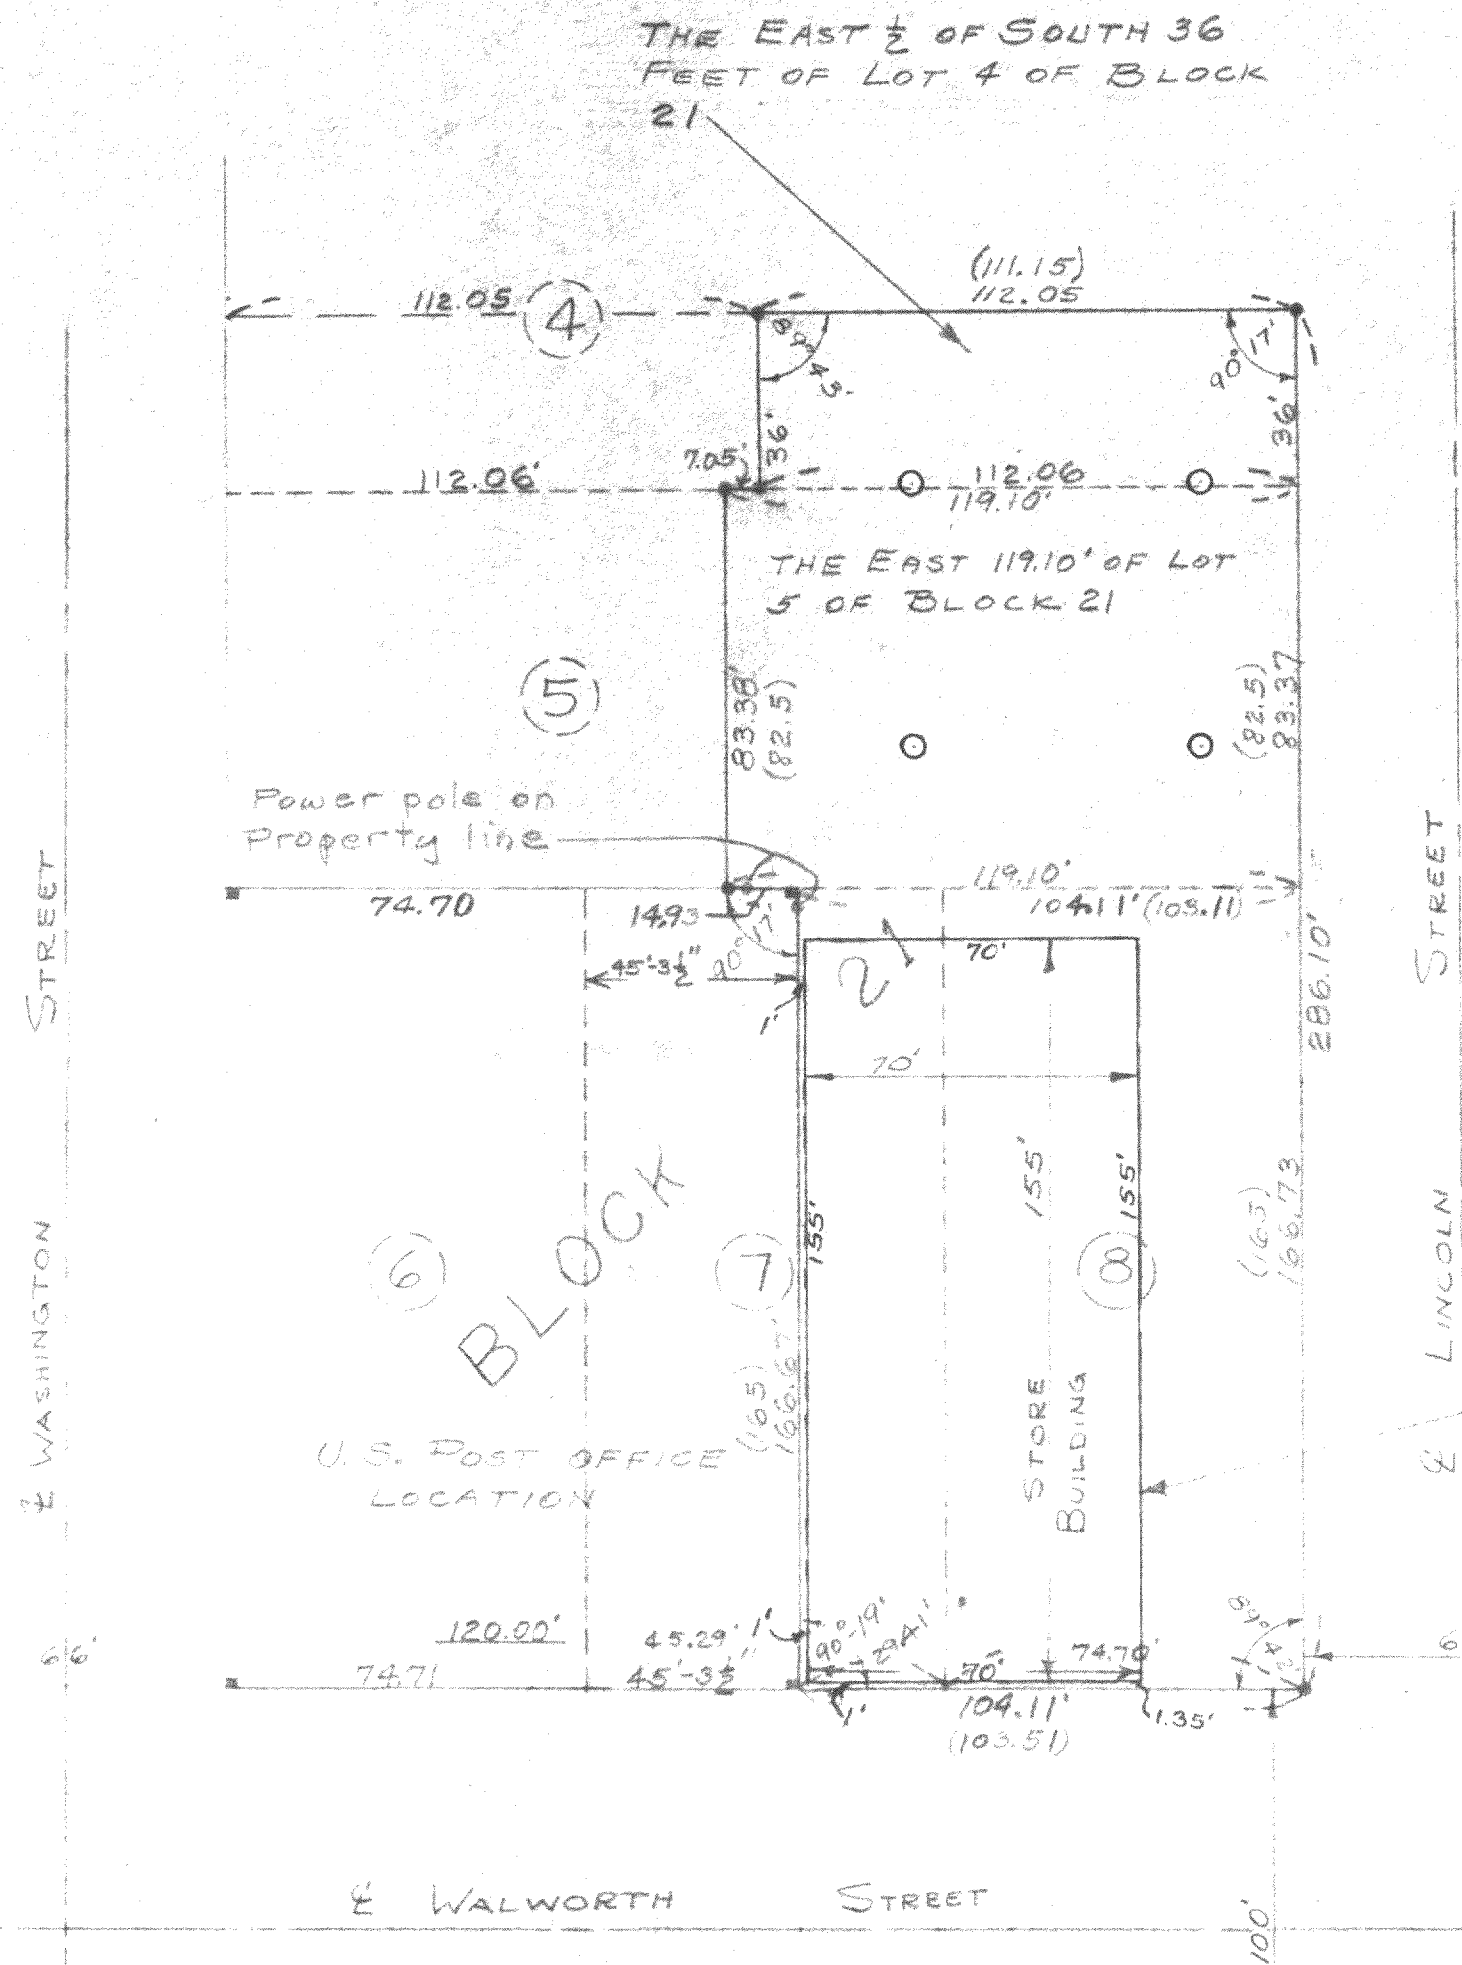

• - Concrete monu.
 ■ - Stone monu.
 (82.5') Platted Lot size
 33.3' Measured Lot size
 O Parking Light Poles

ONE STORY BRICK AND CONCRETE BLOCK BUILDING

SURVEYOR'S CERTIFICATE

I certify that I have surveyed the property described hereon and that the plat shown hereon is an accurate survey and a true representation thereof and correctly shows the exterior boundary lines and location of buildings and other improvements on said property and the correct measurements thereof.

Lloyd L. Jensen
 County Surveyor
 Elkhorn, Wisconsin
 Sept. 13, 1963

NOTE: ALL OVER RUN IN THE BLOCK HAS BEEN DIVIDED AMONG THE LOTS IN PROPORTION TO THE PLATTED WIDTH, AS SHOWN ON CITY PLAT BOOK.

STREET NUMBER - 110 EAST WALWORTH STREET


SURVEY CERTIFICATE

July 31, 1963

Plat of survey of land described as follows: Lot seven (7) except the West forty-five (45) feet three and one-half (3-1/2) inches thereof and all of Lot eight (8) of Block 21; The East 119.1 feet of Lot 5 of Block 21; The East 1/2 of the South 36 feet of Lot 4 of Block 21, all of the original plat of the Village (now City) of Elkhorn, Wisconsin.

The undersigned hereby CERTIFIES to THE EQUITABLE LIFE ASSURANCE SOCIETY OF THE UNITED STATES, as of the above date, that the print of survey shown hereon correctly shows the location of all buildings, structures and other improvements situated on the above premises; and that, except as shown, there are no visible easements or rights of way across said premises or any other easements or rights of way of which the undersigned has been advised, no party walls, no encroachments on adjoining premises, streets or alleys by any of said buildings, structures or other improvements, and no encroachments on said premises by buildings, structures or other improvements situated on adjoining premises.

Lloyd L. Jensen
 Lloyd L. Jensen, Surveyor
 Reg. No. S-211

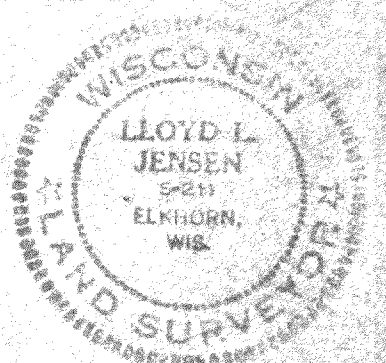

PLAT OF SURVEY OF

LAND LOCATED IN THE CITY OF ELKHORN, WISCONSIN.

Lloyd L. Jensen
 SURVEYOR



SCALE 1" = 40'

DATE SEPT. 13, 1963

PLAT OF SURVEY

OF

PART OF LOTS 4-5-7-8, BLOCK 21
OF THE ORIGINAL PLAT TO THE CITY OF
ELKHORN, WALWORTH COUNTY, WISCONSIN.

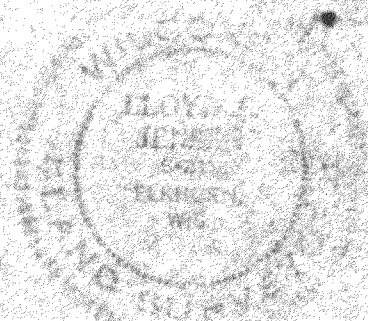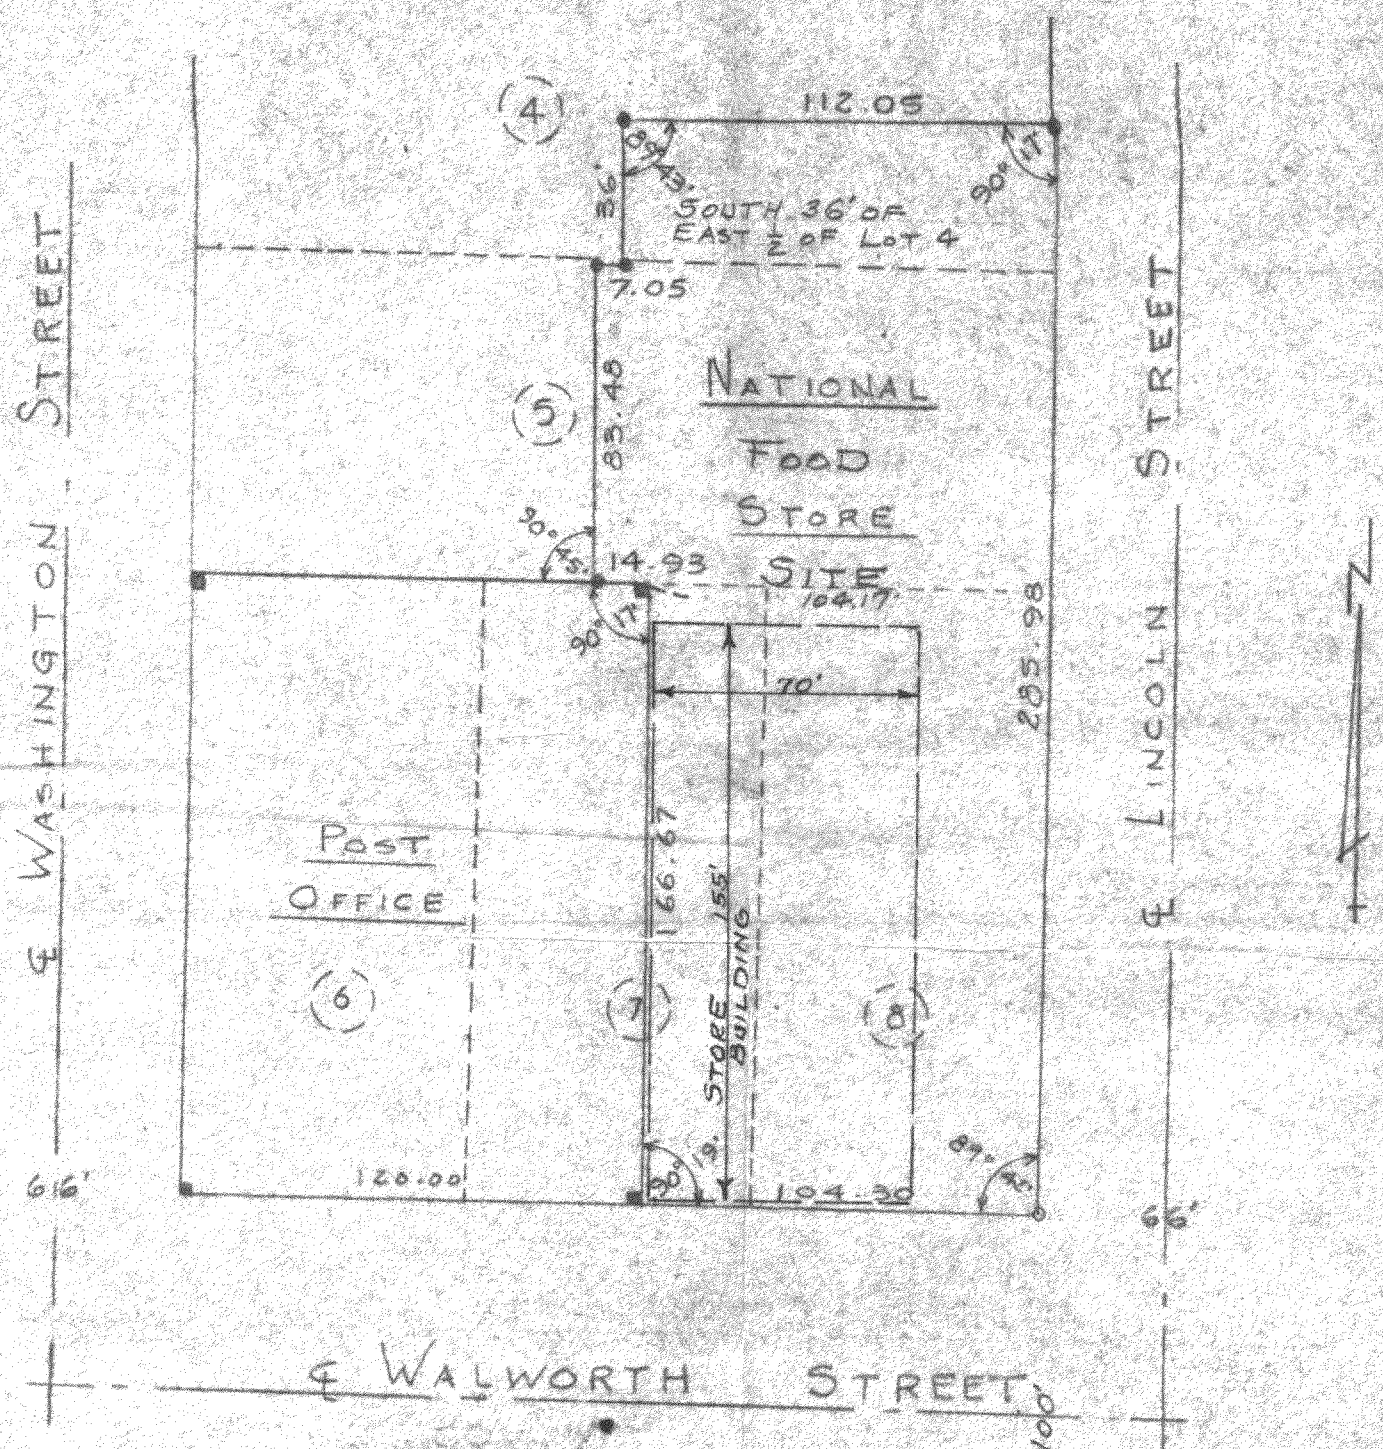

SURVEY AND PLAT BY
JENSEN & JOHNSON
CIVIL ENGINEERS AND SURVEYORS
Elkhorn, Wisconsin

LEGEND
○ — Iron Pipe
● — Concrete Monument
Scale 1" = 50'

WE CERTIFY: That we have surveyed the above described property and that the plat shown hereon is an accurate survey and a true representation thereof and correctly shows the exterior boundary lines and all divisions of said property.

Date MAY 16, 1963

Lloyd L. Jensen
LLOYD L. JENSEN, Partner

Wisconsin Registered Land Surveyor, No. S-211

OP-175