


**ABELL
SURVEYING & MAPPING
DELAVER, WISCONSIN 53115
414-728-8787**

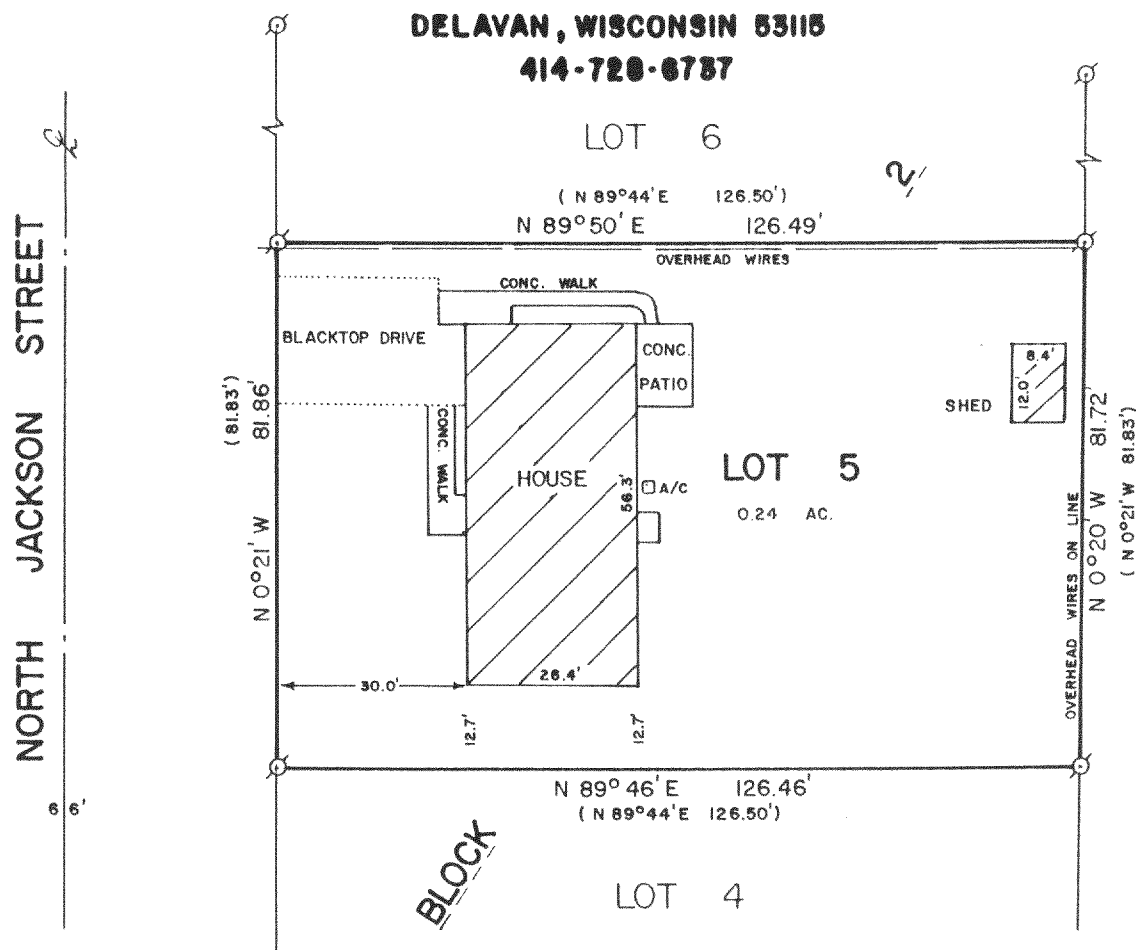


PLAT OF SURVEY OF

LOT 5, BLOCK 2, TREE TOWNS SUBDIVISION, LOCATED
IN THE CITY OF ELKHORN, WALWORTH COUNTY, WISCONSIN.

ORDERED BY: ERA LANHAM REALTY
20 S. WASHINGTON ST.
ELKHORN, WI. 53121

NOTE: THE BEARING ON THE WEST LINE OF LOT 5, BLOCK 2 IS
ASSUMED N 0°21' W AS SHOWN ON EXISTING SURVEY
RECORDS.

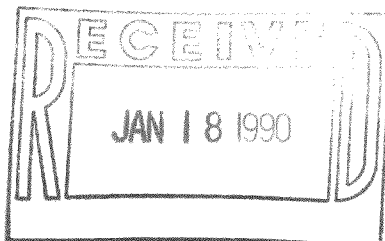

SCALE - 1"=30'

LEGEND

Ø - IRON PIPE FOUND
() - AS SHOWN ON EXISTING
SURVEY RECORDS

I HEREBY CERTIFY THAT I HAVE SURVEYED THE ABOVE DESCRIBED PROPERTY AND THAT THE
ABOVE MAP IS A TRUE REPRESENTATION THEREOF AND SHOWS THE SIZE AND LOCATION OF
THE PROPERTY, ITS EXTERIOR BOUNDARIES, THE LOCATION OF ALL VISIBLE STRUCTURES
AND DIMENSIONS OF ALL PRINCIPAL BUILDINGS THEREON, BOUNDARY FENCES, APPARENT
EASEMENTS, ROADWAYS AND VISIBLE ENCROACHMENTS, IF ANY, TO THE BEST OF MY
KNOWLEDGE AND BELIEF.

THIS SURVEY IS MADE FOR THE USE OF THE PRESENT OWNERS OF THE PROPERTY, AND ALSO
THOSE WHO PURCHASE, MORTGAGE, OR GUARANTEE THE TITLE THEREIN WITHIN ONE (1) YEAR
FROM DATE HEREOF.

David F. Abell
DAVID F. ABELL
WISCONSIN REGISTERED LAND SURVEYOR, S-1596

October 10, 1989
DATE: *October 10, 1989* JOB NUMBER - 89220
NOTE: THIS IS NOT A CERTIFIED COPY UNLESS SEALED.

YTTS-17

C - ELKHORN