


46-13

5 WEIGHT 5

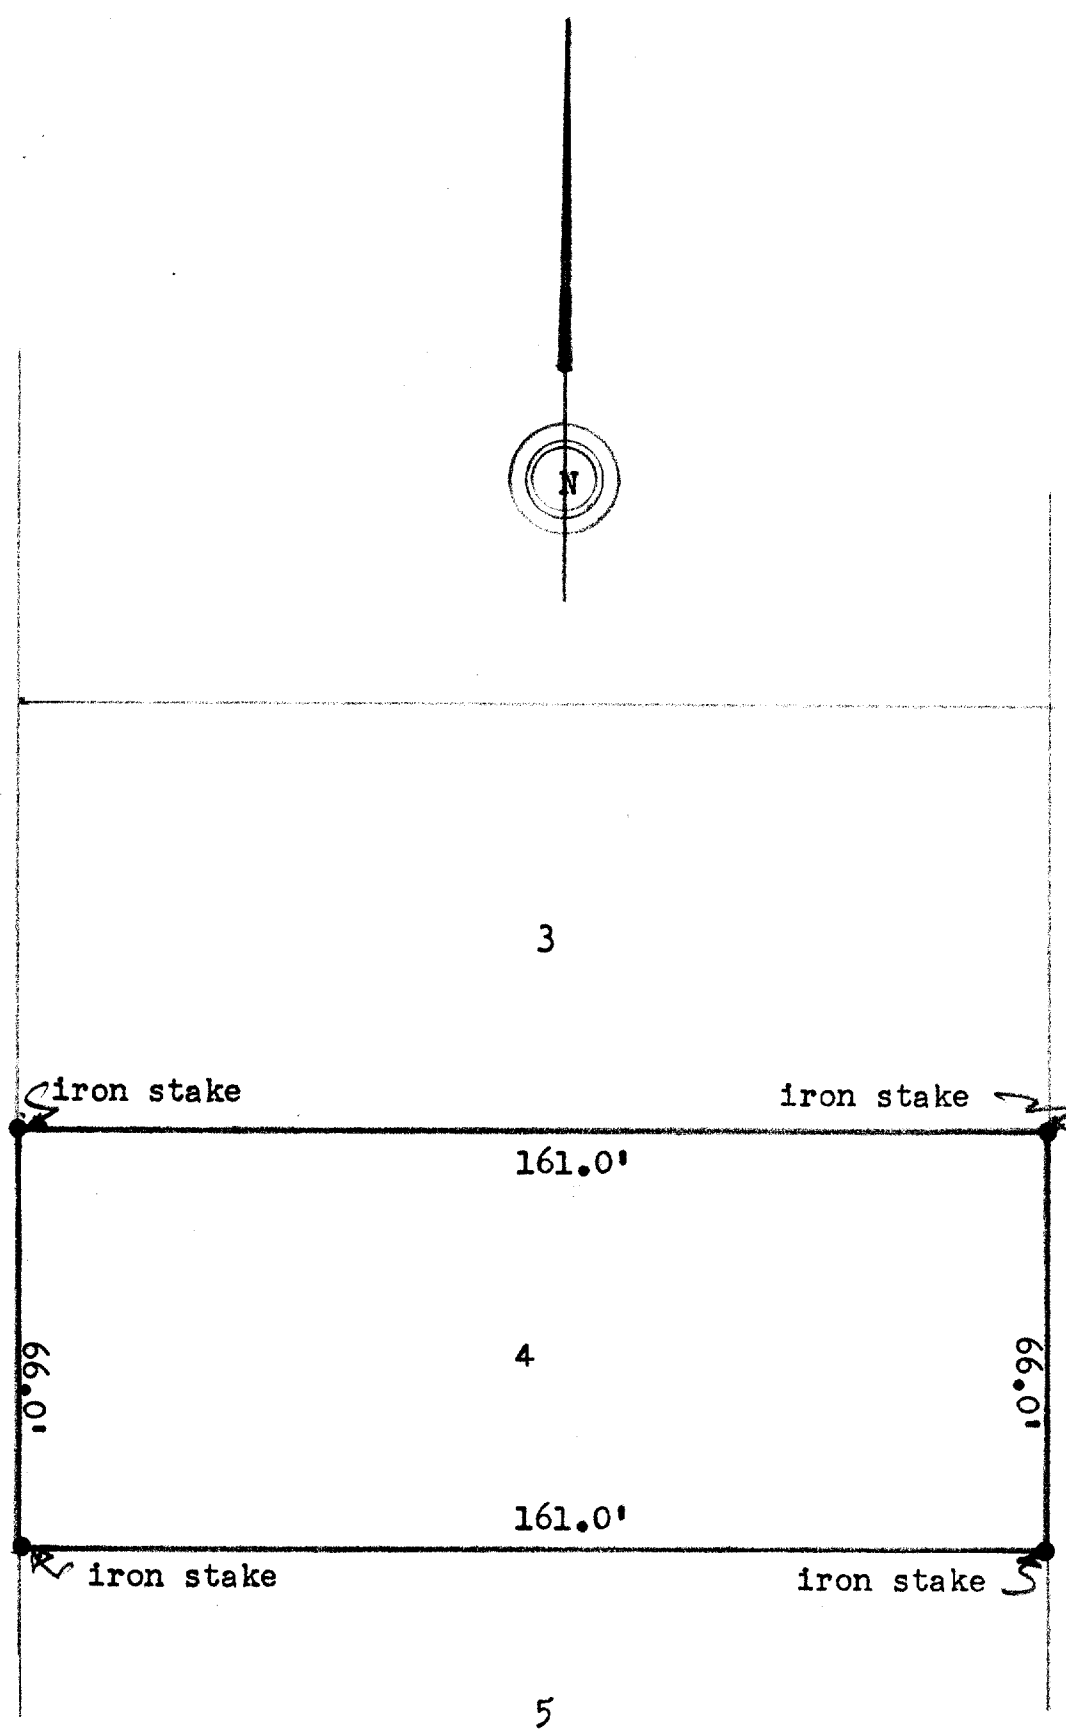

DESCRIPTION: Lot 4, Block 9, Elderkins Addition to the City of Elkhorn Walworth County, Wisconsin.

CERTIFICATE: I, hereby certify that I have on this the 10th day of August 1946, surveyed the above described property.
SIGNED AND SEALED THIS 13TH DAY OF AUGUST 1946.

Joseph M. Biagi
Joseph M. Biagi.
Professional Enginssr.
Elkhorn Wisconsin.

Yek-54

4-58 A