

Plat of Survey


of

Lot 6, Block 16 of the Original Plat of the City of Elkhorn
Walworth County, Wisconsin.

Surveyed for: John Gunyon
121 Eames Street
Elkhorn, Wisconsin. 53121

Bearings are assumed.

BROAD STREET

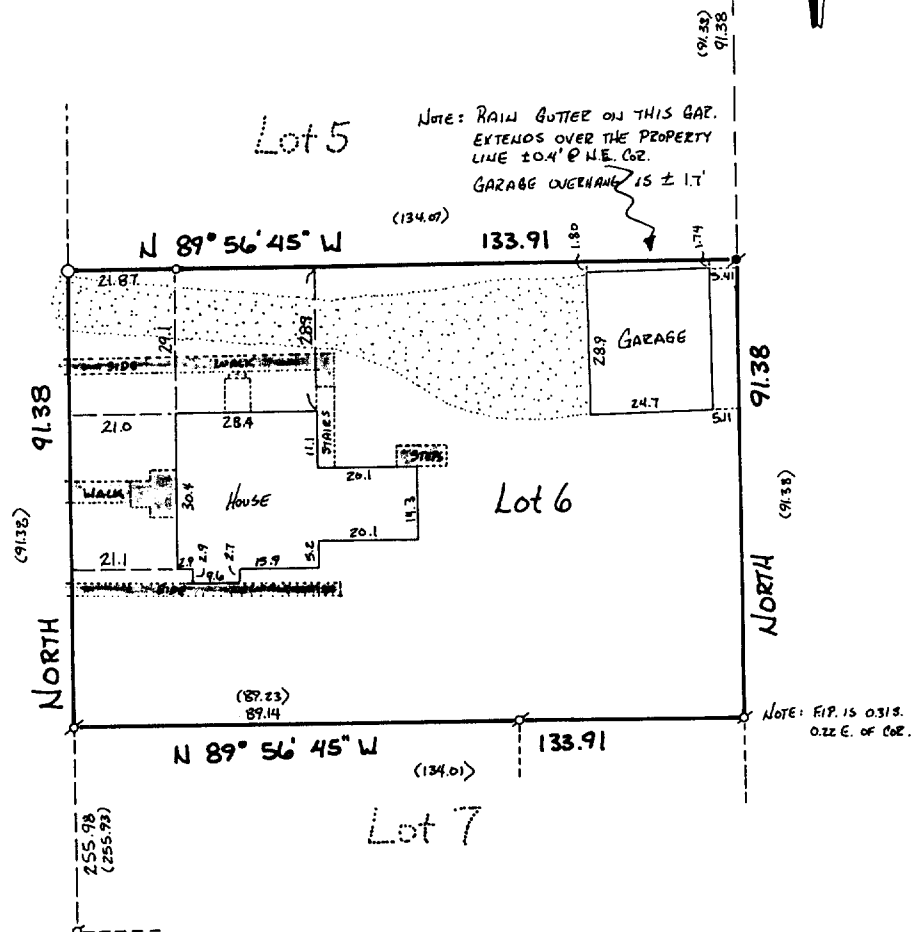

Copyright © 1989 by Jensen Surveying & Mapping S.C.
All rights reserved. No part of this survey plat may be reproduced or transmitted in any form by any means - graphic, electronic, or mechanical, including photocopying, tracing, or information storage and retrieval systems - without permission in writing from Thomas P.A. Jensen.

I, Thomas P.A. Jensen, Wisconsin Registered Land Surveyor, do hereby certify that this survey was performed by me, or under my direction, in full compliance with the owner's/agent's instructions and Chapter A-E 7 of the Wisconsin Administrative Code ' Minimum Standards For Property Surveys ', and that this map is an accurate representation thereof to the best of my knowledge and belief.

Note: This survey plat is not certified unless signed and sealed in red ink.

Thomas P.A. Jensen R.L.S. 1084


Legend

- ⊙ ~ Found iron pipe, 1' dia.
- ⊙ ~ Found iron rod, 1' dia.
- ~ Set iron pipe, 2' dia.
- ~ Set iron pipe, 1' dia.
- () ~ Recorded as dimension
- ▨ ~ Concrete surface
- ▨ ~ Gravel surface

Jensen Surveying & Mapping S.C.

45 South Wisconsin Street P.O. Box 322
Elkhorn, Wisconsin. 53121.
(414) 723-3434

Scale: 1" = 30'

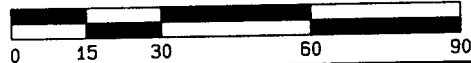


Mapping date: November 1, 1989

Revisions: _____

Sheet 1 of 1 Sheets

Job reference number:
1989.130

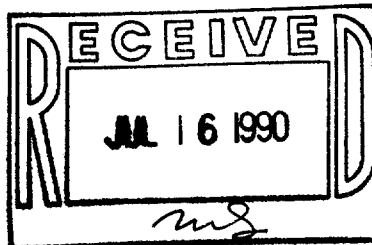

Tax# YOP-105

4-596