

# Farris, Hansen & Associates, Inc.

7 RIDGEWAY COURT, P.O. BOX 437, ELKHORN, WISCONSIN

TEL. 814-723-2000

LOCATION: PART OF LOTS 5 & 6, BLOCK 33  
ROCKWELL'S ADD., CITY OF ELKHORN  
WALWORTH, CO., WISCONSIN  
WORK ORDERED BY: Ronald Chmili

MAP LEGEND


- IRON PIPE STAKE FOUND
- IRON PIPE STAKE SET
- IRON ROD STAKE FOUND 1983
- IRON ROD STAKE SET BY 6/22/90
- CONCRETE MONUMENT FOUND 1983
- (XXXX) RECORD DIMENSION

MAP SCALE IN FEET  
As Noted

GENEVA STREET

SOUTH WASHINGTON STREET


SOUTH WASHINGTON AVE

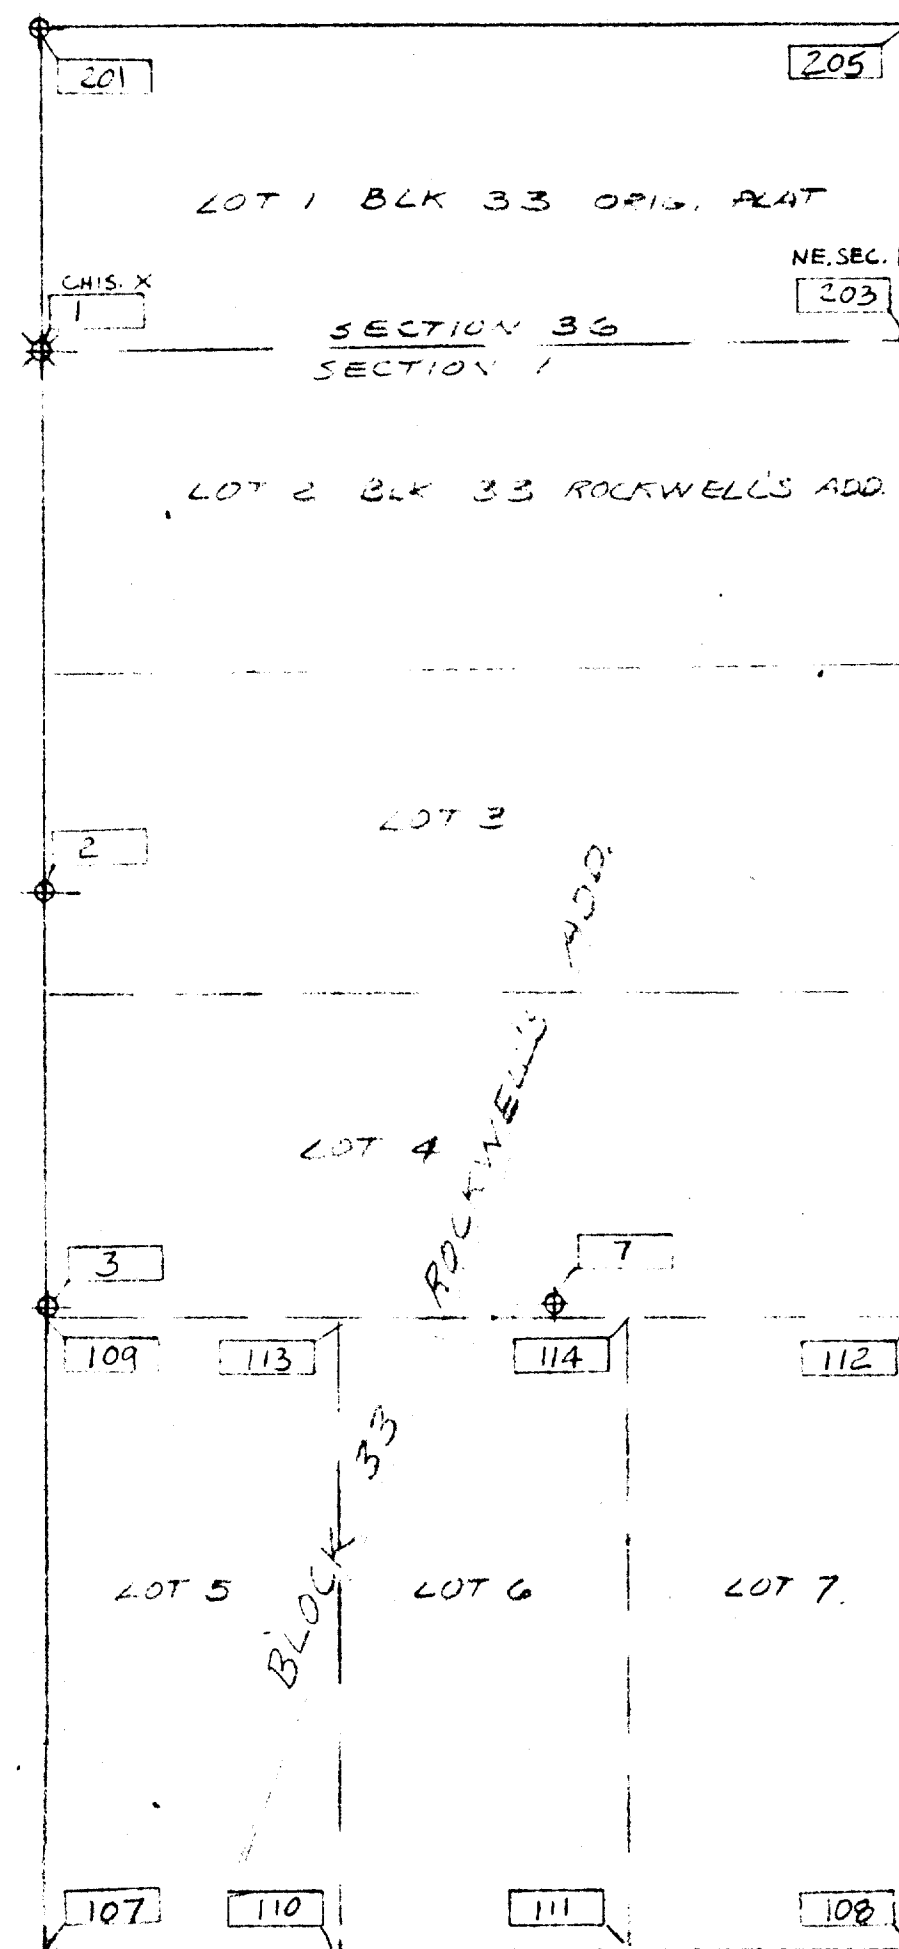

ROCKWELL STREET

PROJECT NO 3362 DATED JUNE 20 1990  
EAST LINE OF SOUTH WASHINGTON ST.  
106 TO 1 N 0° 0' 0" E 481.85 FT  
106 TO 107 N 0° 0' 0" E 66 FT  
107 TO 109 N 0° 0' 0" E 166.34 FT  
109 TO 1 N 0° 0' 1" E 249.52 FT  
BLOCK 33 OF ROCKWELL'S ADD  
107 TO 1 N 0° 0' 0" E 415.85 FT  
1 TO 203 N 89° 48' 0" E 225.94 FT  
203 TO 108 S 0° 0' 47" E 417.34 FT  
108 TO 107 N 89° 49' 23" W 225.98 FT  
AREA 94120.6408 - BF 2.16070986 ACRES  
LOTS 5 - 7 OF BLOCK 33 OF ROCKWELL'S ADD  
107 TO 109 N 0° 0' 0" E 166.34 FT  
109 TO 112 S 89° 58' 31" E 225.94 FT  
112 TO 108 S 0° 0' 47" E 166.94 FT  
108 TO 107 N 89° 49' 23" W 225.98 FT  
AREA 37682.4884 - BF .84438894 ACRES


WASHINGTON STREET  
66 FT WIDE PUBLIC STREET

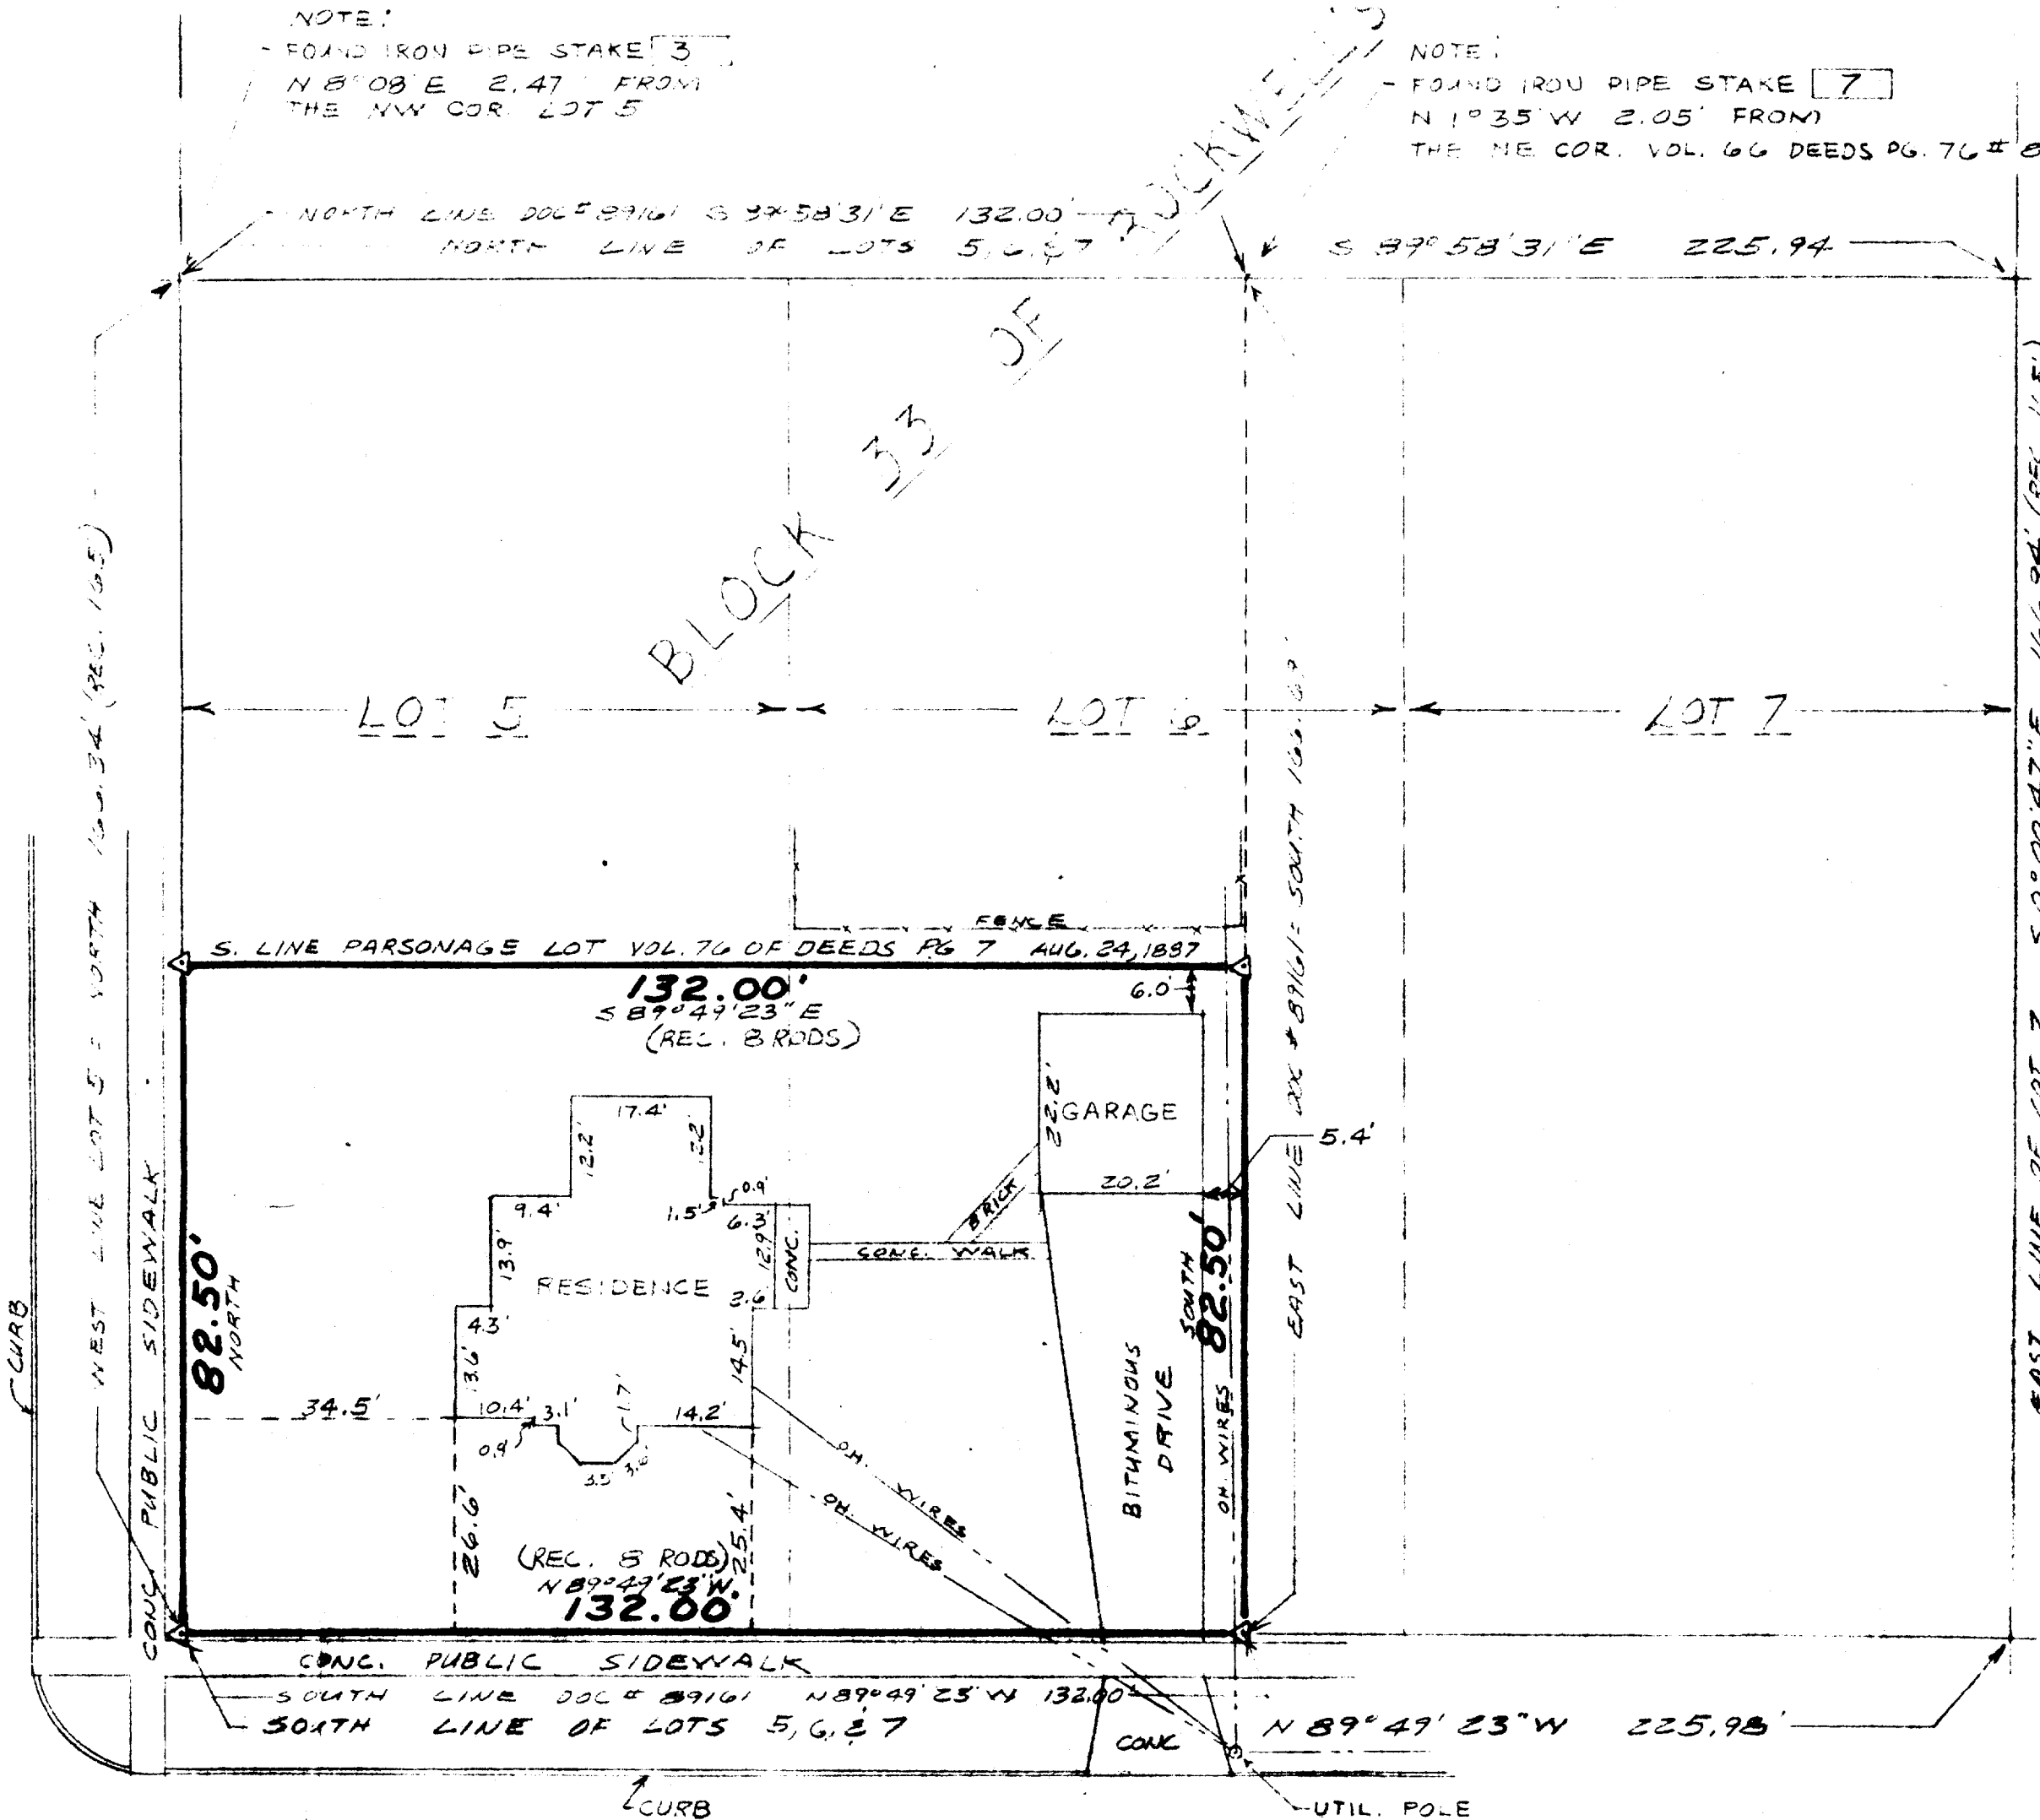

ROCKWELL STREET 66 FT WIDE PUBLIC STREET


The land referred to in Part of Survey is described as follows:  
Commencing at the southwest corner of Block 33 in Rockwell's Addition to the Village of Elkhorn, now City of Elkhorn, Walworth County, Wisconsin; thence North on the West line of said Block, 1/2 foot to the southwest corner of a piece of land known as the parsonage lot of the Congregational Church and Society of Elkhorn, Wisconsin; thence East in the South line of said parsonage lot, 8 rods; thence South 82 1/2 feet to the South line of said Block; thence West on said South line to the place of beginning.

Tax Map Number: TRW 00076

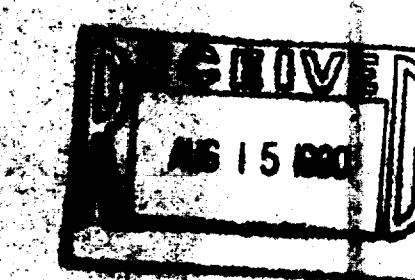

NOTES: COPIES OF THIS MAP, WITH THE FOLLOWING CERTIFICATE WILL APPLY ARE BLUE LINE PRINTS SHOWING SURVEY DATA AND SIGNATURES IN BLACK INK. COPIES BY ANY OTHER MEANS MAY HAVE AN ERROR WHICH DO NOT REPRESENT THE SURVEYOR'S WORK PRODUCT.  
I hereby certify that the above described property has been surveyed under my direction and that the above map is a true and correct representation of the same. The location of all visible structures and boundaries of all parcels shown thereon, boundary values, apparent easements, roadways and other features shown thereon are for the purpose of this survey only and do not constitute a warranty or guarantee of title or interest in the property, and the person who purchased, conveyed, or guaranteed the title should obtain and read the title records.

DATED: JUNE 20 1990

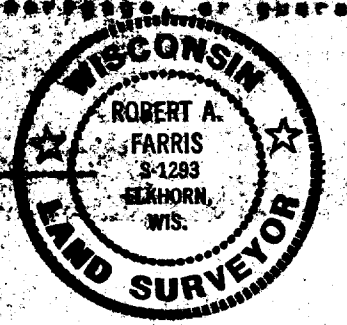

PROJ. NO. 3362

Tax Map YRW-76

4-598