
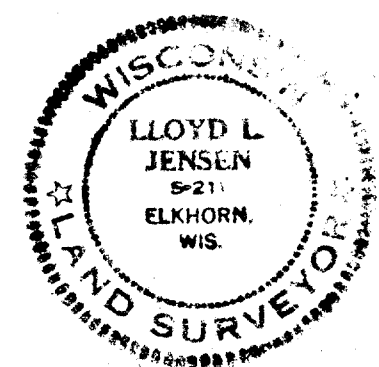


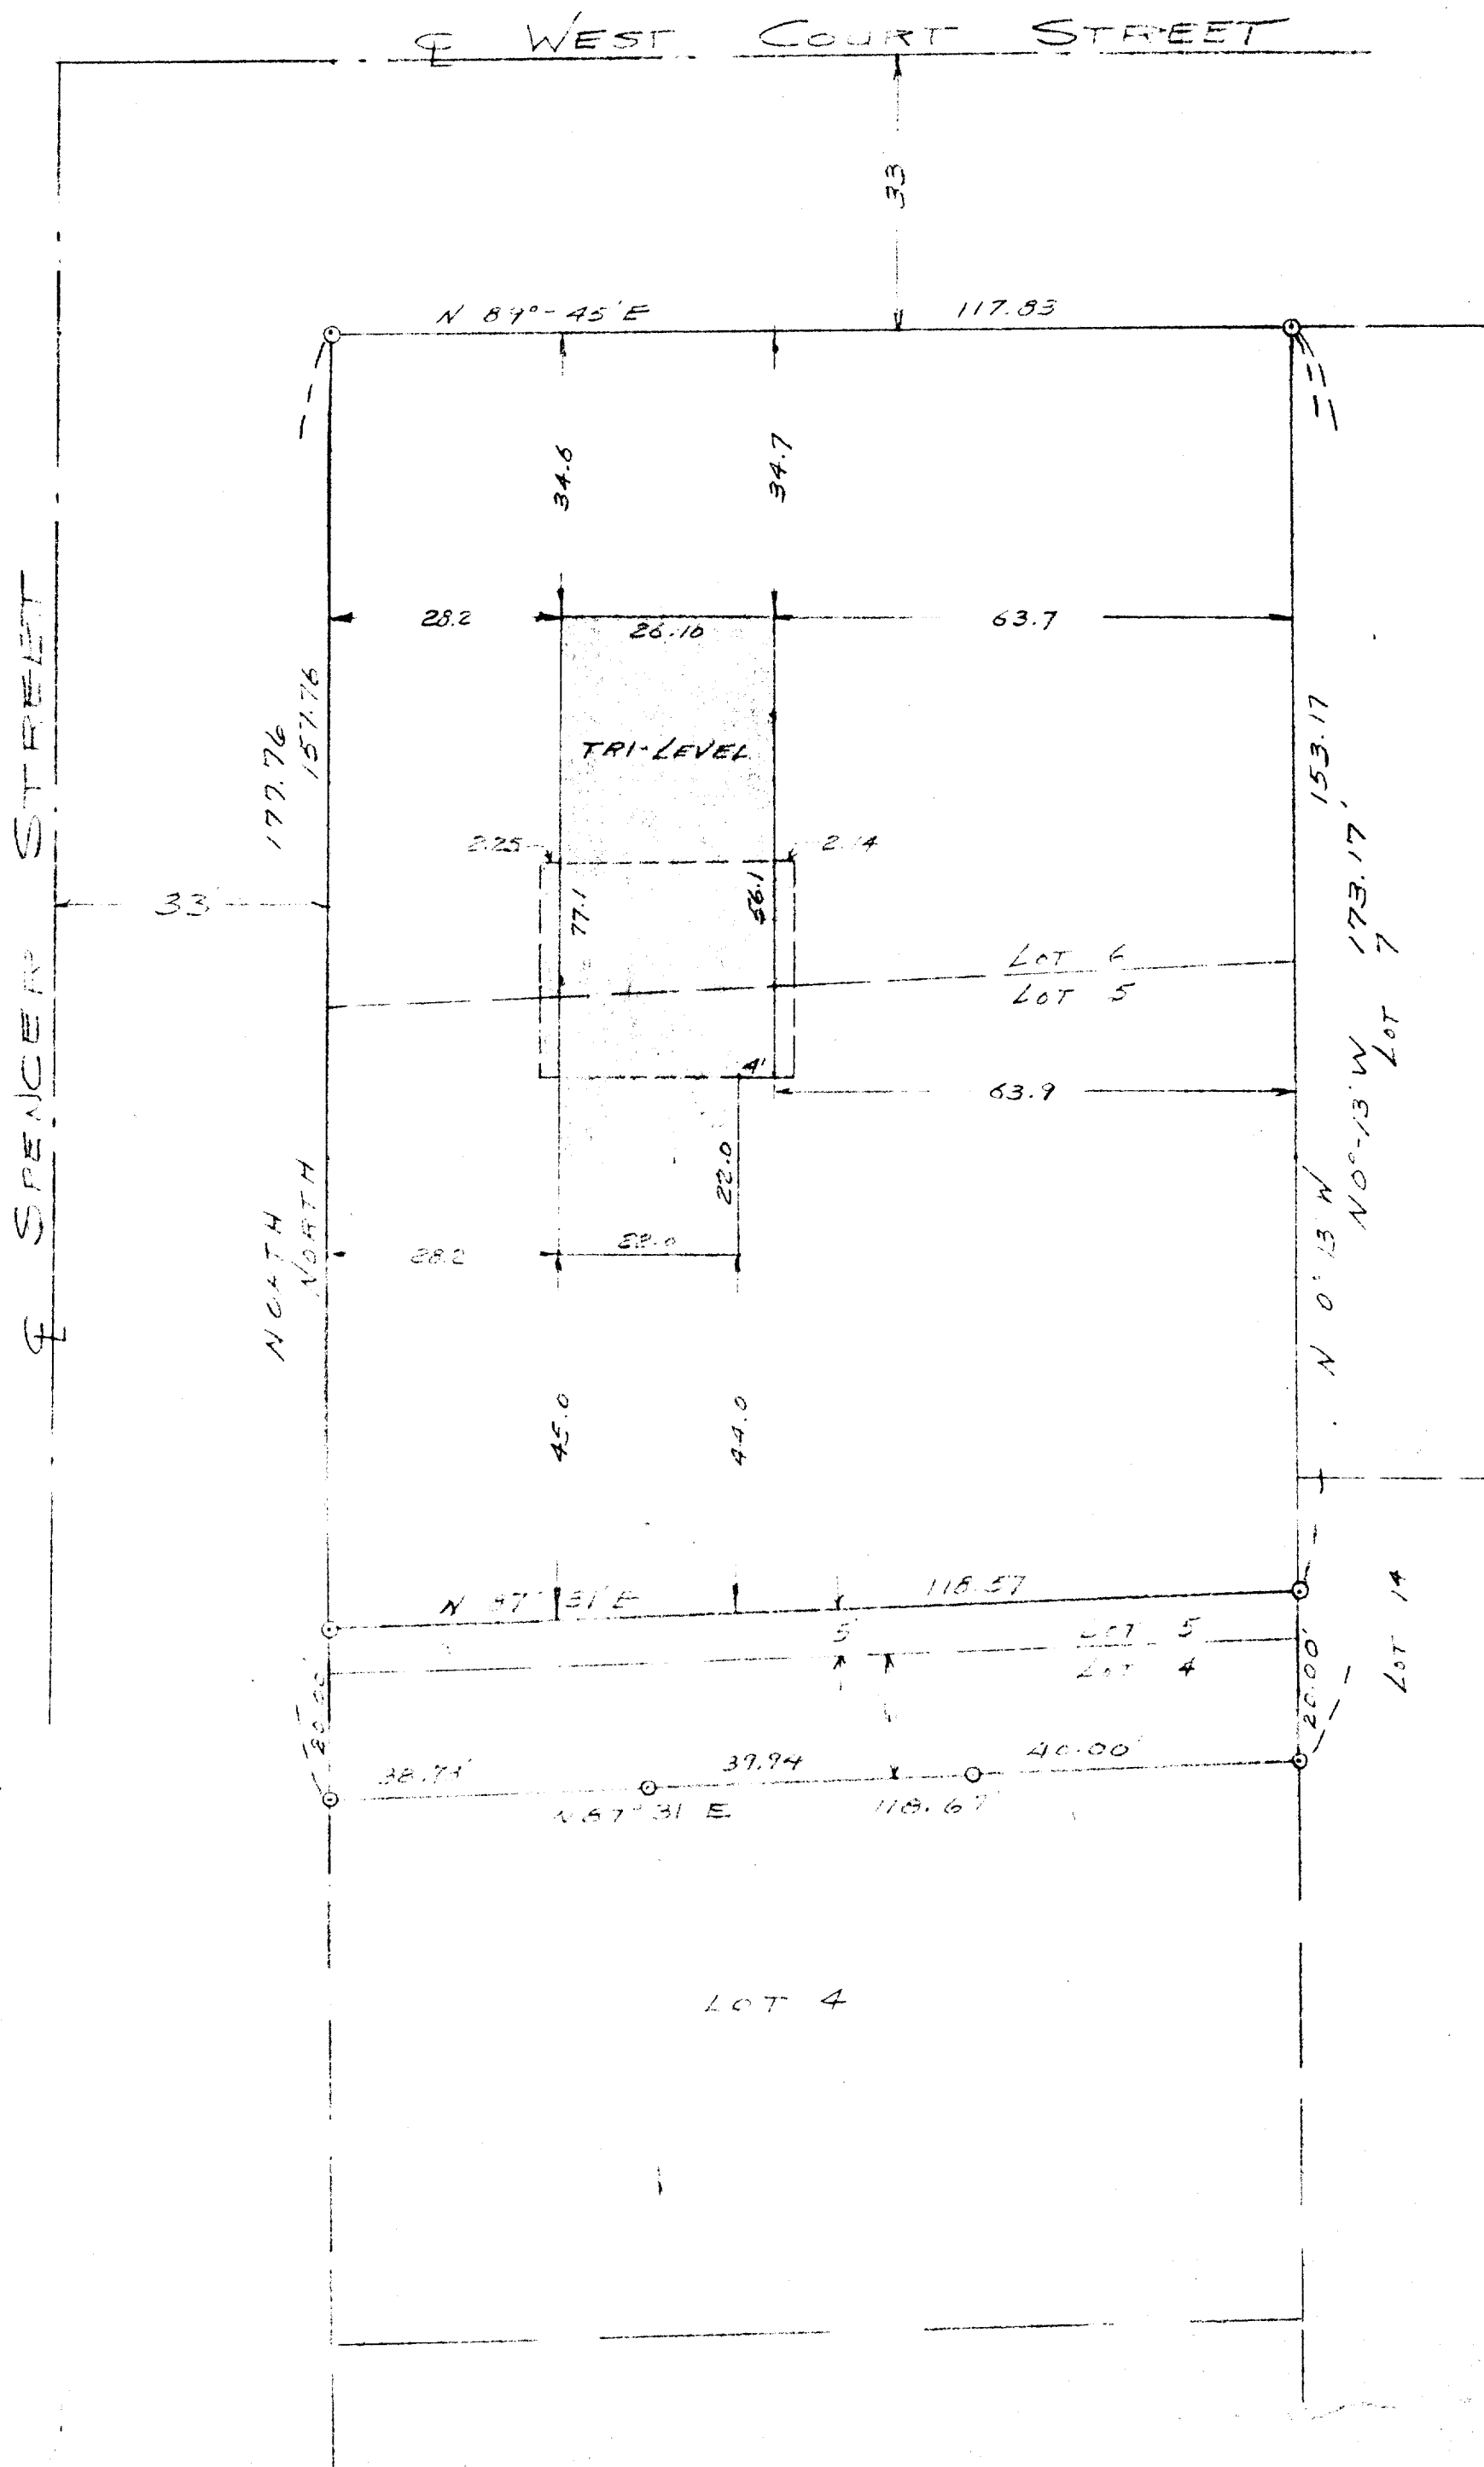

PLAT OF SURVEY OF

LOT 6 AND LOT 5 (EXCEPT THE SOUTH 5 FT)
OAKLAND SUBDIVISION, SECTION 36, T3N, R16E
CITY OF ELKHORN, WALWORTH COUNTY

Lloyd L. Jensen
SURVEYOR

SCALE - 2"

DATE APRIL 21, 1964
REVISED OCT 1965

4-59