


114ⁿ-69

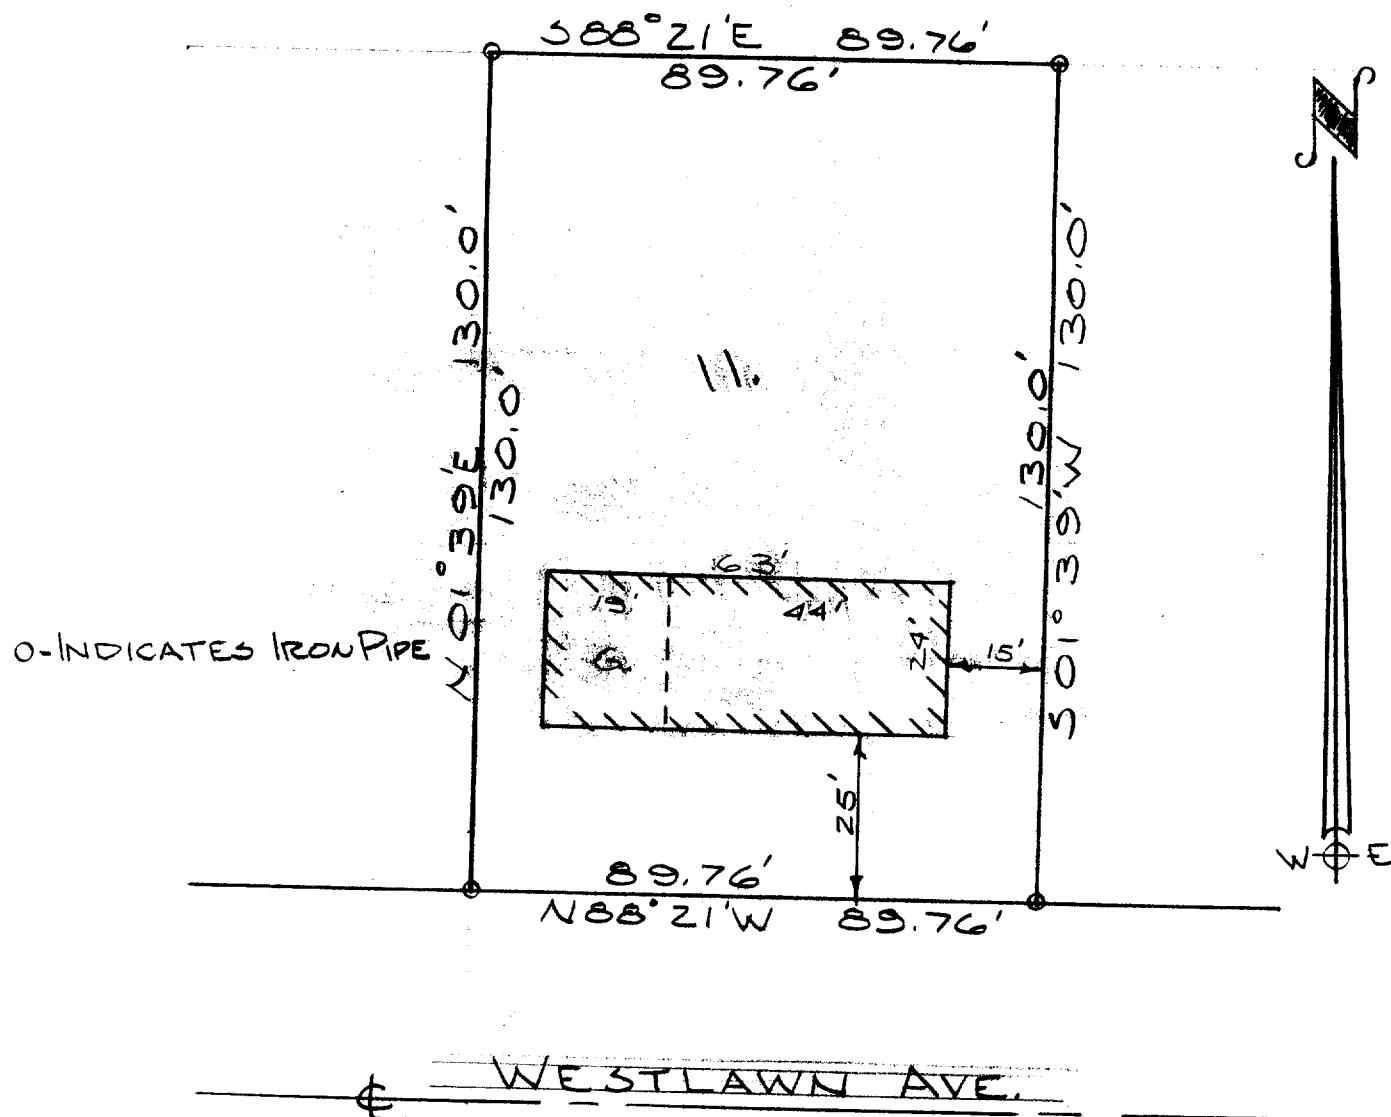

DESCRIPTION:

Lot 11 Block 3 Edgewood Second Addition in
the City of Elkhorn, Walworth County, Wisconsin.

CERTIFICATE: I, James F. Biagi, surveyor do hereby certify
that I have surveyed the property hereon described.

August 15th 1969.

James F. Biagi RLS 272
Elkhorn, Wisconsin.



YEA 2-3

4-5 B