


29



CERTIFICATE: I James F. Biagi, surveyor, do hereby certify that I have surveyed the property hereon described, and that the location of the improvements are as shown on the plat.

JAMES F. BIAGI (RLS 272)

~~SECRET~~ (S) (C) (U)

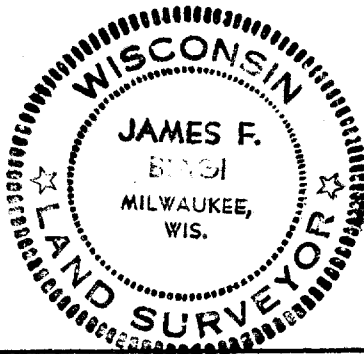

725

YJA2-24

4-5 B.