


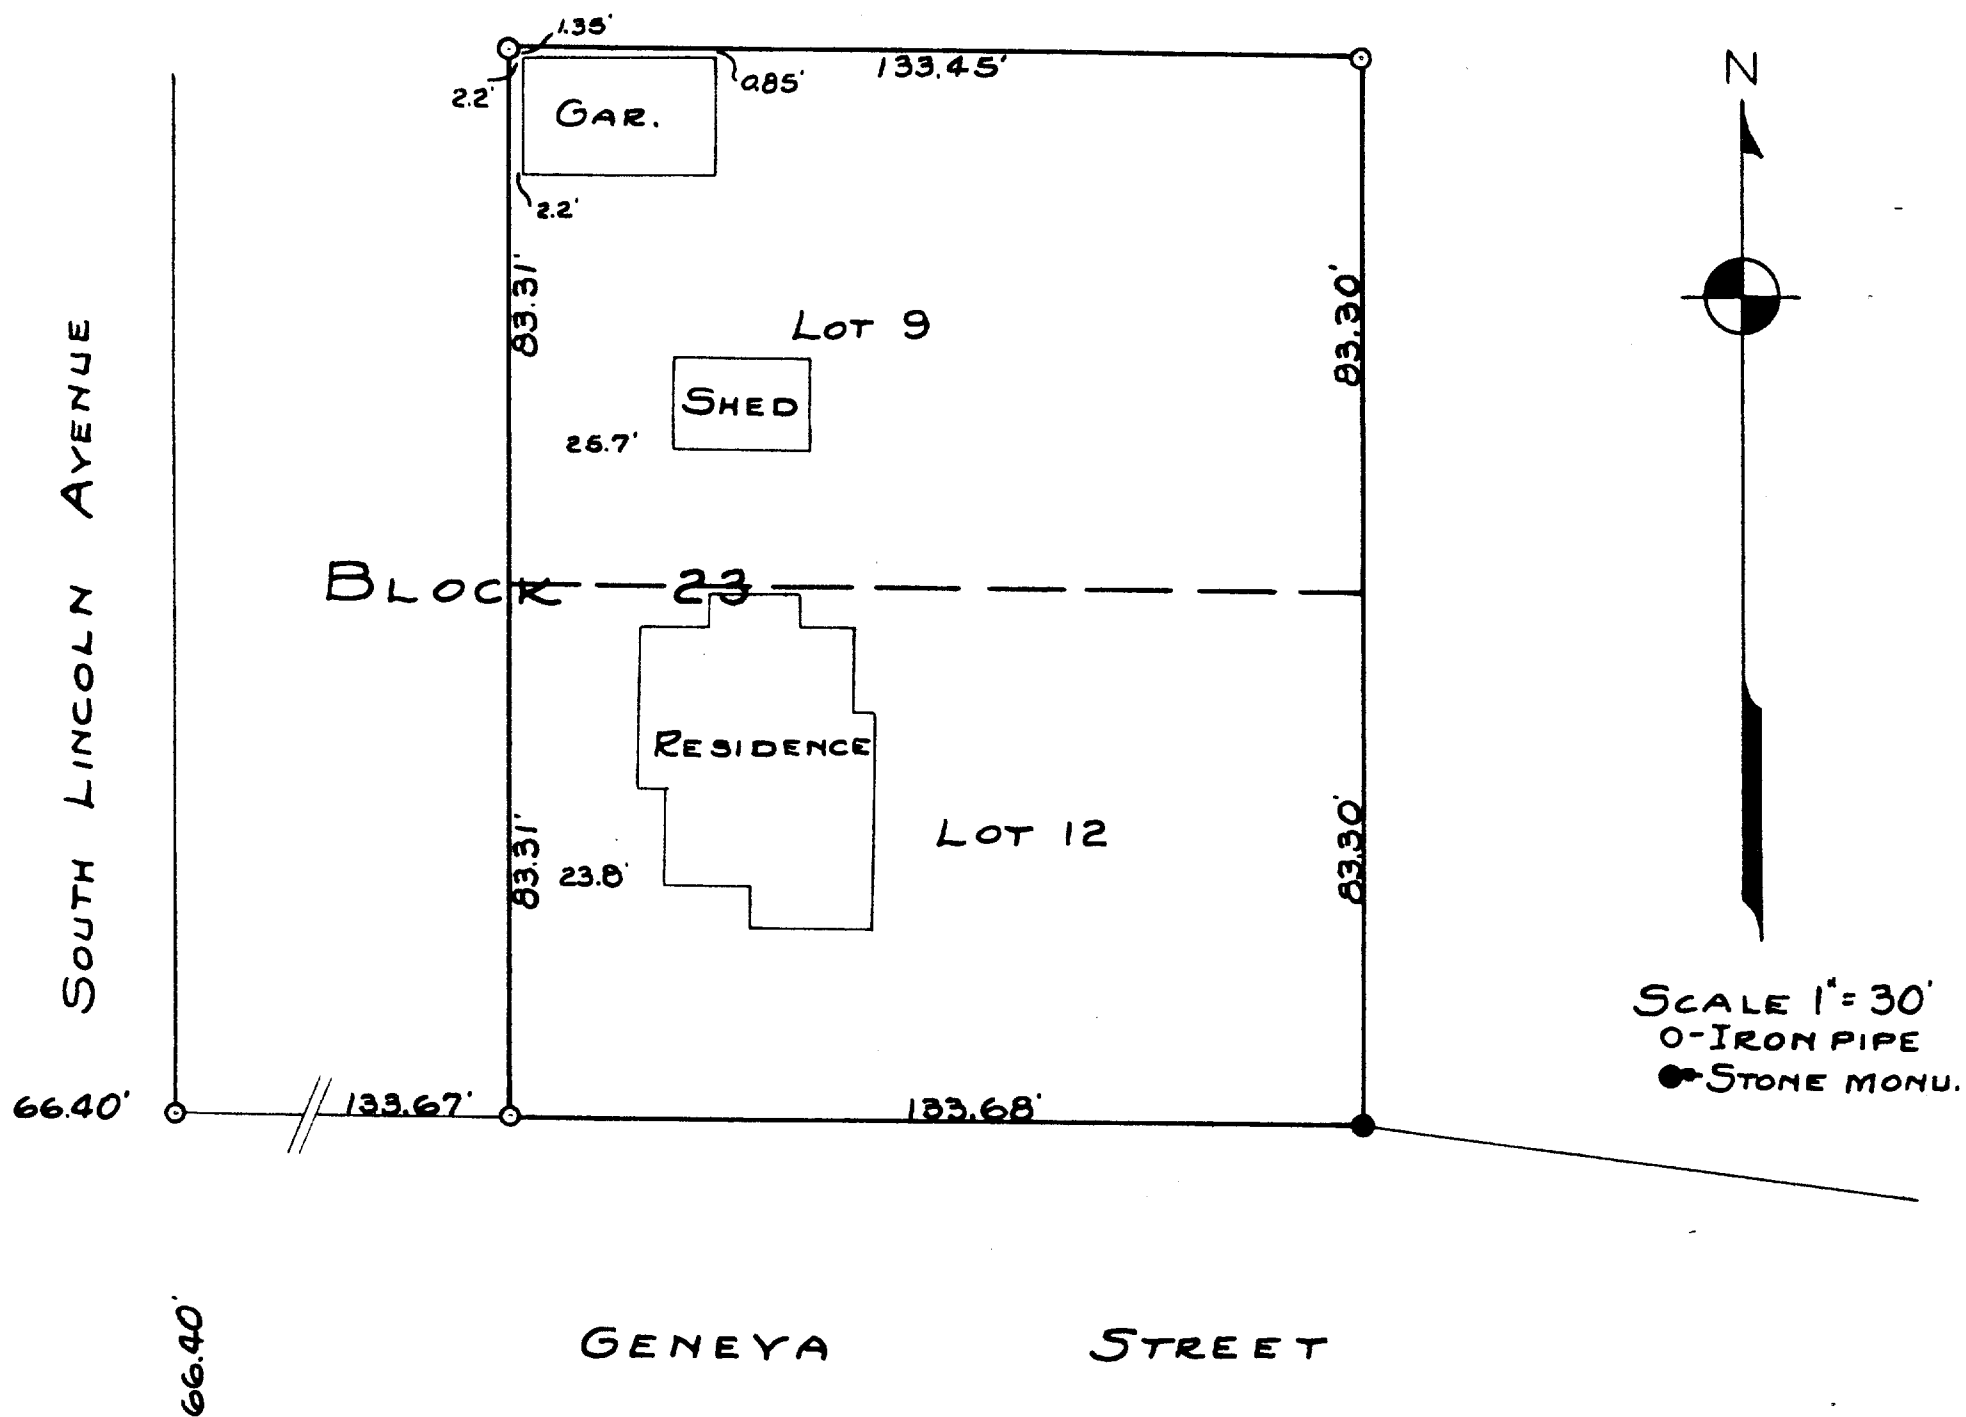

PLAT OF SURVEY OF LOTS 9 AND 12 OF
BLOCK 23 OF ROCKWELL'S ADDITION TO
THE CITY OF ELKHORN, WALWORTH COUNTY
WISCONSIN.

JUNE 1943

Lloyd P. Jensen
COUNTY SURVEYOR