


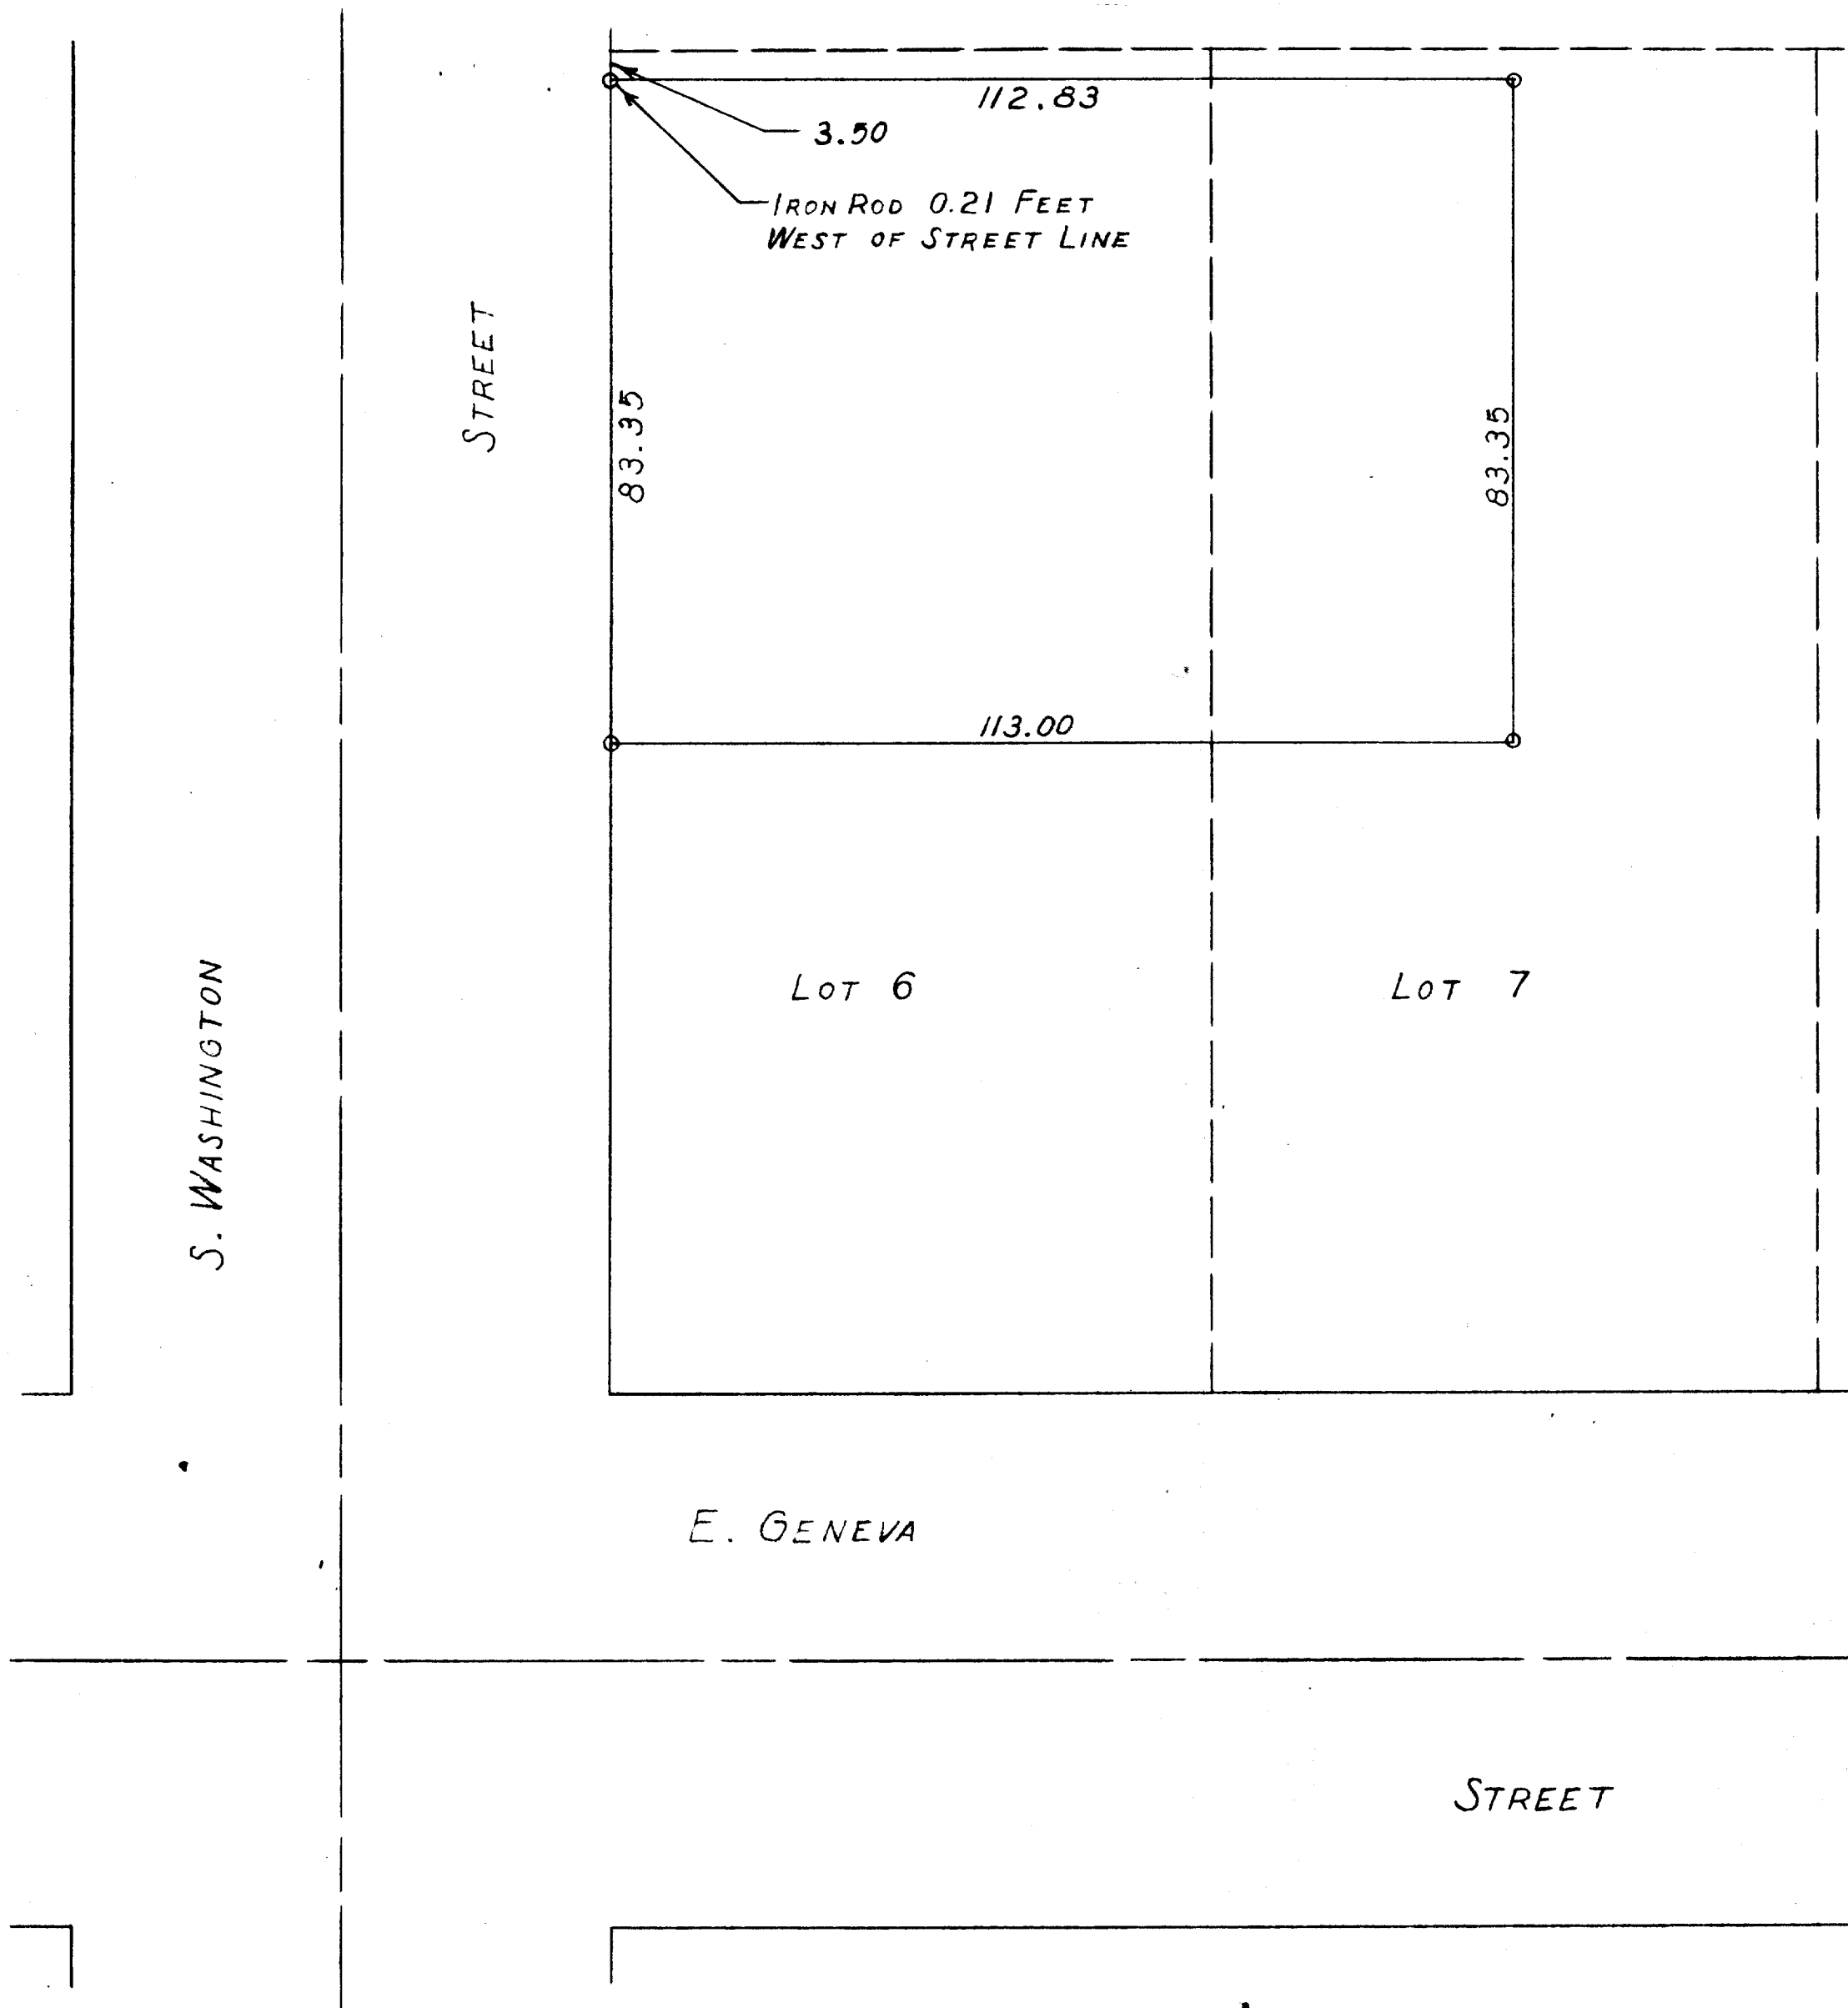

SCALE ~ 1" = 20'
O = IRON PIPE OR ROD

PLAT OF SURVEY OF PART OF LOTS 6 AND 7, BLOCK 24 OF THE ORIGINAL PLAT
OF THE CITY OF ELKHORN, WALWORTH COUNTY, WISCONSIN
MAY 3, 1956

George T. Dunham
GEORGE T. DUNHAM, SURVEYOR
DELAWARE, WISCONSIN

YOP/88

4-6