
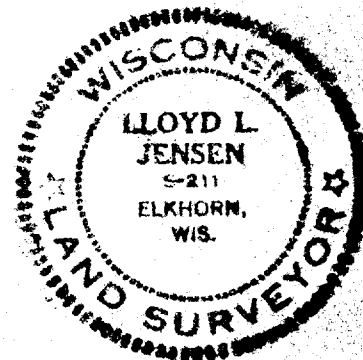


PLAT OF SURVEY

OF

LOT 10 BLOCK 5 EDGEWOOD
1ST ADDITION - NE 1/4 SECTION
36, T3N, R16E, CITY OF
ELKHORN WALWORTH COUNTY,
WISCONSIN.

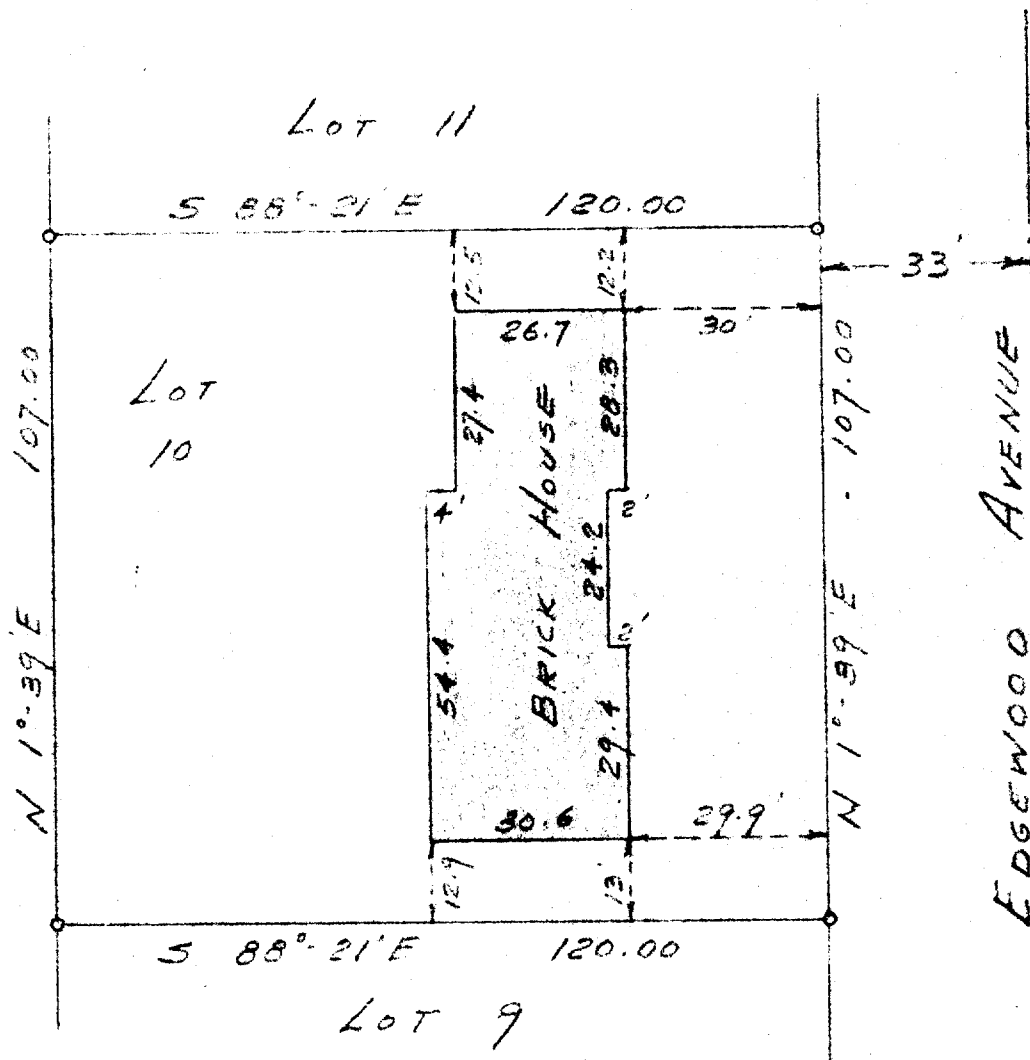

SURVEY AND PLAT BY
JENSEN & JOHNSON
CIVIL ENGINEERS AND SURVEYORS

Elkhorn, Wisconsin

LEGEND

- — Iron Pipe
 - — Concrete Monument
- Scale 1" = 30'

WE CERTIFY: That we have surveyed the above described property and that the plat shown hereon is an accurate survey and a true representation thereof and correctly shows the exterior boundary lines and all divisions of said property, and all buildings located thereon.

Date Nov. 5, 1964

Lloyd L. Jensen
LLOYD L. JENSEN, Partner

Wisconsin Registered Land Surveyor, No. S-211

YEA 1-25