



Revised

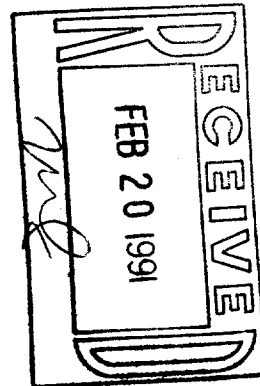

SURVEY ORDERED BY MODELW REALTY

RECORDED AS 60' WIDE
WISCONSIN STREET


D Cooper & CO., INC
Rt. 4 Box 508B * Elkhorn WI 53121

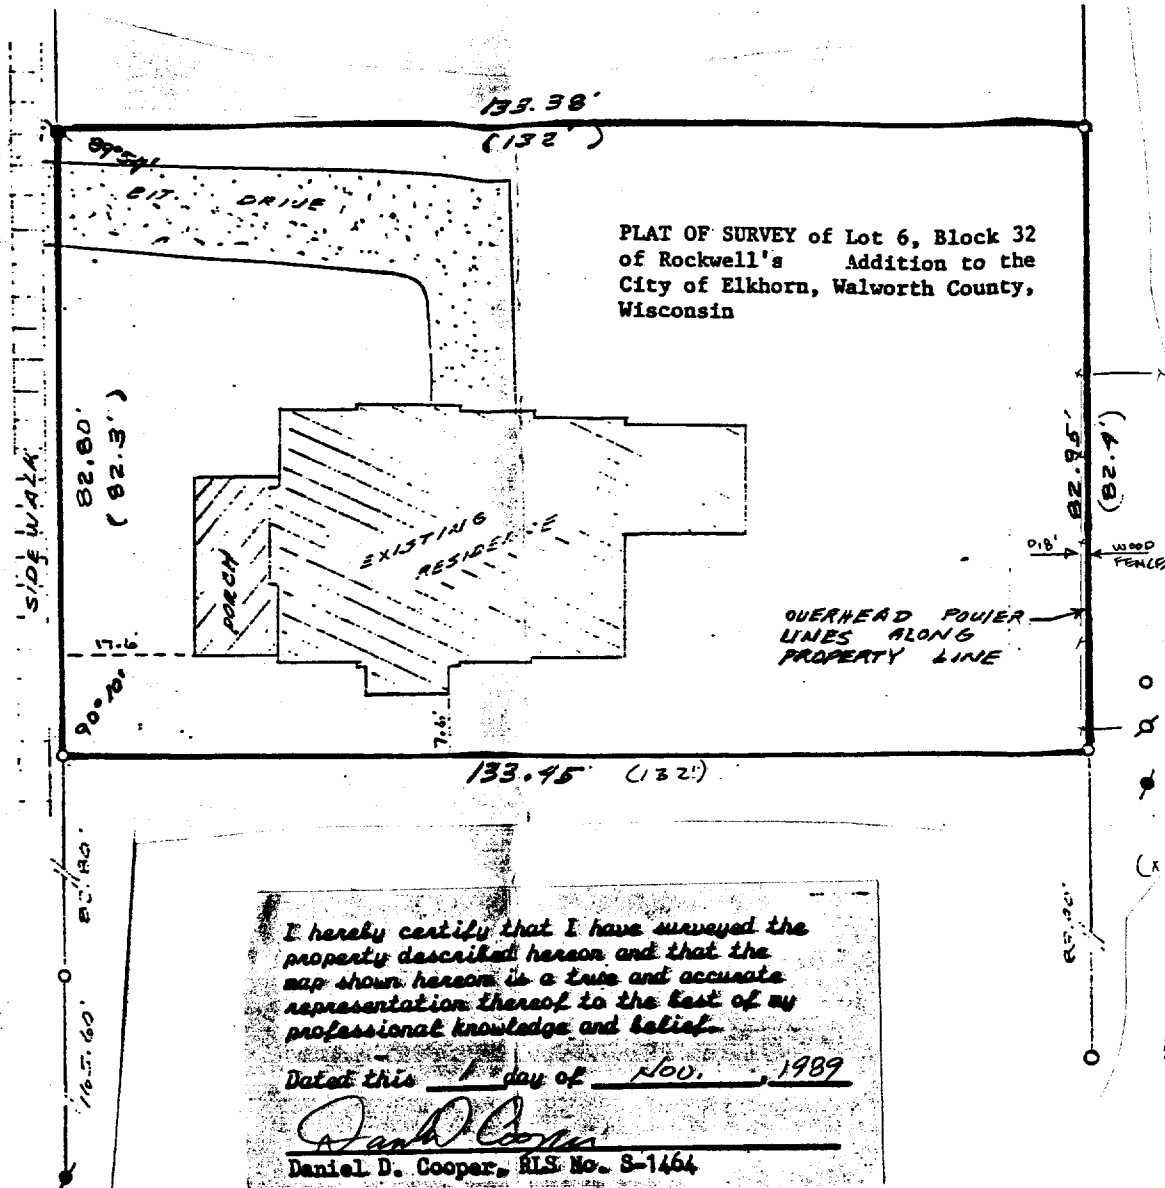

I hereby certify that I have surveyed the property described hereon and that the map shown hereon is a true and accurate representation thereof to the best of my professional knowledge and belief.

Dated this 1 day of Nov., 1989

Daniel D. Cooper, RLS No. S-1464

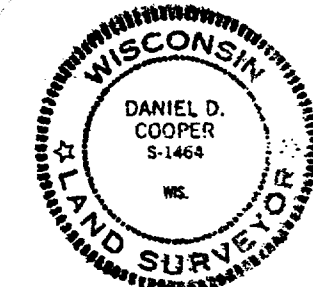

DRAWING NO. 3553

TAX KEY # YRW-60

4-612