



NORTH
 WISCONSIN STREET
 66.00 WIDE

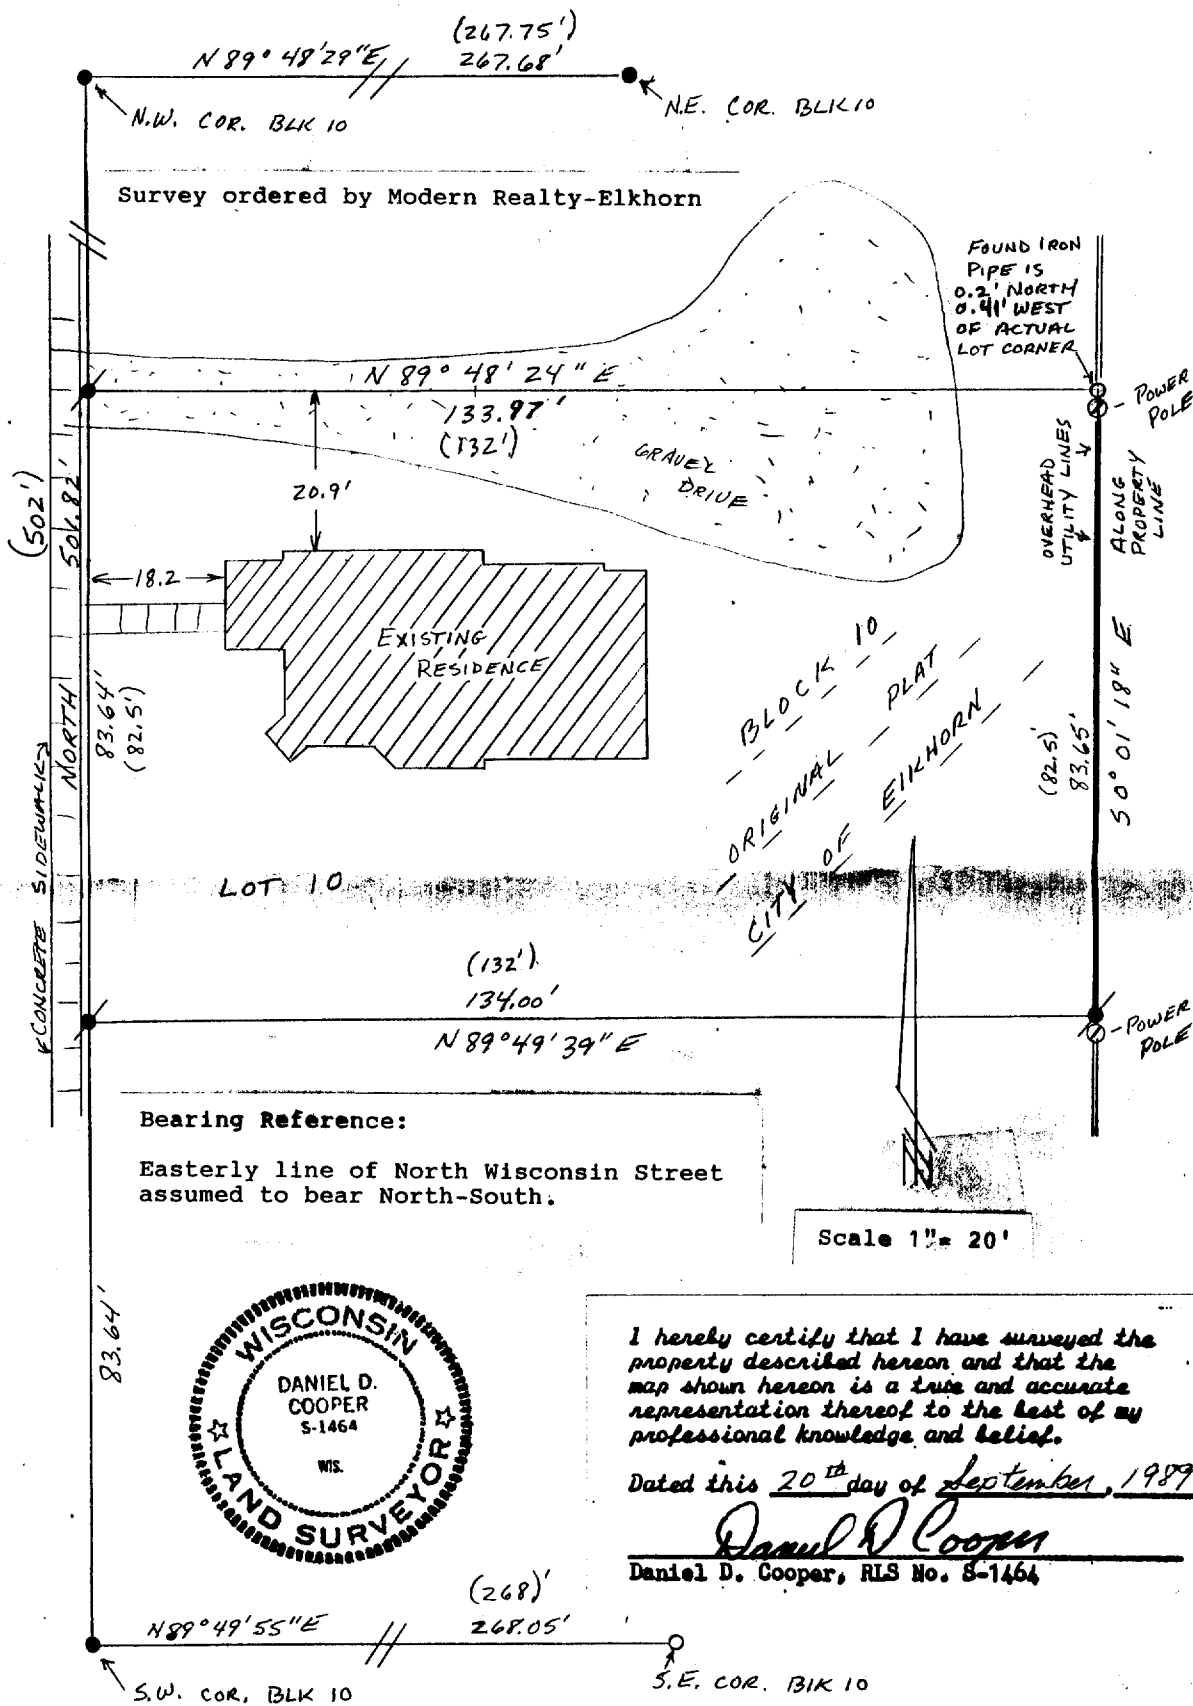

Reduced

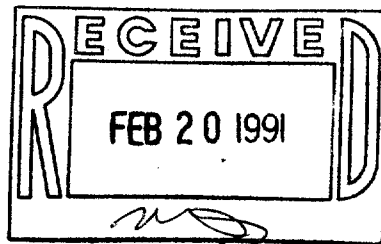

TAX KEY #

YOP 00060

4-613