


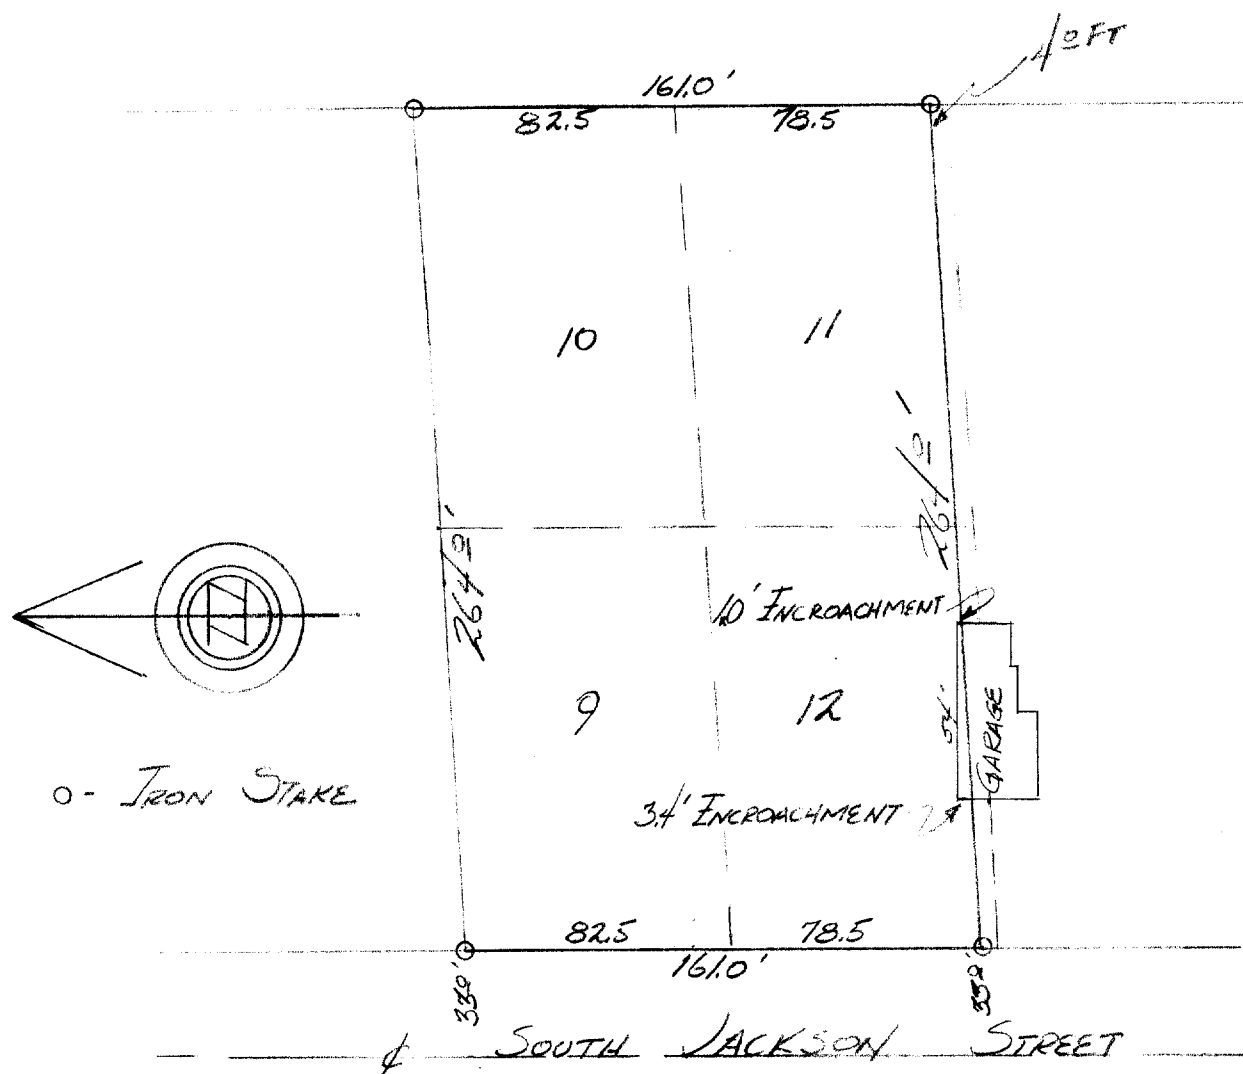

DESCRIPTION: All of Lots 9 and 10 and the North 78.50 feet of Lots 11 and 12 of Block 7, of Elderkins Addition to the City of Elkhorn, Walworth County, Wisconsin.

CERTIFICATE: I, hereby certify, that I have on this the 8th day of September 1958, surveyed the above described property according to the official records on file in the Register of Deeds office, and that the measurements and bearings of the boundary lines are in accordance with the above drawing, and the above shown encroachment exists as shown.

SIGNED AND SEALED ON THIS 9TH DAY OF SEPTEMBER 1958



James F. Biagi
Land Surveyor (272)