


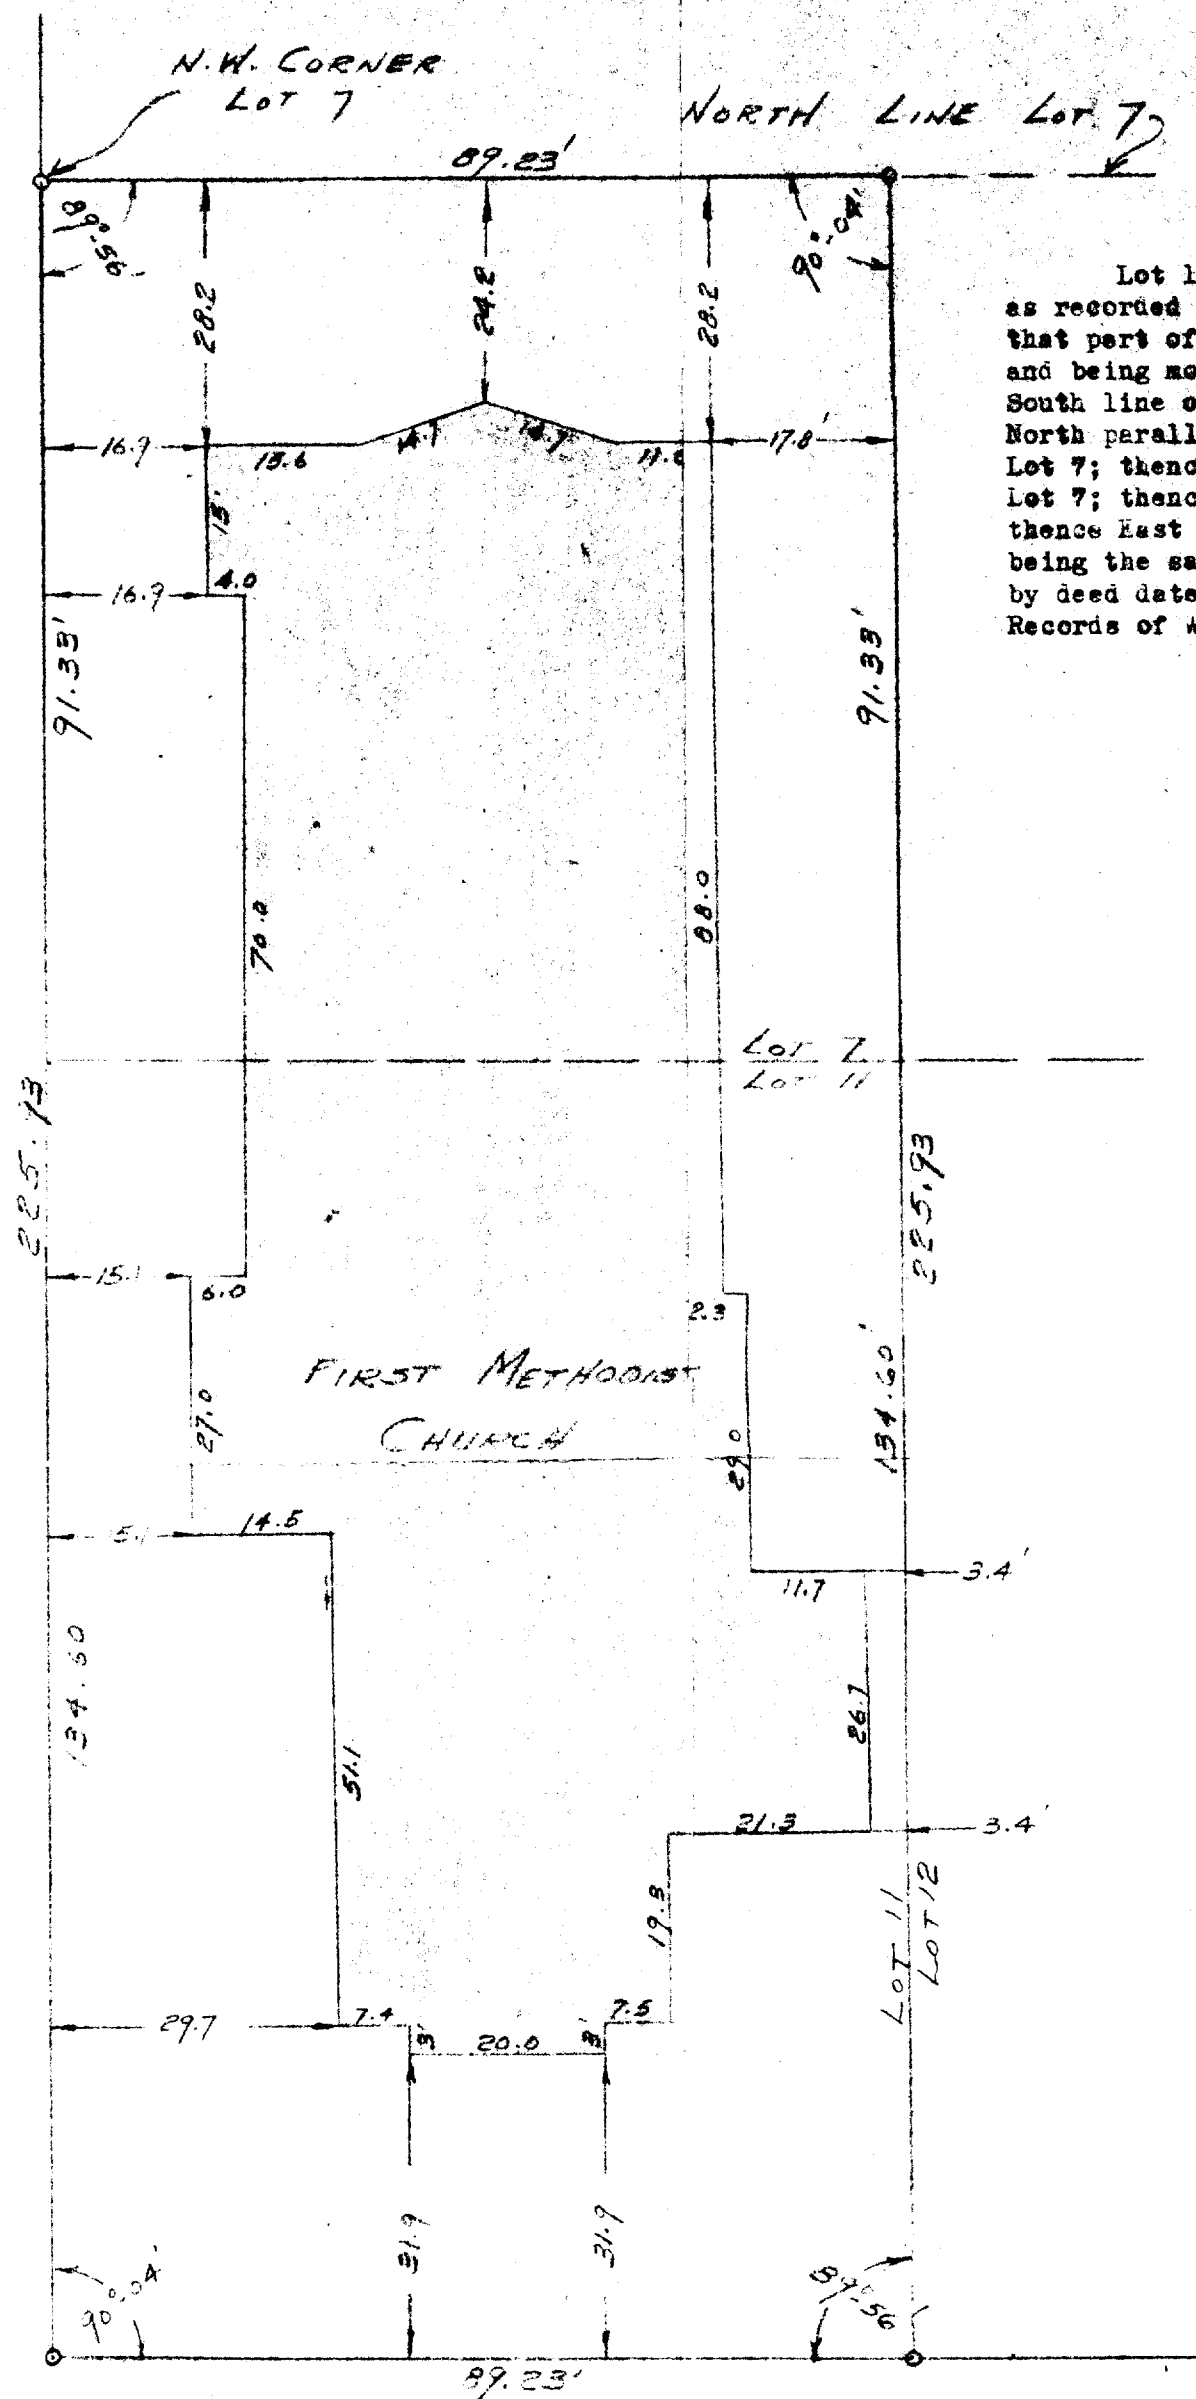

DESCRIPTION OF LAND


Lot 11 in Block 16 of the Original Plat of the Village of Elkhorn, as recorded in the office of the Register of Deeds for said County, and also that part of Lot 7 in said Block lying North of and adjoining said Lot 11 and being more particularly described as follows, to-wit: Commencing in the South line of said Lot 7 at the Northeast corner of said Lot 11; thence North parallel with the West line of said Block to the North line of said Lot 7; thence West in the North line of said Lot 7 to the NW corner of said Lot 7; thence South in the West line of said Lot 7 to the SW corner thereof; thence East in the South line of said Lot 7 to the place of beginning, and being the same lands conveyed to party of the first part by Adeline Davis by deed dated May 21, 1881 and recorded in Vol. 65 of Deeds on page 137, Records of Walworth County, Wisconsin.

CERTIFICATE

I hereby certify that on the 20th day of October, 1964, that I have surveyed the above described property and that the plat hereon is a correct representation of the exterior boundary lines thereof, and the principal lines of all buildings located thereon.

George B. Wilson
George B. Wilson

○ - IRON STAKE

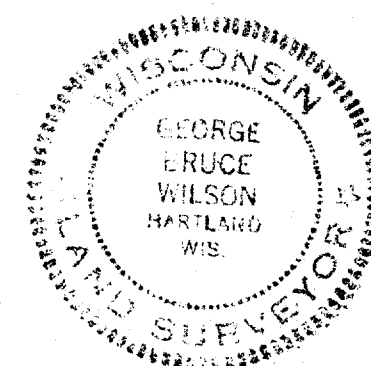

PLAT OF SURVEY OF

LOT 11 AND THE WEST 89.23'
OF LOT 7, BLOCK 16, ORIGINAL
PLAT, CITY OF ELKHORN,
WALWORTH COUNTY,
WISCONSIN.

George B. Wilson
SURVEYOR

SCALE 1" = 20'

DATE OCT. 20, 1964