


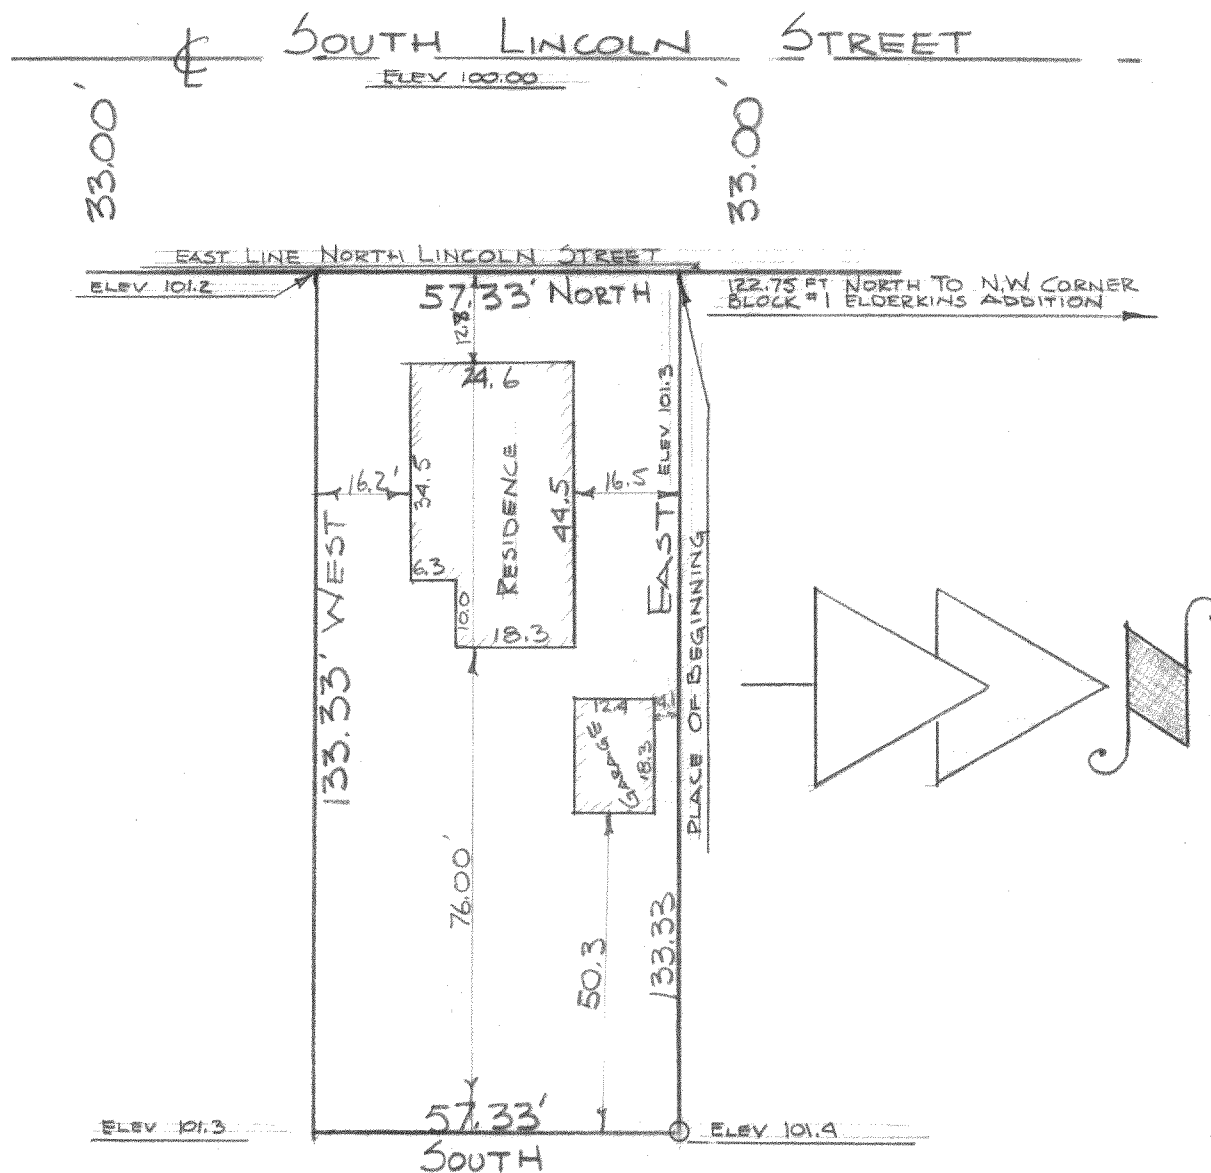

DESCRIPTION: Beginning at a point that is 122.75 feet South of the N.W. corner of Block #1 of Elderkins Addition to the City of Elkhorn, Wisconsin, thence East 133.33 feet to a point, thence South 57.33 feet to a point, thence West 133.33 feet to a point, thence North 57.33 feet to the place of beginning.

CERTIFICATE: I, James F. Biagi, surveyor, do hereby certify that I have surveyed the property hereon described, and that the location of all the improvements are as shown of the above plat.

Dated May 27, 1961.

SEAL

James F. Biagi RLS 272