

Plat of Survey

of

Lots 10, 13, 14, 17 and 18, Block 3 of Elkhorn Gardens located in Section 1
T.2 N., R.16 E., City of Elkhorn, Walworth County, Wisconsin.




Surveyed for: Susan Davis
219 Lewis
Elkhorn, WI 53121

Bearings are referenced to the recorded
subdivision plat.

MANHOLE/CATCH BASIN INFORMATION

M.U.	DIR.	RIM	I.F.
1	S	1028.42	1021.98
2	S	1028.70	1023.20
3	N-S	1026.50	1019.91
4	N-S	"	1020.34
	N-S	1027.13	1019.26
C.B.			
1	S	1026.01	1021.09
	N	"	1021.26
	N	"	1021.48
2	N	1026.42	1022.32
3	N	"	1022.82
4	N	1025.96	1023.51
	N	1026.17	1019.02

NOTE: CURB ELEVATIONS ARE
TAKEN AT TOP OF CURB
UNLESS NOTED.

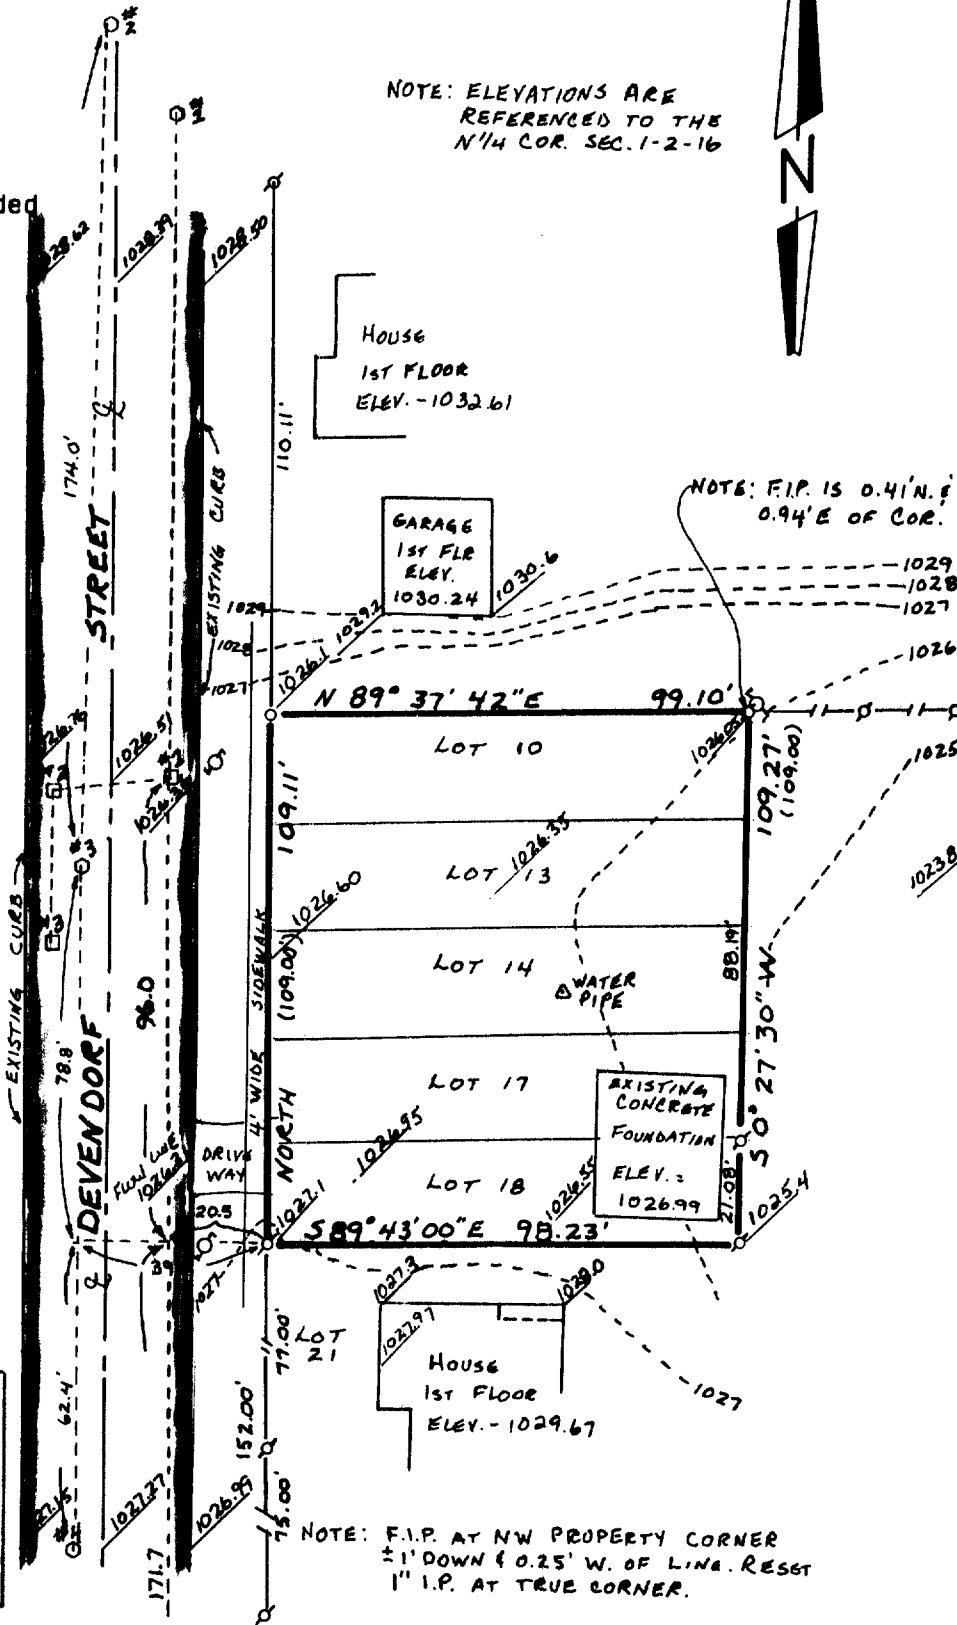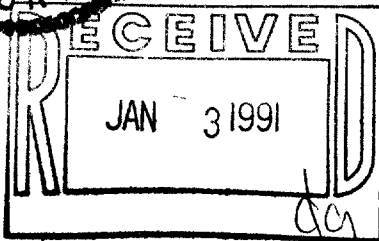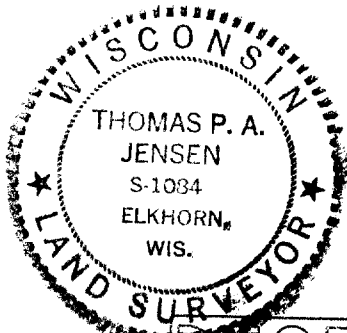

Copyright © 1990 by Jensen Surveying & Mapping S.C.
All rights reserved. No part of this survey plat may be reproduced or transmitted in any form
by any means - graphic, electronic, or mechanical, including photocopying, tracing, or infor-
mation storage and retrieval systems - without permission in writing from Thomas P.A. Jensen.

I, Thomas P.A. Jensen, Wisconsin Registered Land Surveyor, do hereby certify that this
survey was performed by me, or under my direction, in full compliance with the owner's/agent's
instructions and Chapter A-E 7 of the Wisconsin Administrative Code 'Minimum Standards For
Property Surveys', and that this map is an accurate representation thereof to the best of my
knowledge and belief.

Note: This survey plat is not
certified unless signed
and sealed in red ink.

Thomas P.A. Jensen
Thomas P.A. Jensen R.L.S. 1084

Legend

- ⊕ ~ Found iron pipe
- ~ Set iron pipe
- () ~ Recorded as dimension
- ~ Spot elevation
- ⊕ ~ Utility pole
- ~ Manhole
- ~ Catch basin

Jensen Surveying & Mapping S.C.

45 South Wisconsin Street P.O. Box 322
Elkhorn, Wisconsin. 53121.
(414) 723-3434

Mapping date: 7/12/90.

Revisions: _____

Sheet 1 of 1 Sheets

Job reference number:

1990.100

Scale: 1" = 40'

