




WEST

GENEVA

STREET

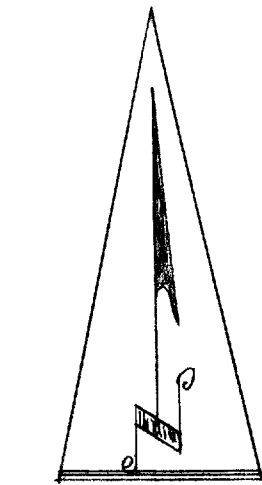

NORTH
o Iron Pipe.

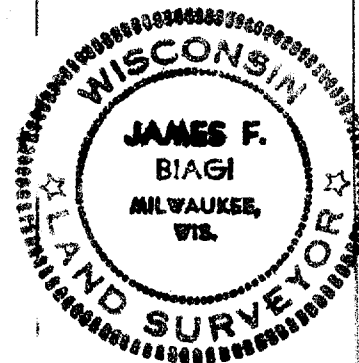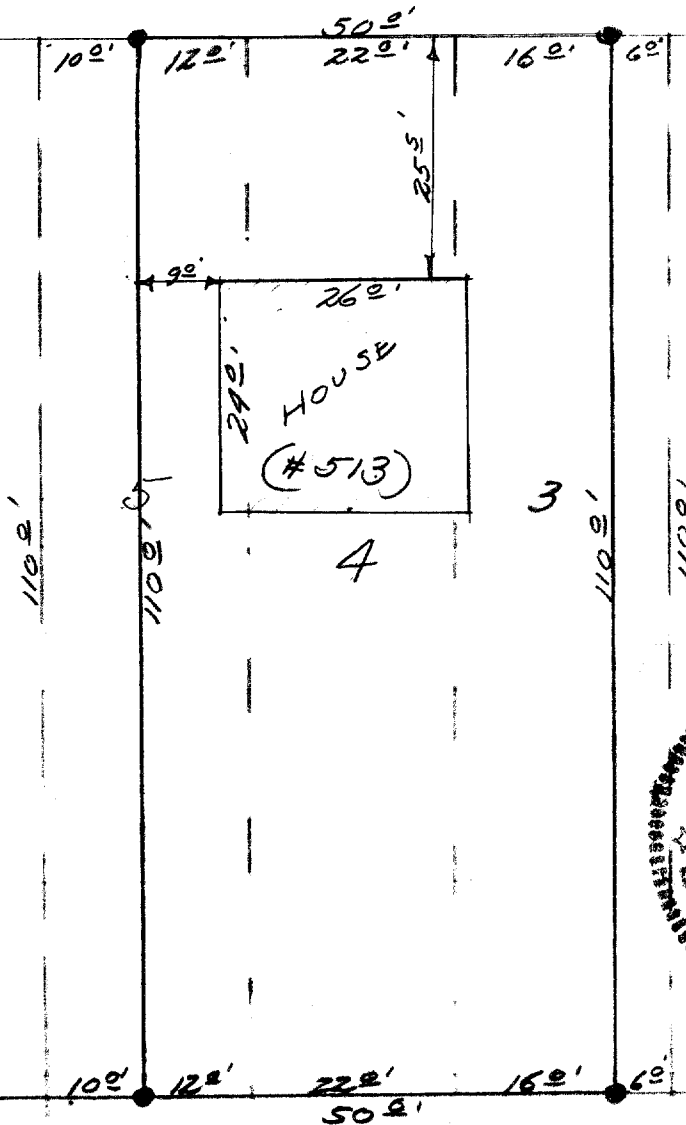

DESCRIPTION: Lot 4, and West 16 feet of Lot 3, and East 12 feet Lot 5 Block 3 of Elkhorn Gardens as per plat of same as recorded in Volume U² plats page 75 Walworth County Records in the City of Elkhorn, Walworth County Wisconsin.

CERTIFICATE: I, hereby certify that I have surveyed the above mentioned property and that the hereon portrayed is an accurate survey and a true representation thereof and correctly shows the exterior boundary lines and the location of buildings and other improvements thereof.

Dated October 26th 1965.

James F. Biagi RLS 272
Elkhorn, Wisconsin.

4-65B