


ABELL SURVEYING & MAPPING

DELAVER, WISCONSIN 53115

414-728-6737

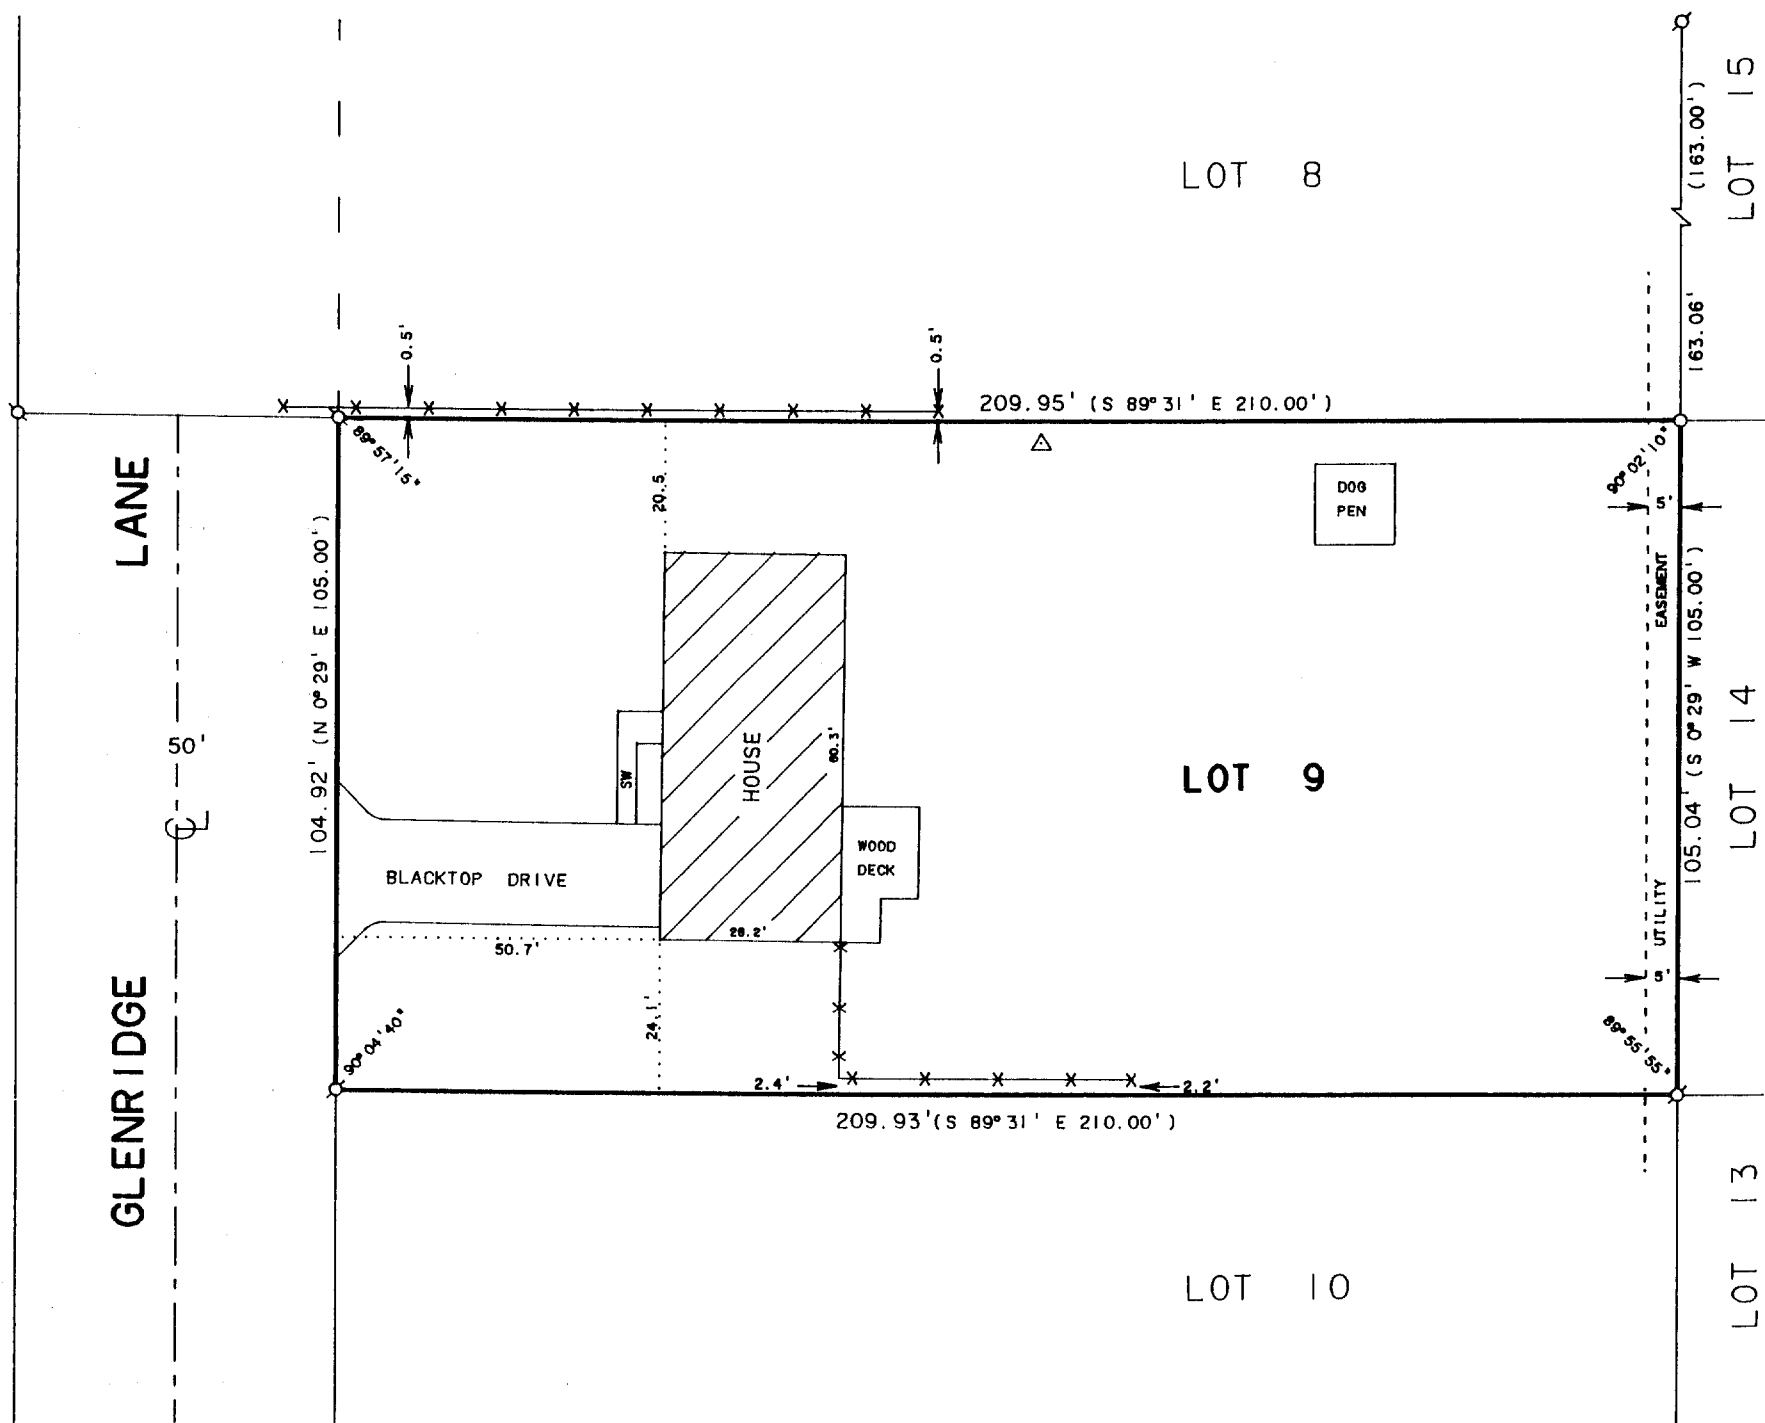

PLAT OF SURVEY OF


LOT 9, GREEN ACRES SUBDIVISION, CITY OF ELKHORN,
WALWORTH COUNTY, WISCONSIN.



SCALE 1" = 30'

LEGEND

- Q-2" DIA. IRON PIPE FOUND
- Q-1" DIA. IRON PIPE FOUND
- O-IRON PIPE SET
- △-UTILITY POLE
- SW-SIDEWALK
- X-WOOD FENCE
- ()-RECORDED AS

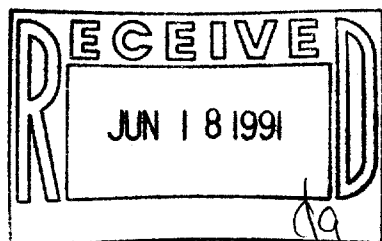

ORDERED BY: MIDWEST REAL ESTATE
P.O. BOX 1080
WILLIAMS BAY, WI. 53191

I HEREBY CERTIFY THAT I HAVE SURVEYED THE ABOVE DESCRIBED PROPERTY AND THAT THE ABOVE MAP IS A TRUE REPRESENTATION THEREOF AND SHOWS THE SIZE AND LOCATION OF THE PROPERTY, ITS EXTERIOR BOUNDARIES, THE LOCATION OF ALL VISIBLE STRUCTURES AND DIMENSIONS OF ALL PRINCIPAL BUILDINGS THEREON, BOUNDARY FENCES, APPARENT EASEMENTS, ROADWAYS AND VISIBLE ENCROACHMENTS, IF ANY, TO THE BEST OF MY KNOWLEDGE AND BELIEF.

THIS SURVEY IS MADE FOR THE USE OF THE PRESENT OWNERS OF THE PROPERTY, AND ALSO THOSE WHO PURCHASE, MORTGAGE, OR GUARANTEE THE TITLE THERETO WITHIN ONE (1) YEAR FROM DATE HEREOF.

David F. Abell

DAVID F. ABELL
WISCONSIN REGISTERED LAND SURVEYOR, S-1596

March 5, 1991

DATE JOB NUMBER - 91034

NOTE: THIS IS NOT A CERTIFIED COPY UNLESS SEALED.

004-6666

YGR 00009