

ABERNATHY and ASSOCIATES
Kenneth B. Abernathy Jr.
Wisconsin Registered Land Surveyor S-1594

Rt. 3, Box 273
Elkhorn, Wisconsin 53121
Phone: (414) 723-8260 (office)
(414) 723-8813 (residence)

PLAT OF SURVEY


LEGAL DESCRIPTION
Lot 5 of Harmony Acres Subdivision,
Located in the Northwest 1/4 of
Section 6, Town 2 North, Range 17
East, City of Elkhorn, County of
Walworth, State of Wisconsin.

Owners: Brian & Marilyn Neal
426 Harmony Lane
Elkhorn, Wisconsin 53121

Lot 4


Lot 5
0.36 Acres ±

Lot 6

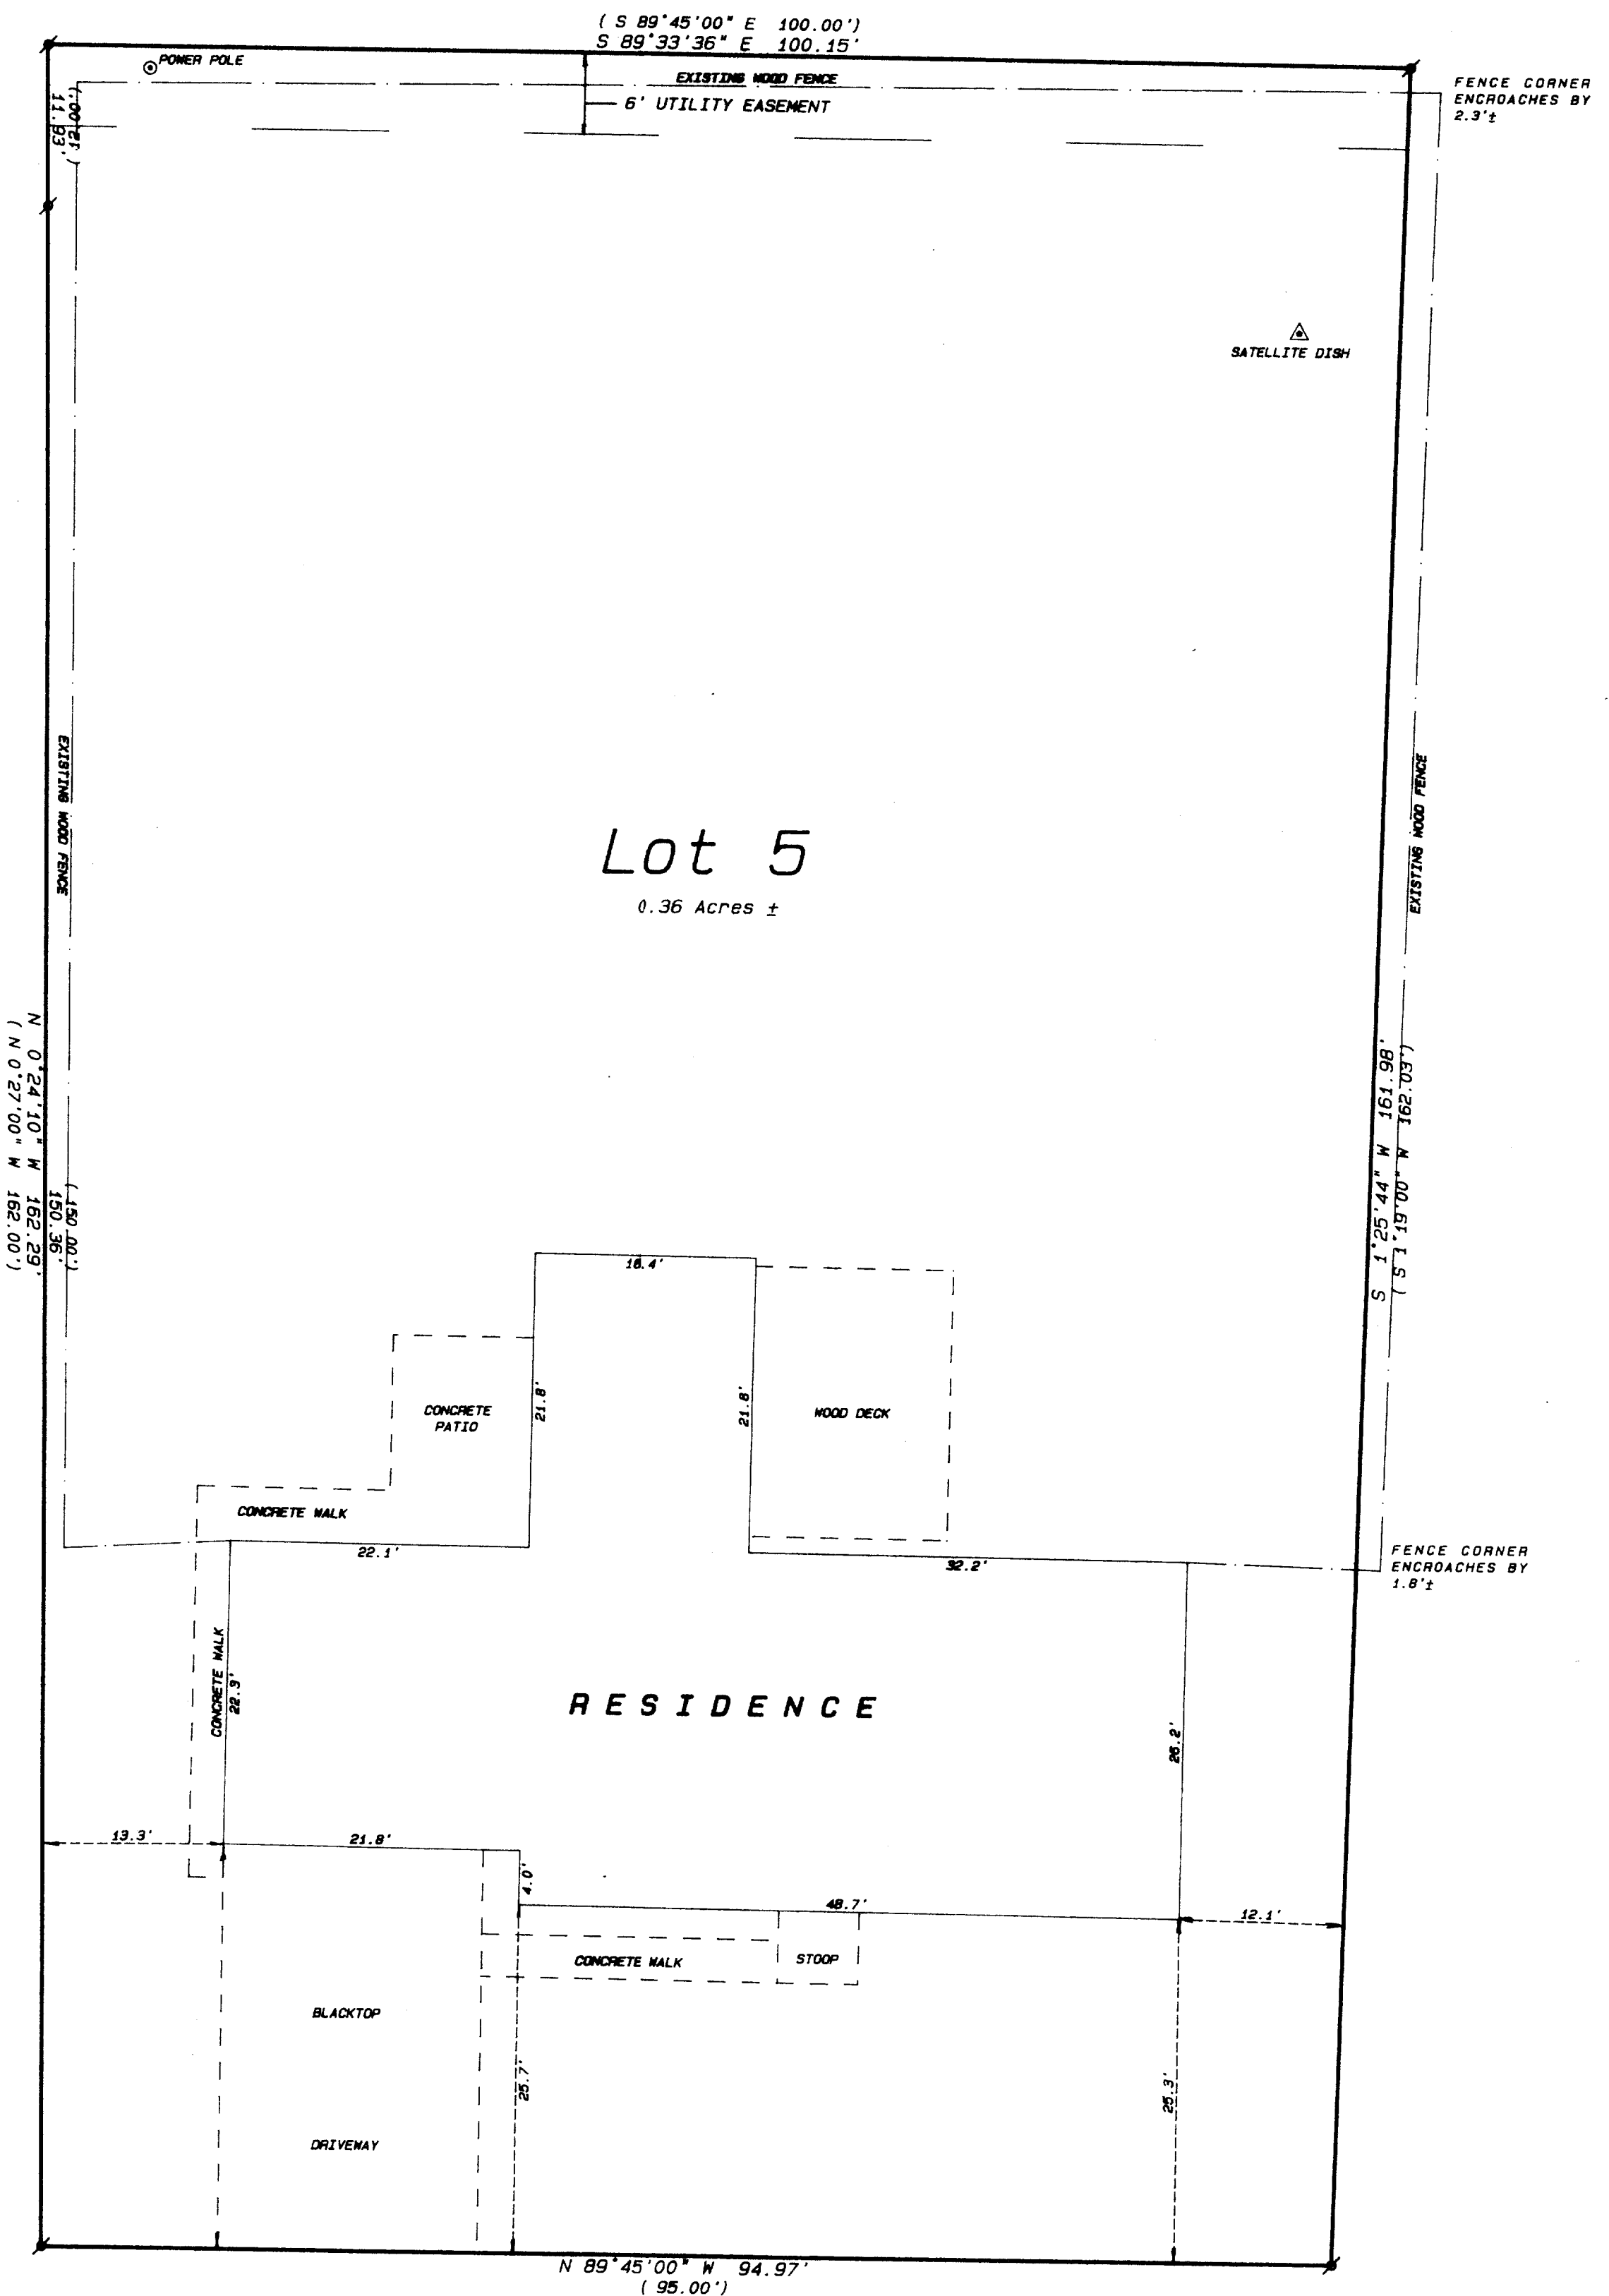

HARMONY LANE

66' WIDE

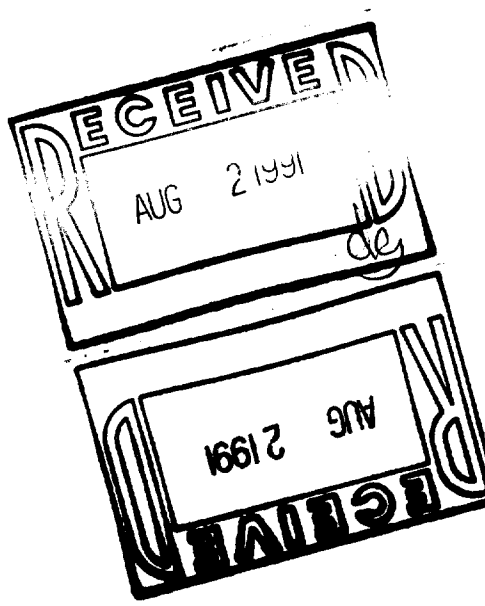

- Legend**
- FOUND IRON PIPE
 - FOUND IRON ROD
 - FOUND BRASS CAPPED MONUMENT
 - FOUND CONCRETE MONUMENT
 - CHISEL CUT IN CONCRETE
 - SET IRON ROD, 24" LONG, WEIGHING 1.5 LBS./LINEAL FT., 3/8" DIA.
 - SET IRON ROD, 30" LONG, WEIGHING 4.5 LBS./LINEAL FT., 1-1/16" DIA.
 - (xx) RECORDED AS DIMENSION
 - EXISTING FENCE

SCALE: 1"= 10 FEET

"I hereby certify that I have surveyed the above described property and that the above map is a true representation thereof and shows the size and location of the property, its exterior boundaries, the location of all visible structures and dimensions of all principal buildings thereon, boundary fences, apparent easements, roadways and visible encroachments, if any."

"This survey is made for the use of the present owners of the property, and also those who purchase, mortgage, or guarantee the title thereto within one year from date hereof."



Kenneth B. Abernathy, Jr.
KENNETH B. ABERNATHY, JR.
WISCONSIN REGISTERED LAND SURVEYOR
S-1594

Date: April 17, 1991 Job No. 1991-412

004-677