


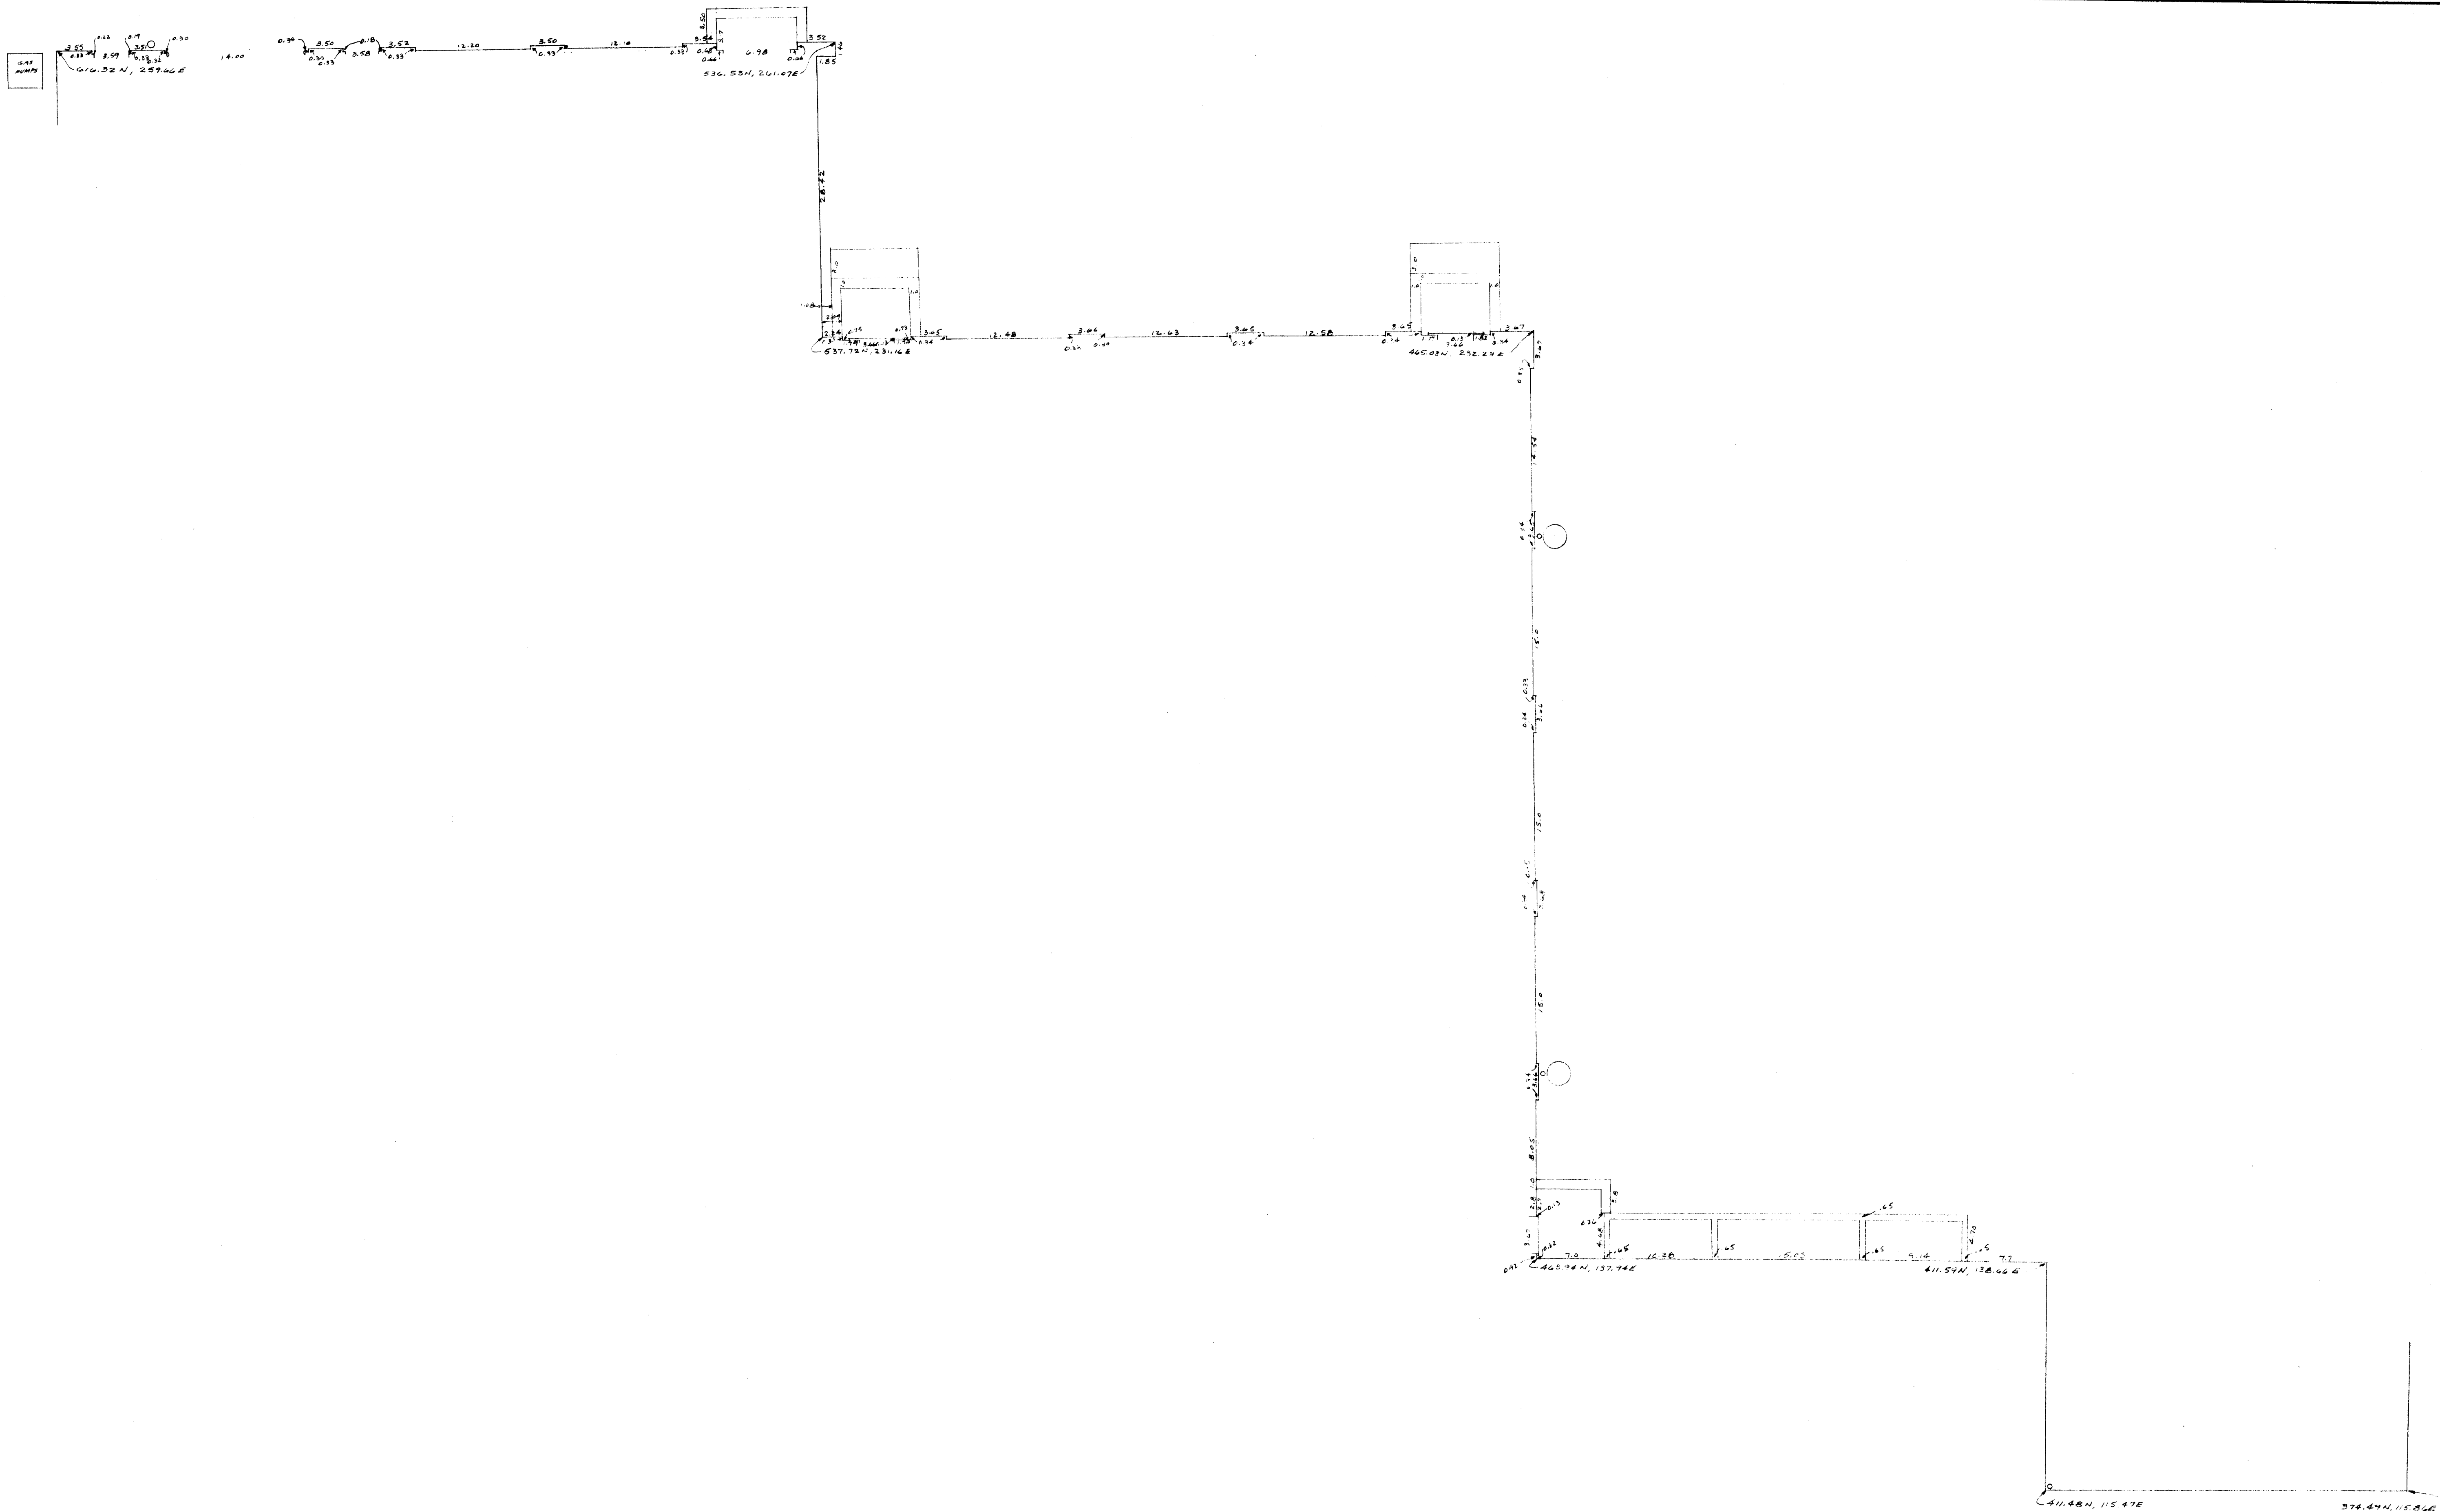

DIMENSIONS SHOWN ARE @ FOUNDATION FACE
 BLOW-UP EAST SIDE
 ELKHORN MIDDLE SCHOOL

DRAWN BY		SCALE: 1/2" = 1'-0"	
CHECKED BY <i>Lloyd Jensen</i>		REVISED	
APPROVED BY		SHEET NO. OF	
DATE			

JENSEN & JOHNSON
 CIVIL ENGINEERS
 ELKHORN, WIS.

