


DUNHAM SURVEYING, S.C.
SURVEYING & SUBDIVISION
DELAVER, WISCONSIN 53115

N

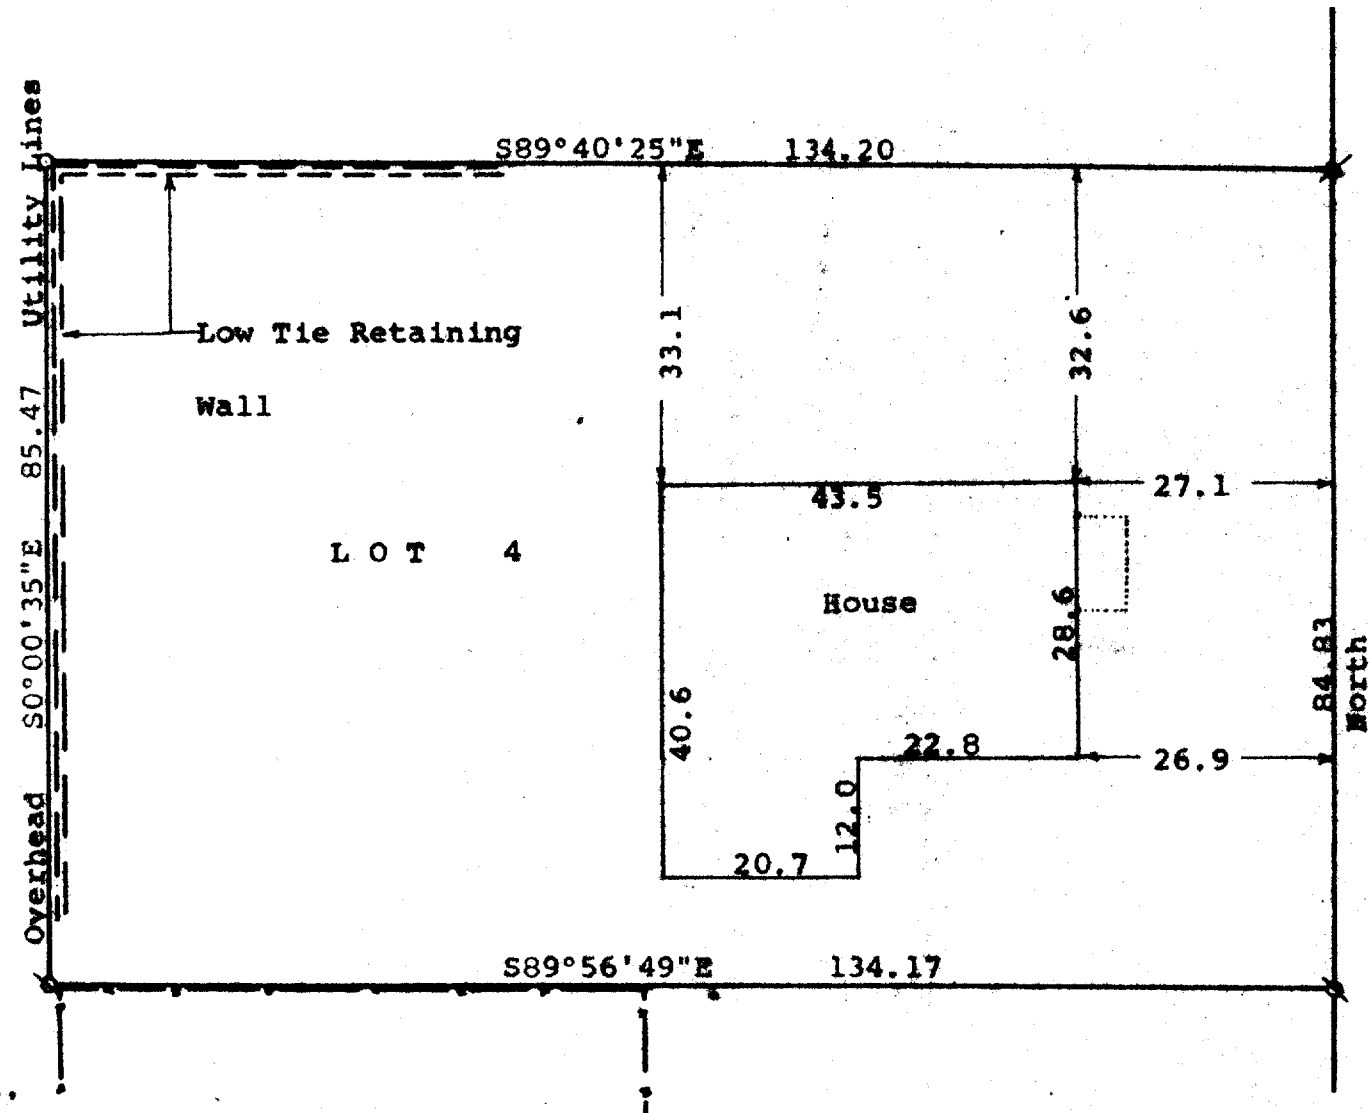

Scale - 1" = 20'
 X = 1" Iron Pipe Found
 # = 1" Iron Pipe Found 0.7' below ground
 O = 1/2" Iron Pipe Found
 --- = Fence Line

Bearings referenced to the west line of Broad Street with the assumed bearing of North
 Survey ordered by:
 Realty World, Carmin Realtors
 812 East Geneva Street
 Delavan, WI 53115

STATE OF WISCONSIN)
 COUNTY OF WALWORTH) SS
 I, George T. Dunham, Surveyor, certify that I have surveyed the property described as follows:
 Lot 4 in Block 39 of Davis Addition to the City of Elkhorn,
 Walworth County, Wisconsin,
 and that the plat shown hereon is a correct representation thereof and shows the size and location of the property, its exterior boundaries, the location of all visible structures and dimensions of all principal buildings thereon, boundary fences, apparent easements, roadways and visible encroachments, if any, and that I have surveyed the property hereon described according to the official records, to the best of my knowledge and belief.
 August 26, 1991

George T. Dunham
 George T. Dunham, Surveyor

