


DUNHAM SURVEYING, S.C.
SURVEYING & SUBDIVIDING
DELAVER, WISCONSIN 53115

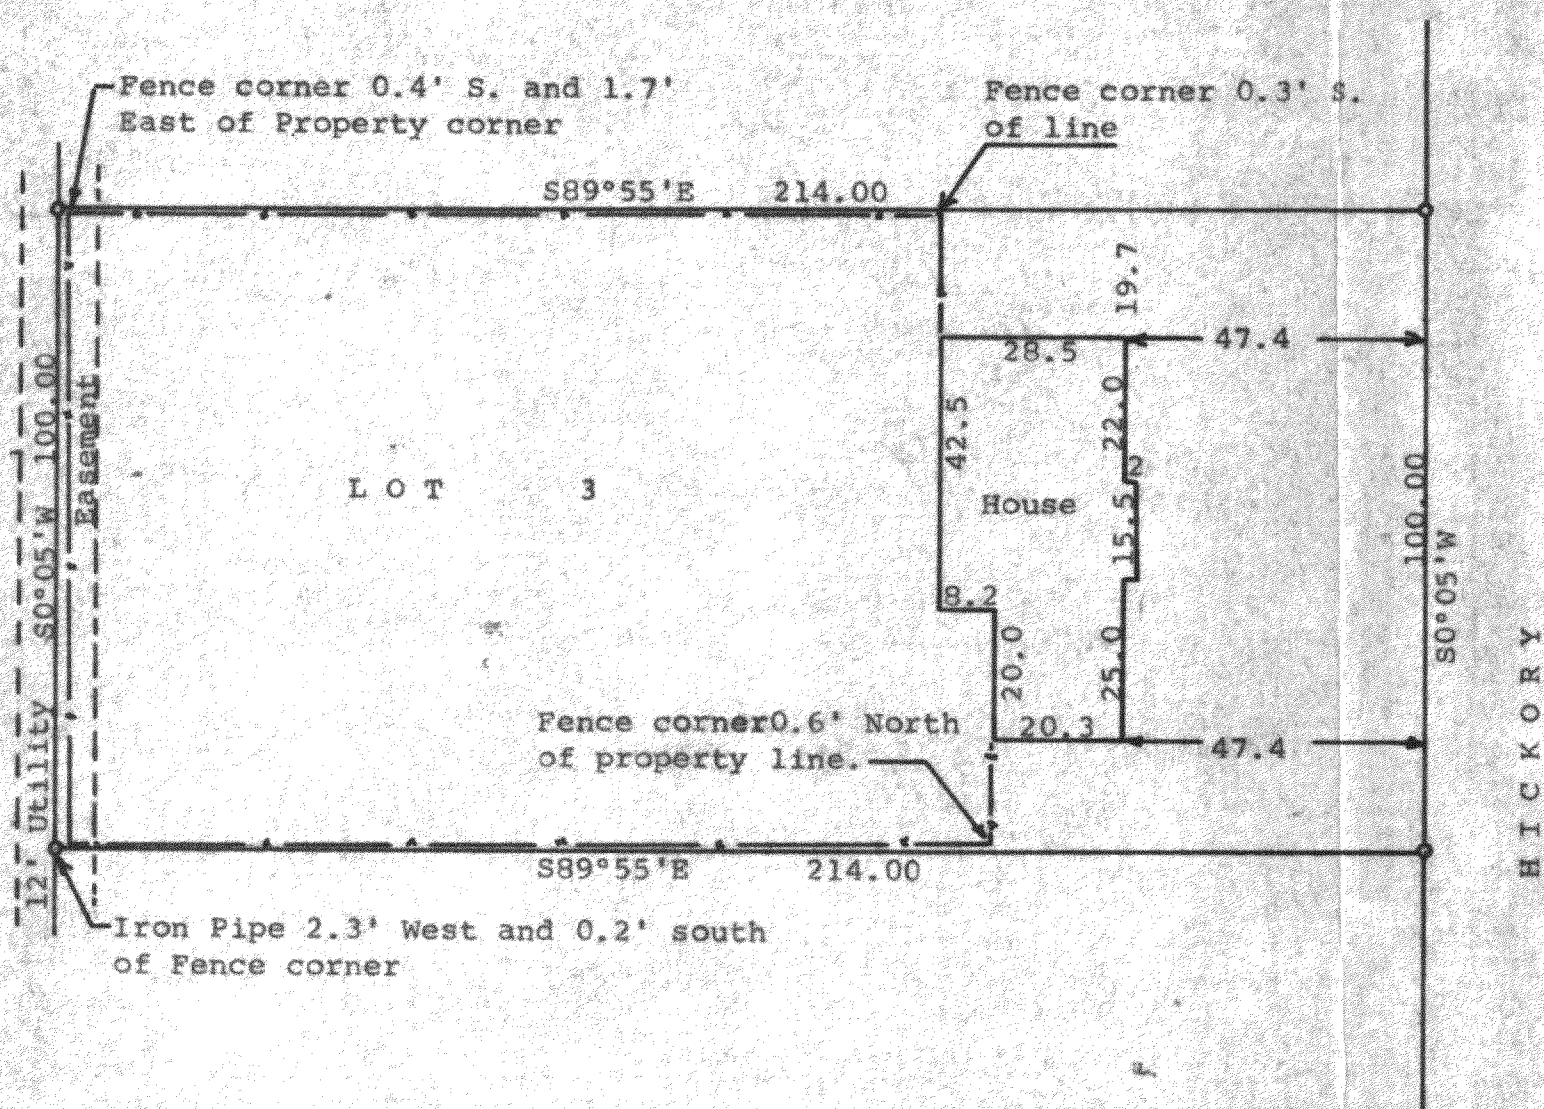

Scale - 1" = 30'

o = 1" Iron Pipe Found

Bearings are those shown of the recorded Plat of Certified Survey Map No. 1736

Survey ordered by:

M & I Mortgage Corporation

8484 West Brown Deer Road

Milwaukee, WI 53224

--- = Fence Line

STATE OF WISCONSIN) SS
COUNTY OF WALWORTH)

I, George T. Dunham, Surveyor, certify that I have surveyed the property described as follows:

Lot 3 of Certified Survey Map Number 1736 as recorded in Volume 8 of Certified Surveys on Page 147, Document Number 169629, in the Office of the Register of Deeds, Walworth County, Wisconsin, being a parcel of land located in the Northwest 1/4 of Section 8, T 2 N, R 17 E, City of Elkhorn, Walworth County, Wisconsin,

and that the plat shown hereon is a correct representation thereof and shows the size and location of the property, its exterior boundaries, the location of all visible structures and dimensions of all principal buildings thereon, boundary fences, apparent easements, roadways and visible encroachments, if any, and that I have surveyed the property hereon described, according to the official records, to the best of my knowledge and belief.

December 4, 1990

George T. Dunham
George T. Dunham, Surveyor

