


Plot of Survey

PARCEL ONE: THE WEST 1/2 OF LOT 4 IN BLOCK 21 IN ORIGINAL PLAT CITY OF ELKHORN
 PARCEL TWO: LOT 5 IN BLOCK 21 IN ORIGINAL PLAT CITY OF ELKHORN, EXCEPTING THEREFROM THE PREMISES
 SITUATED ON NORTH WASHINGTON STREET, IN THE CITY OF ELKHORN, WISCONSIN
 CONVEYED IN VOLUME 184 OF DEEDS ON PAGE 117 AS DOCUMENT NO. 256076.

JUNE 10, 1992


FEDERATED BANK

SURVEY NO. 154848-S

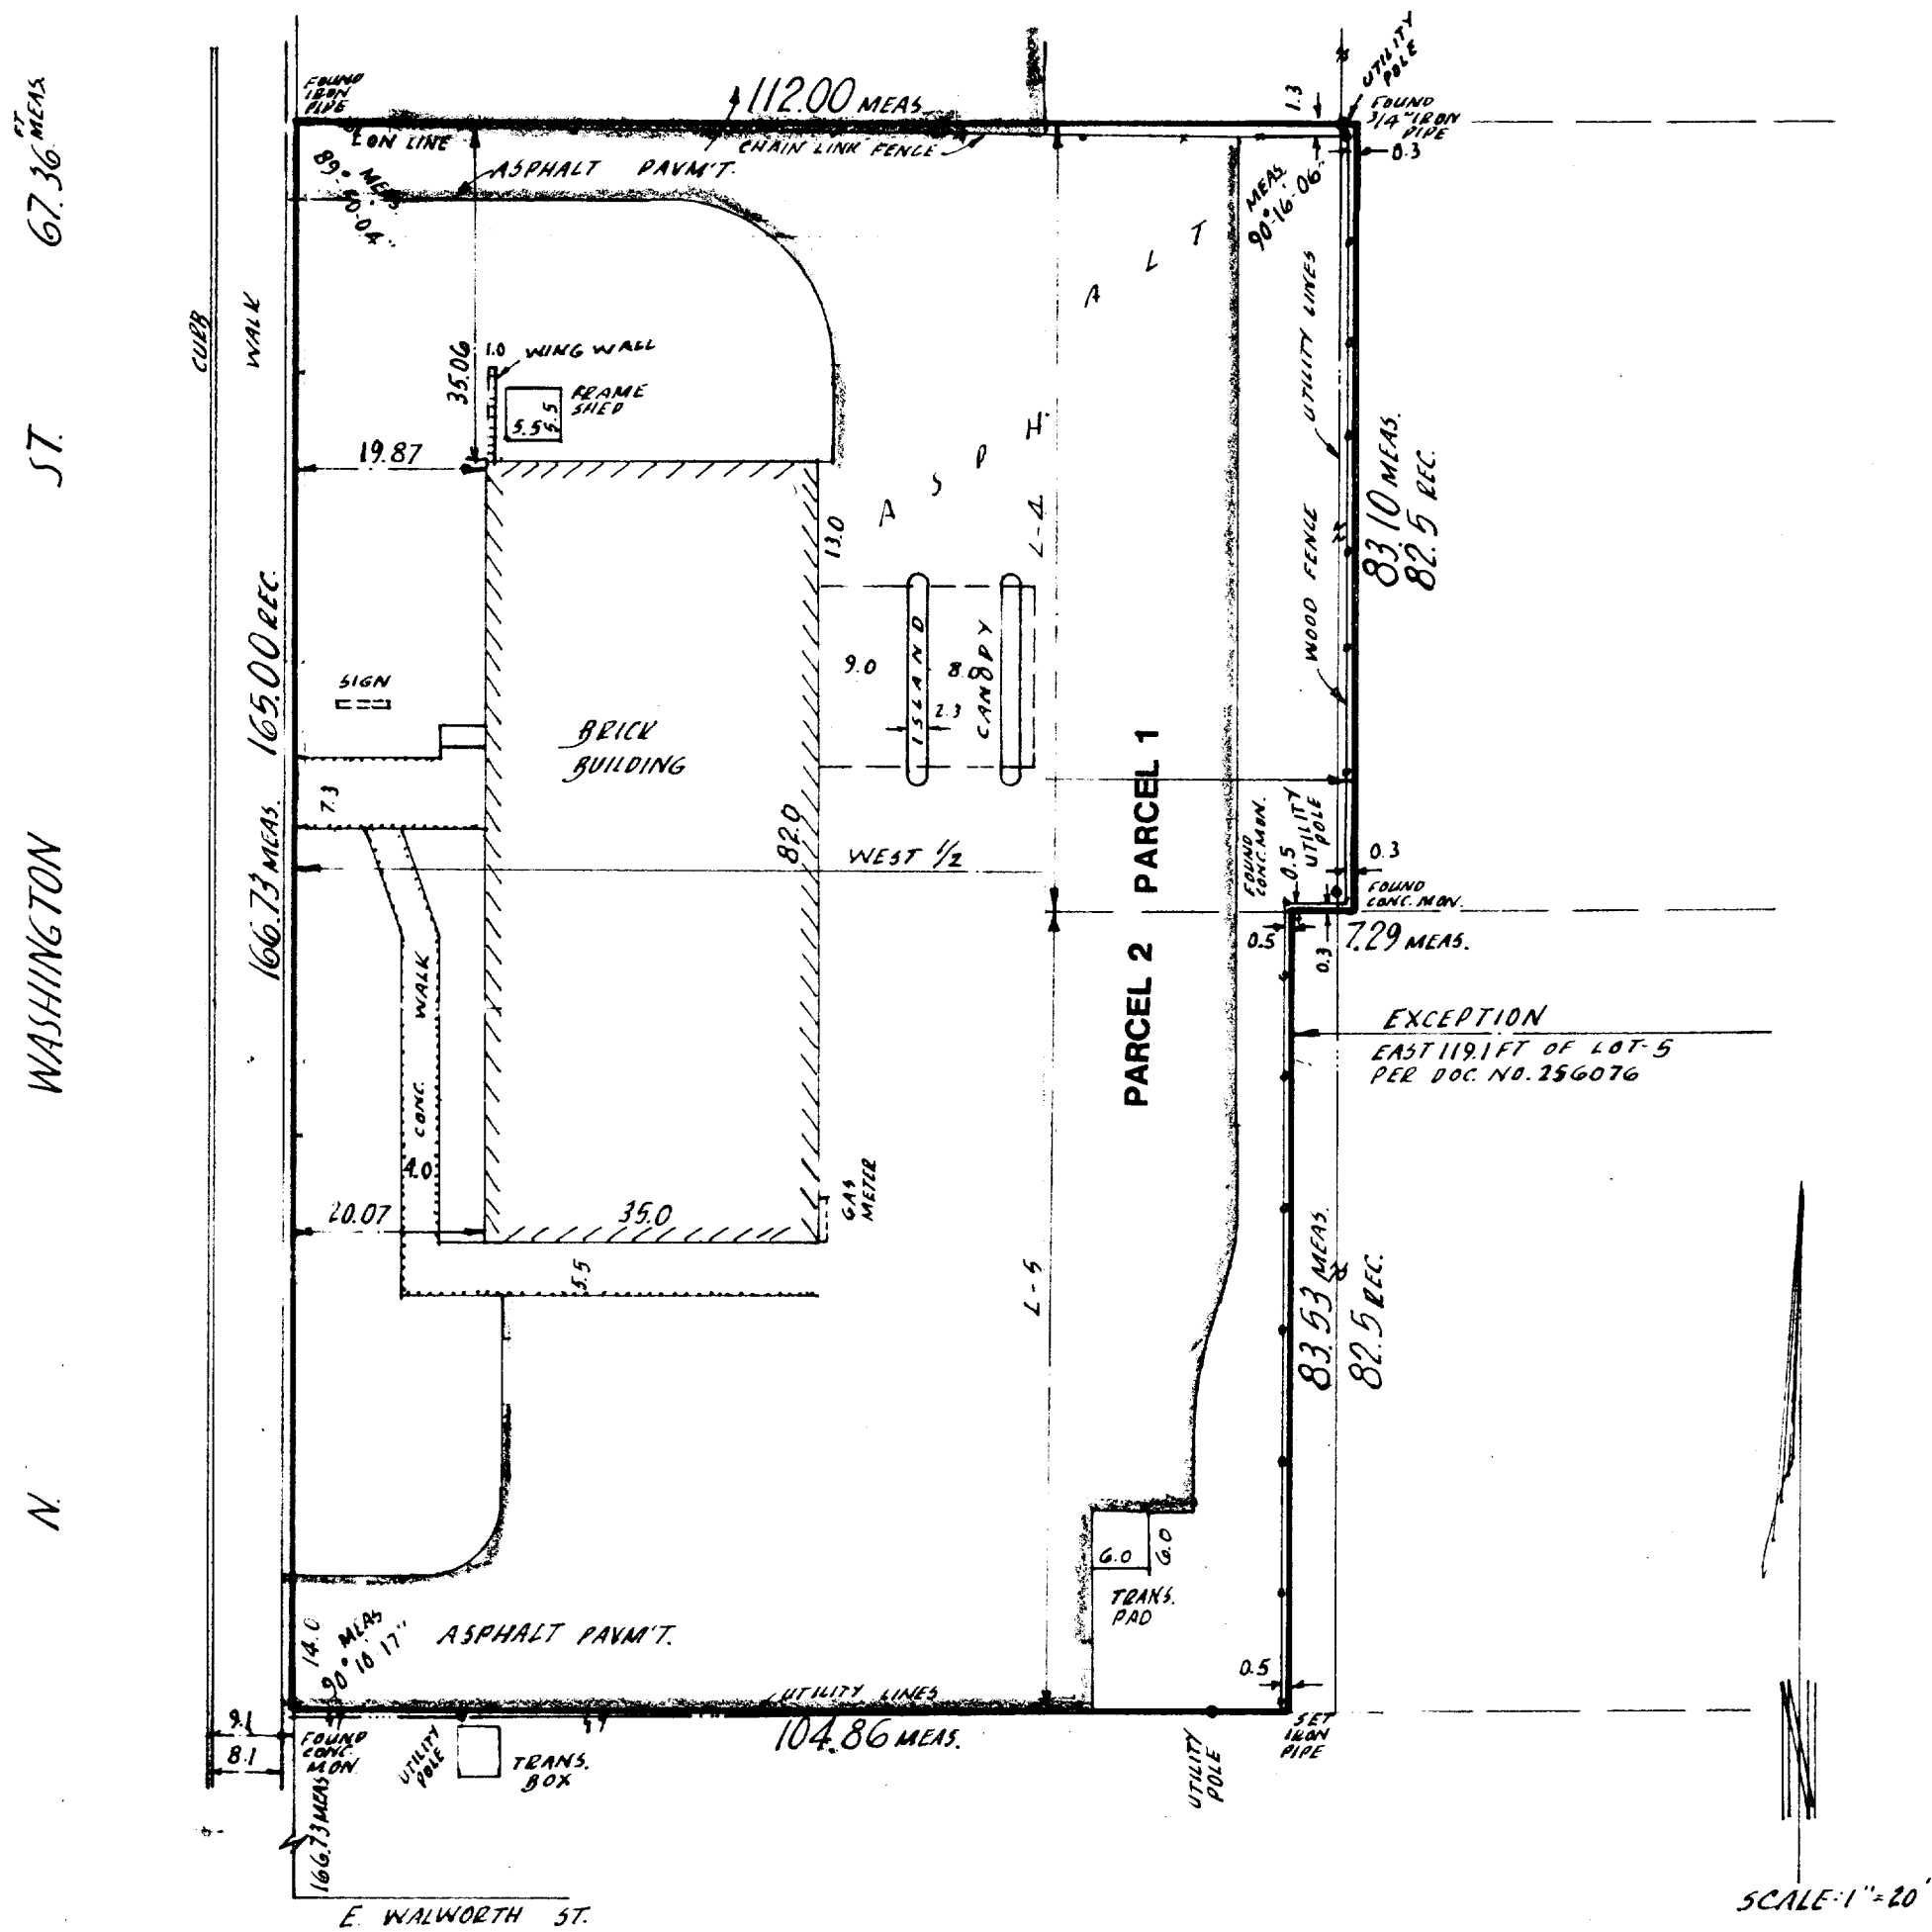

I Certify that I have surveyed the above described property (Property), and the above map is a true representation thereof and shows the size and location of the Property, its exterior boundaries, the location and dimensions of all visible structures thereon, boundary fences, apparent easements and roadways and visible encroachments, if any.


This survey is made for the exclusive use of the present owners of the Property, and also those who purchase, mortgage, or guarantee the title thereto, within one (1) year from date hereof.

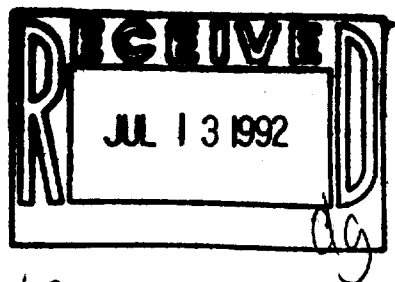

national survey & engineering

4125 north 124th street • brookfield, wisconsin, 53008-0444
phone 414 / 781-1000

Kenneth E. Bunker
SURVEYOR
**THIS IS ORIGINAL
PRINT ONLY IF
SEAL IS IMPRINTED
IN RED**
8-0444

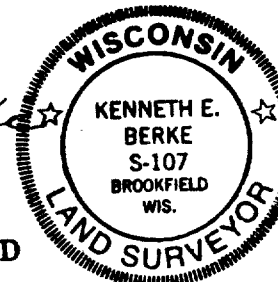

YOP-173