



WISCONSIN ST.

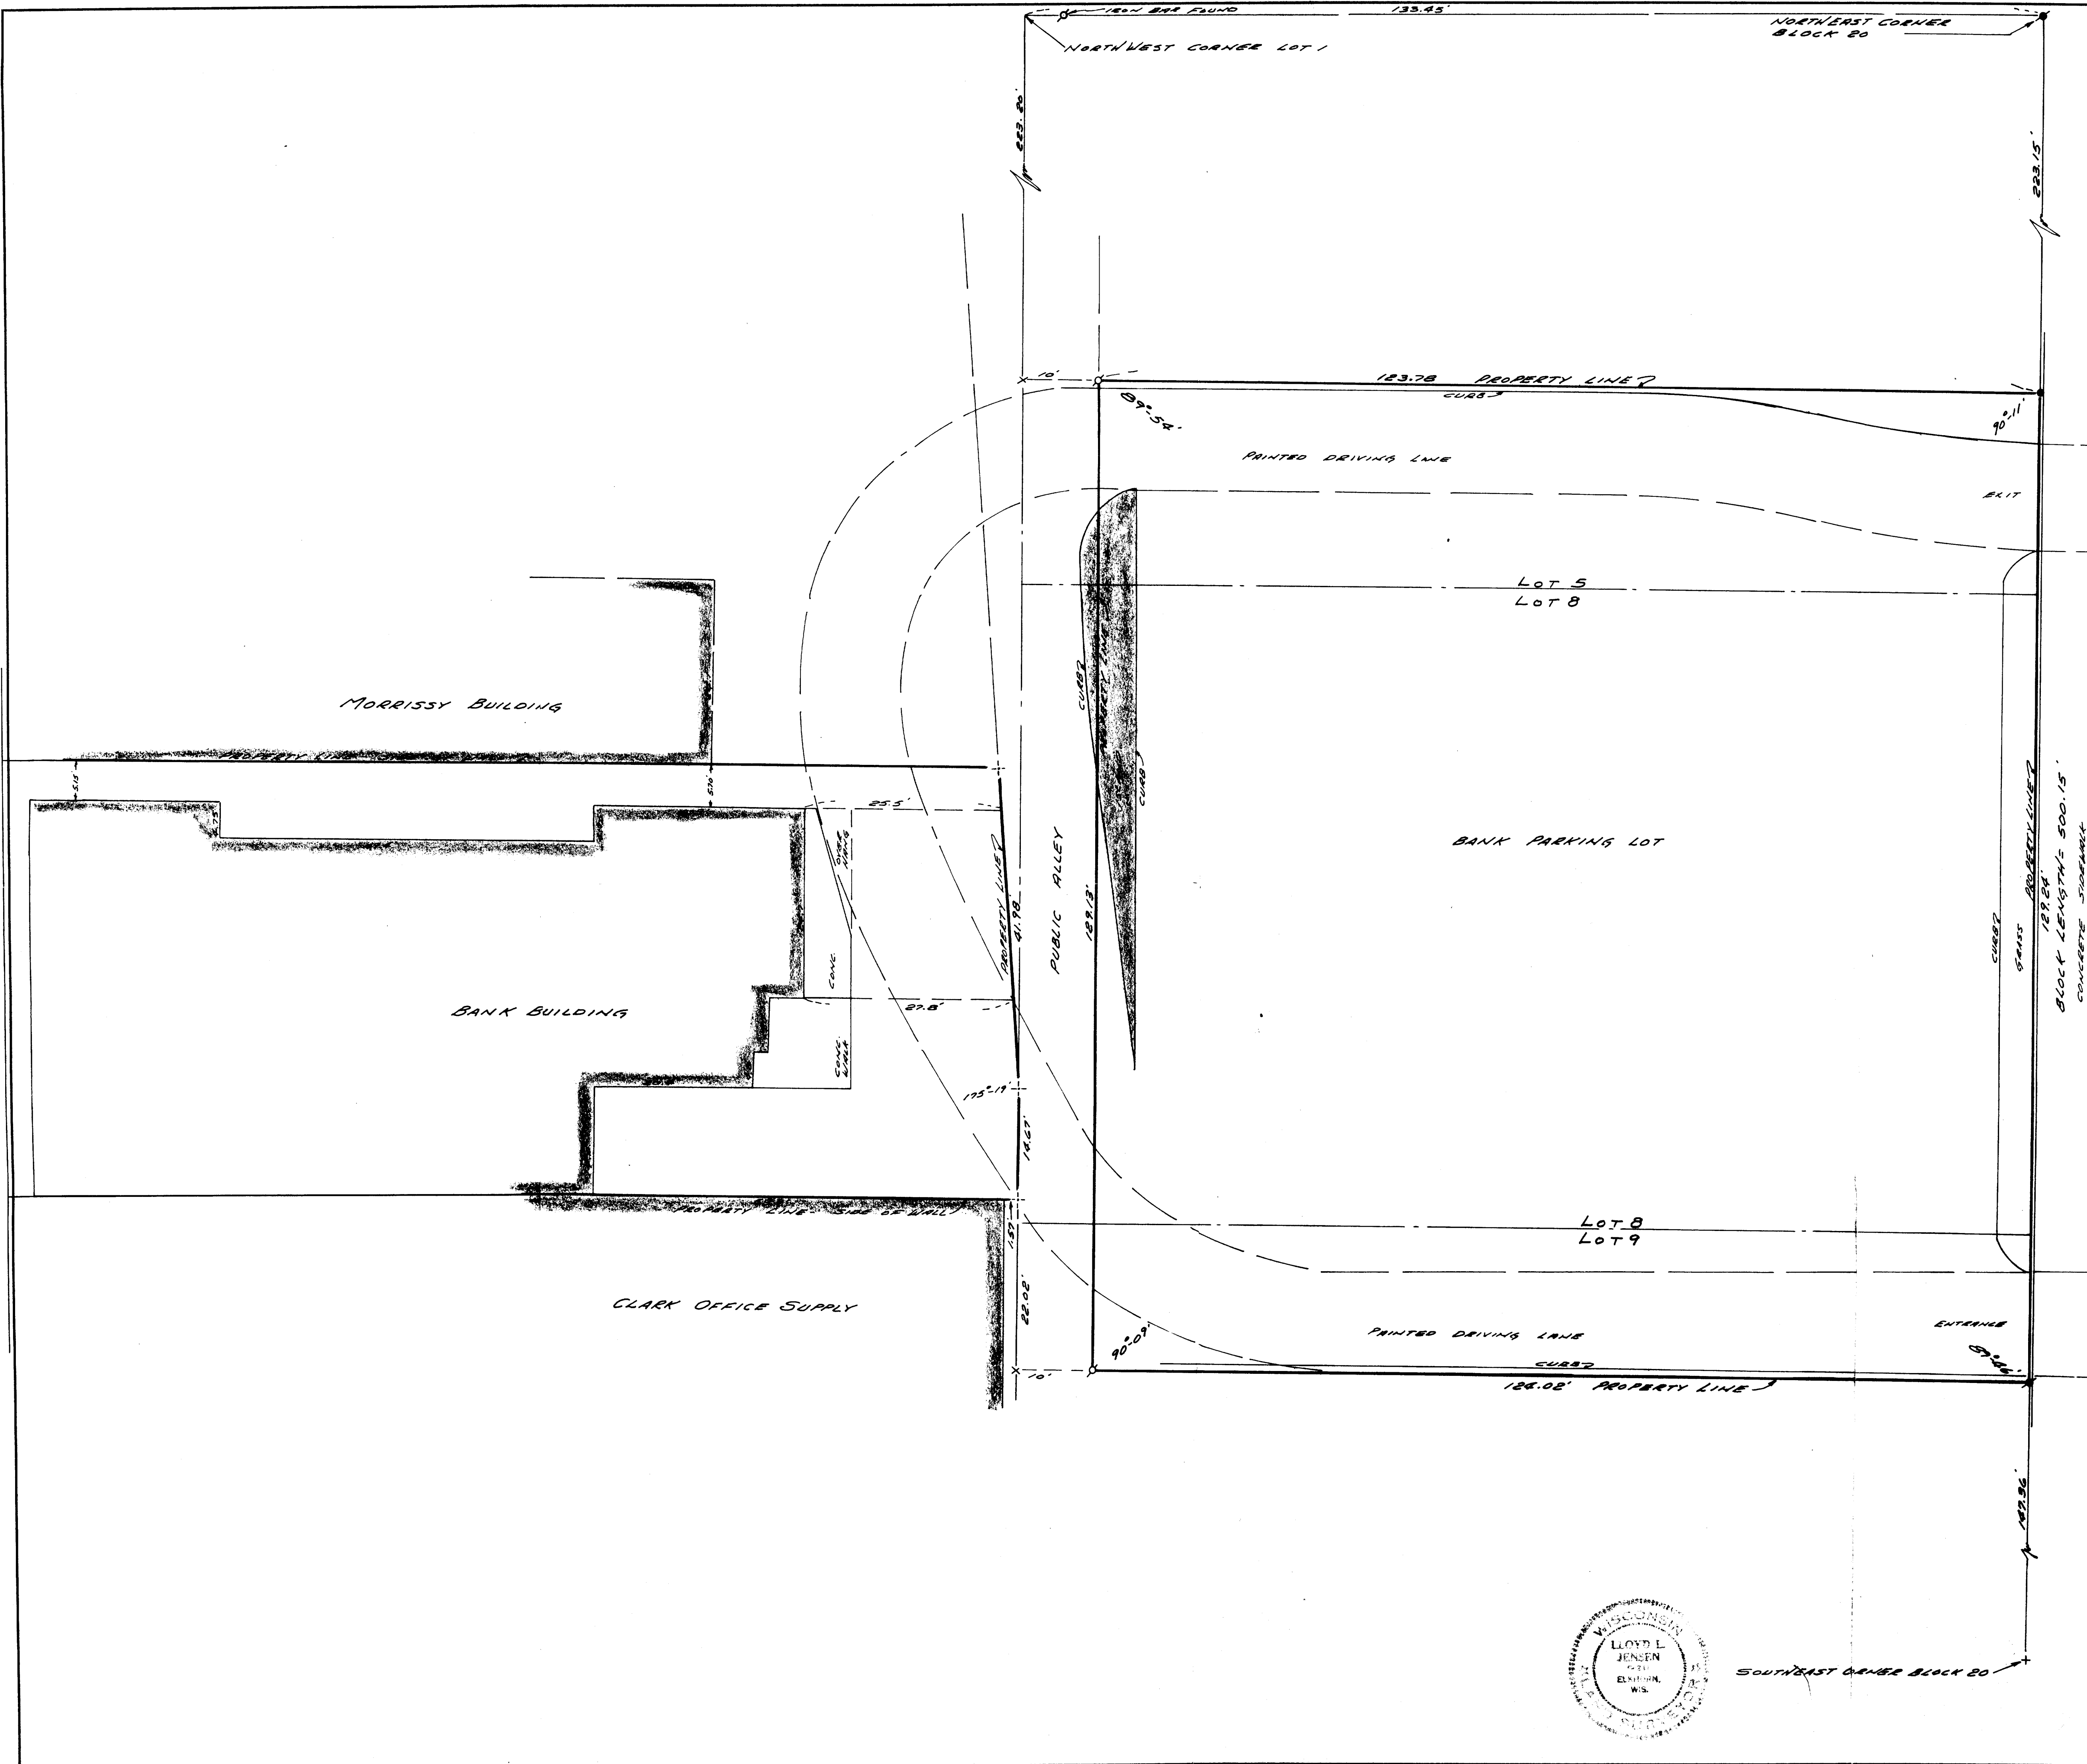

WASHINGTON ST.

- - CONCRETE MONUMENT FOUND
- - CONCRETE MONUMENT SET
- - IRON PIPE FOUND
- - 60 PENNY SPIKE FOUND
- - 1/4\"

NOTE:
THE ESTABLISHMENT OF ALL BLOCK
CORNERS IN THE ORIGINAL PLAT ARE
BASED ON AVAILABLE RECORDS IN THE
CITY ENGINEER'S OFFICE. UNDERMIN OR
OVER RUN OF LOT AND BLOCK DISTANCES
WERE ESTABLISHED FROM SAID RECORDS.

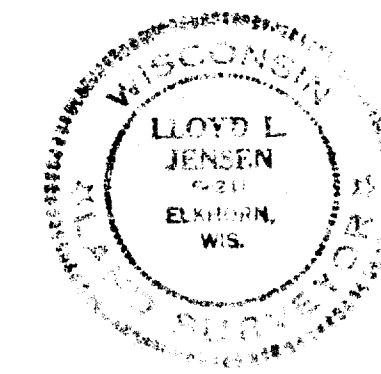

PLAT OF SURVEY OF LOT 8 AND PART OF LOTS 5 & 9 BLOCK 20, ORIGINAL PLAT, CITY OF ELKHORN, WILKINSON COUNTY, WISCONSIN.		
OWNER - FIRST NATIONAL BANK ELKHORN, WISCONSIN		
DRAWN BY L. JENSEN	JENSEN & JOHNSON CIVIL ENGINEERS ELKHORN, WIS. DATE AUG. 1971	SCALE: 1" = 10'
CHECKED BY L. JENSEN		REVISED
APPROVED BY		SHEET NO. 1 OF 1