


PLAT OF SURVEY
LOCATED IN THE SE 1/4
SECTION 36, TOWN 3 NORTH, RANGE 16 EAST
CITY OF ELKHORN, WALWORTH COUNTY
WISCONSIN


PLAT OF SURVEY
 SE 1/4 SECTION 36
 TOWN 3 NORTH, RANGE 16 EAST
 CITY OF ELKHORN, WALWORTH COUNTY
 WISCONSIN

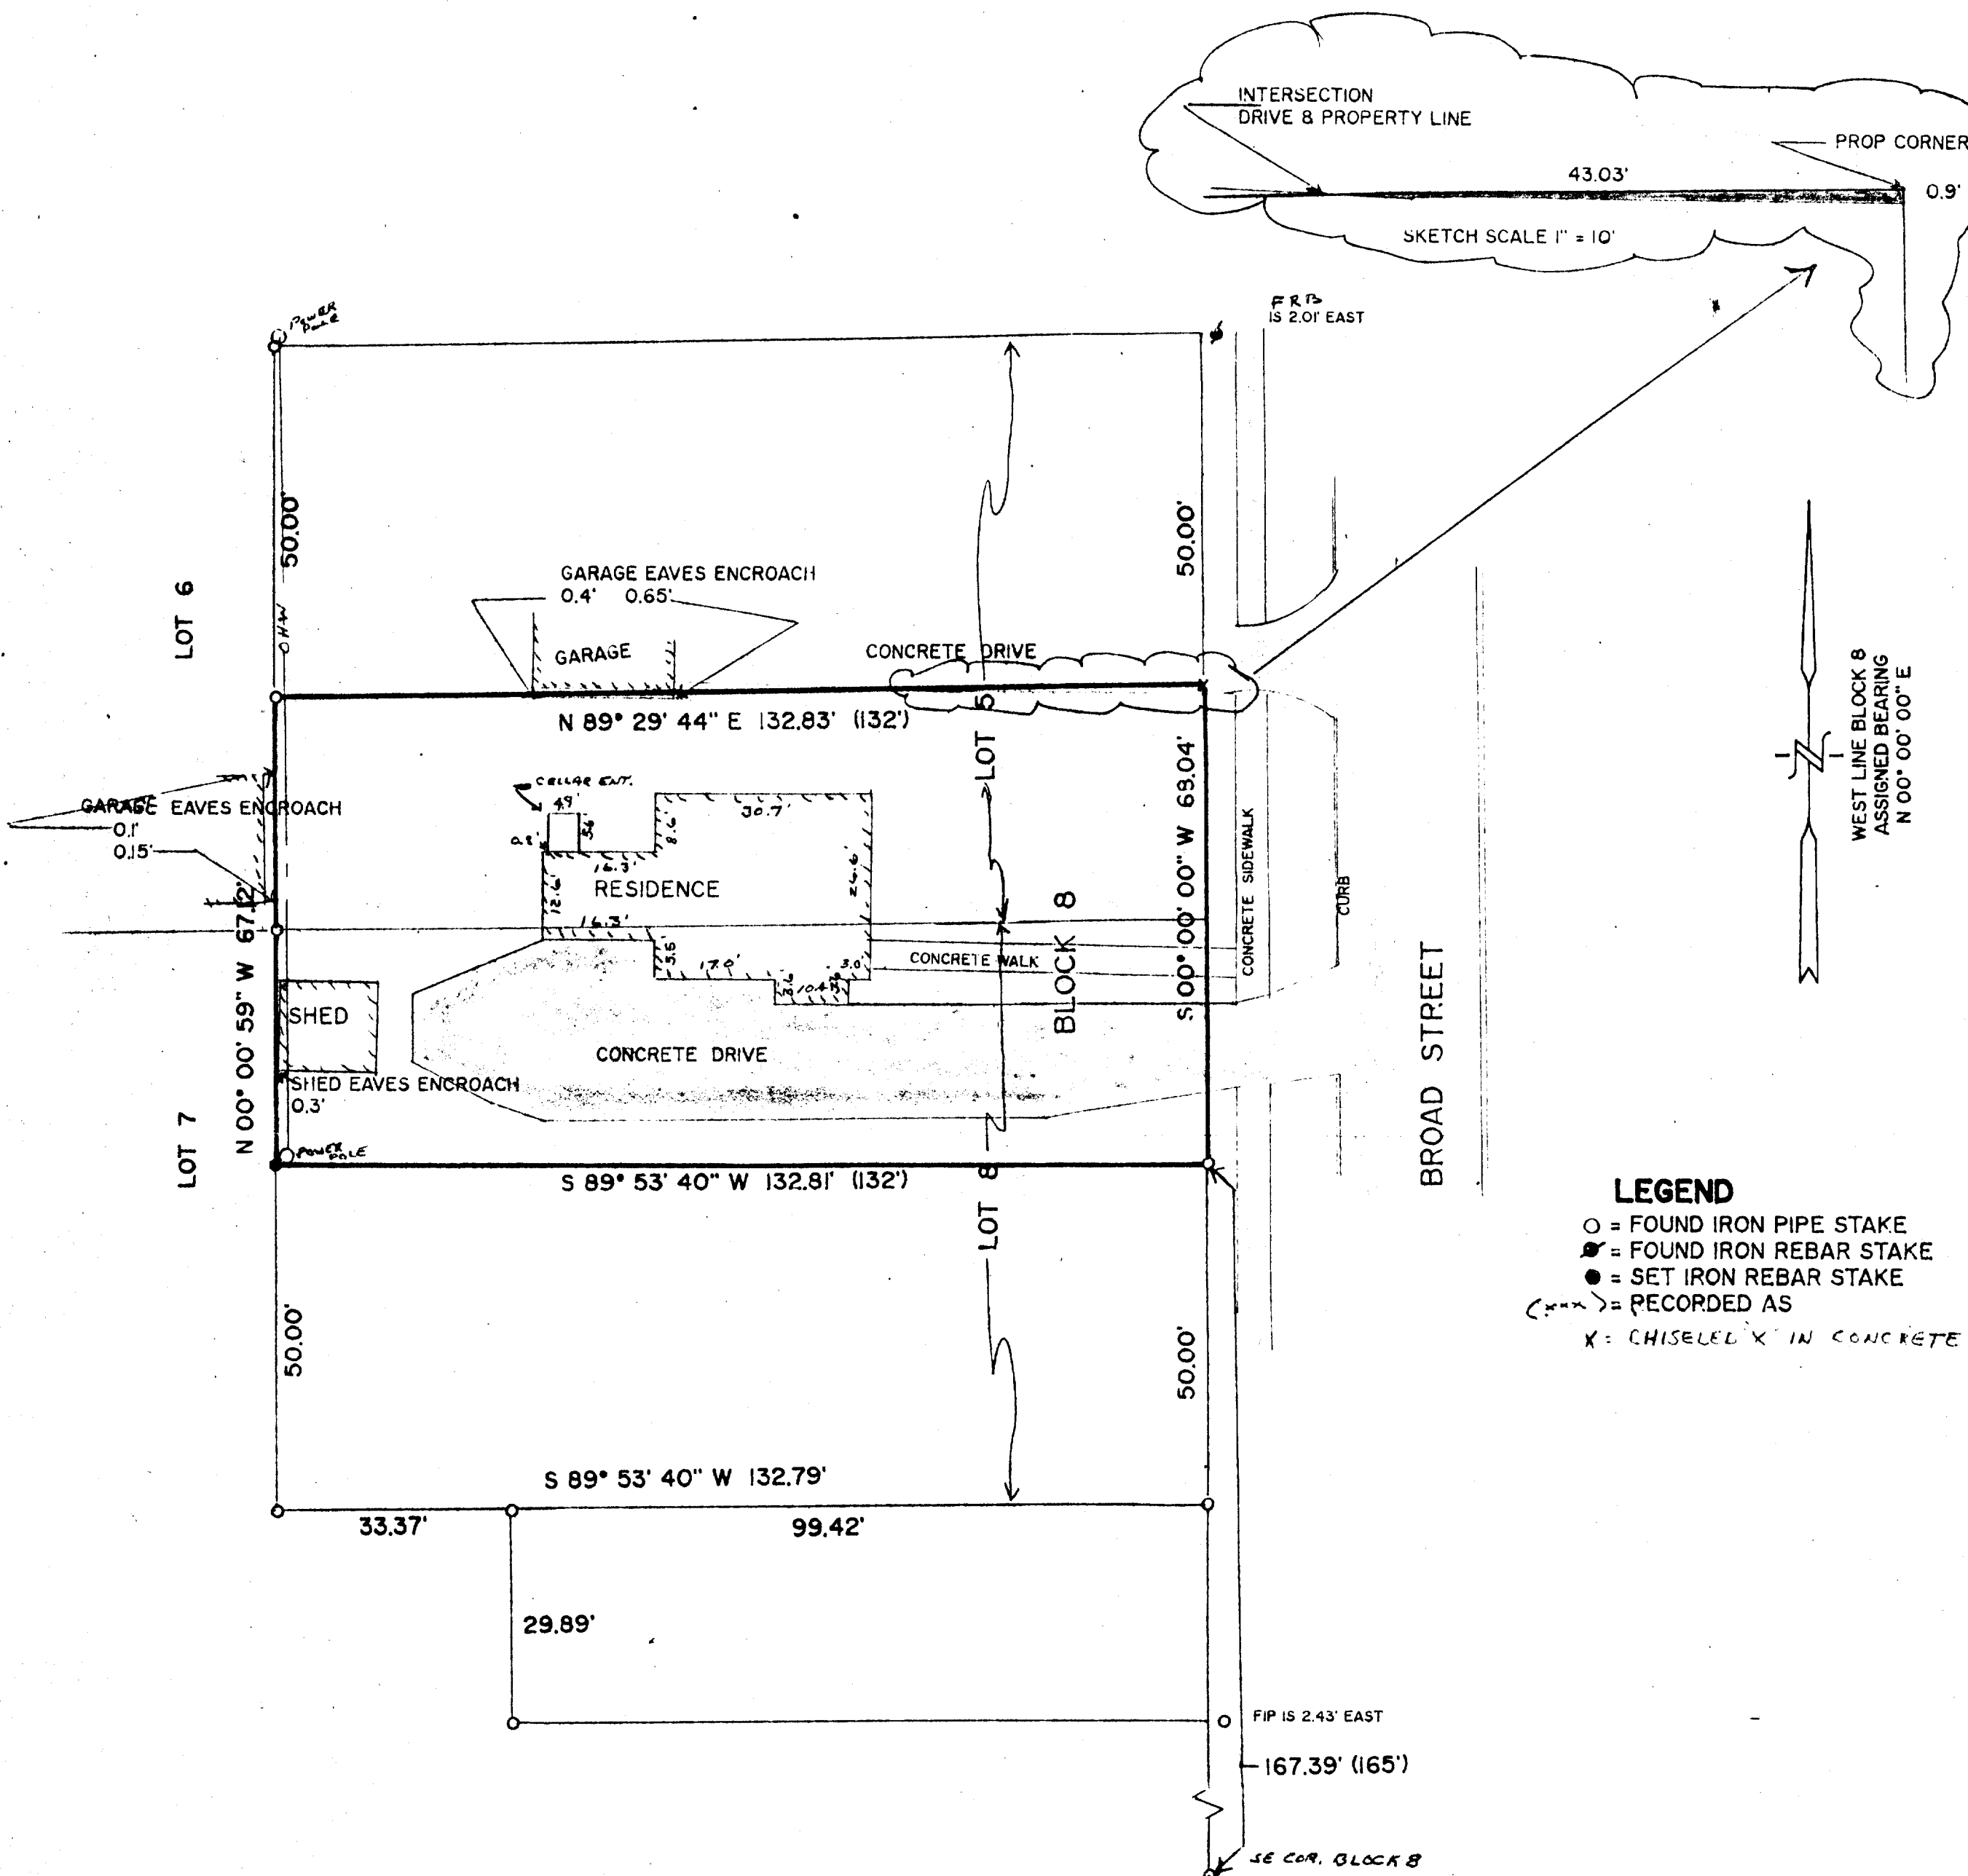

LEGEND
 O = FOUND IRON PIPE STAKE
 ● = FOUND IRON REBAR STAKE
 ● = SET IRON REBAR STAKE
 (---) = RECORDED AS
 X = CHISELED X IN CONCRETE

LEGAL DESCRIPTION

.44- Lots 5 and 8 in Block 8, excepting the S. 50 ft. of Lot 8 and excepting the N. 50 ft. of Lot 5 in the Village, now City of Elkhorn, Walworth County, Wisconsin.


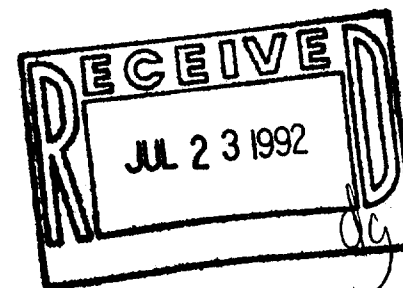


NOTE: COPIES OF THIS MAP TO WHICH THE FOLLOWING CERTIFICATE WILL APPLY ARE BLUE LINE PRINTS SHOWING SURVEYOR'S ORIGINAL SEAL AND SIGNATURE IN BLACK INK. COPIES BY ANY OTHER MEANS MAY HAVE ALTERATIONS WHICH DO NOT REPRESENT THE SURVEYOR'S WORK PRODUCT.

I HEREBY CERTIFY THAT THIS PLAT OF SURVEY IS A TRUE AND ACCURATE REPRESENTATION OF THE BOUNDARY LINES OF THE SUBJECT PARCELS TO THE BEST OF MY PROFESSIONAL KNOWLEDGE AND BELIEF. THIS SURVEY IS MADE FOR THE USE OF THE PRESENT OWNERS OF THE PROPERTY, AND ALSO THOSE WHO PURCHASE, MORTGAGE, OR GUARANTEE THE TITLE THERETO WITHIN ONE YEAR FROM THE DATE HEREOF.

DATED: JUNE 18, 1992

Peter S. Gordon
 PETER S. GORDON RLS 2101

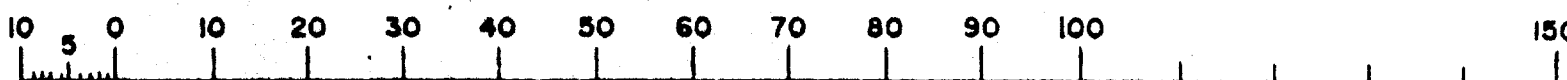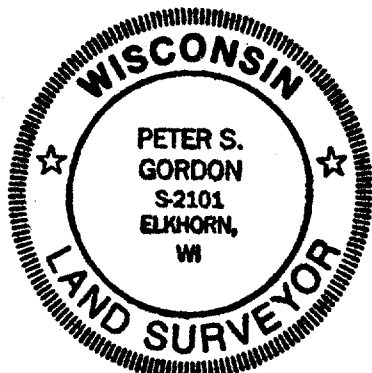

WORK ORDERED BY: CENTURY 21
 FOR: JACK + JAN PAPKE (OWNERS)

FARRIS, HANSEN & ASSOCIATES, INC.
 Engineering, Architecture, Surveying
 7 Ridgway Court P.O. Box 437
 ELKHORN, WISCONSIN 53121
 Office: (414) 723-2098
 Fax: (414) 723-5886

REVISIONS

PROJECT NO.
3662
 DATE
6-16-92
 SHEET NO.
1 OF 1