


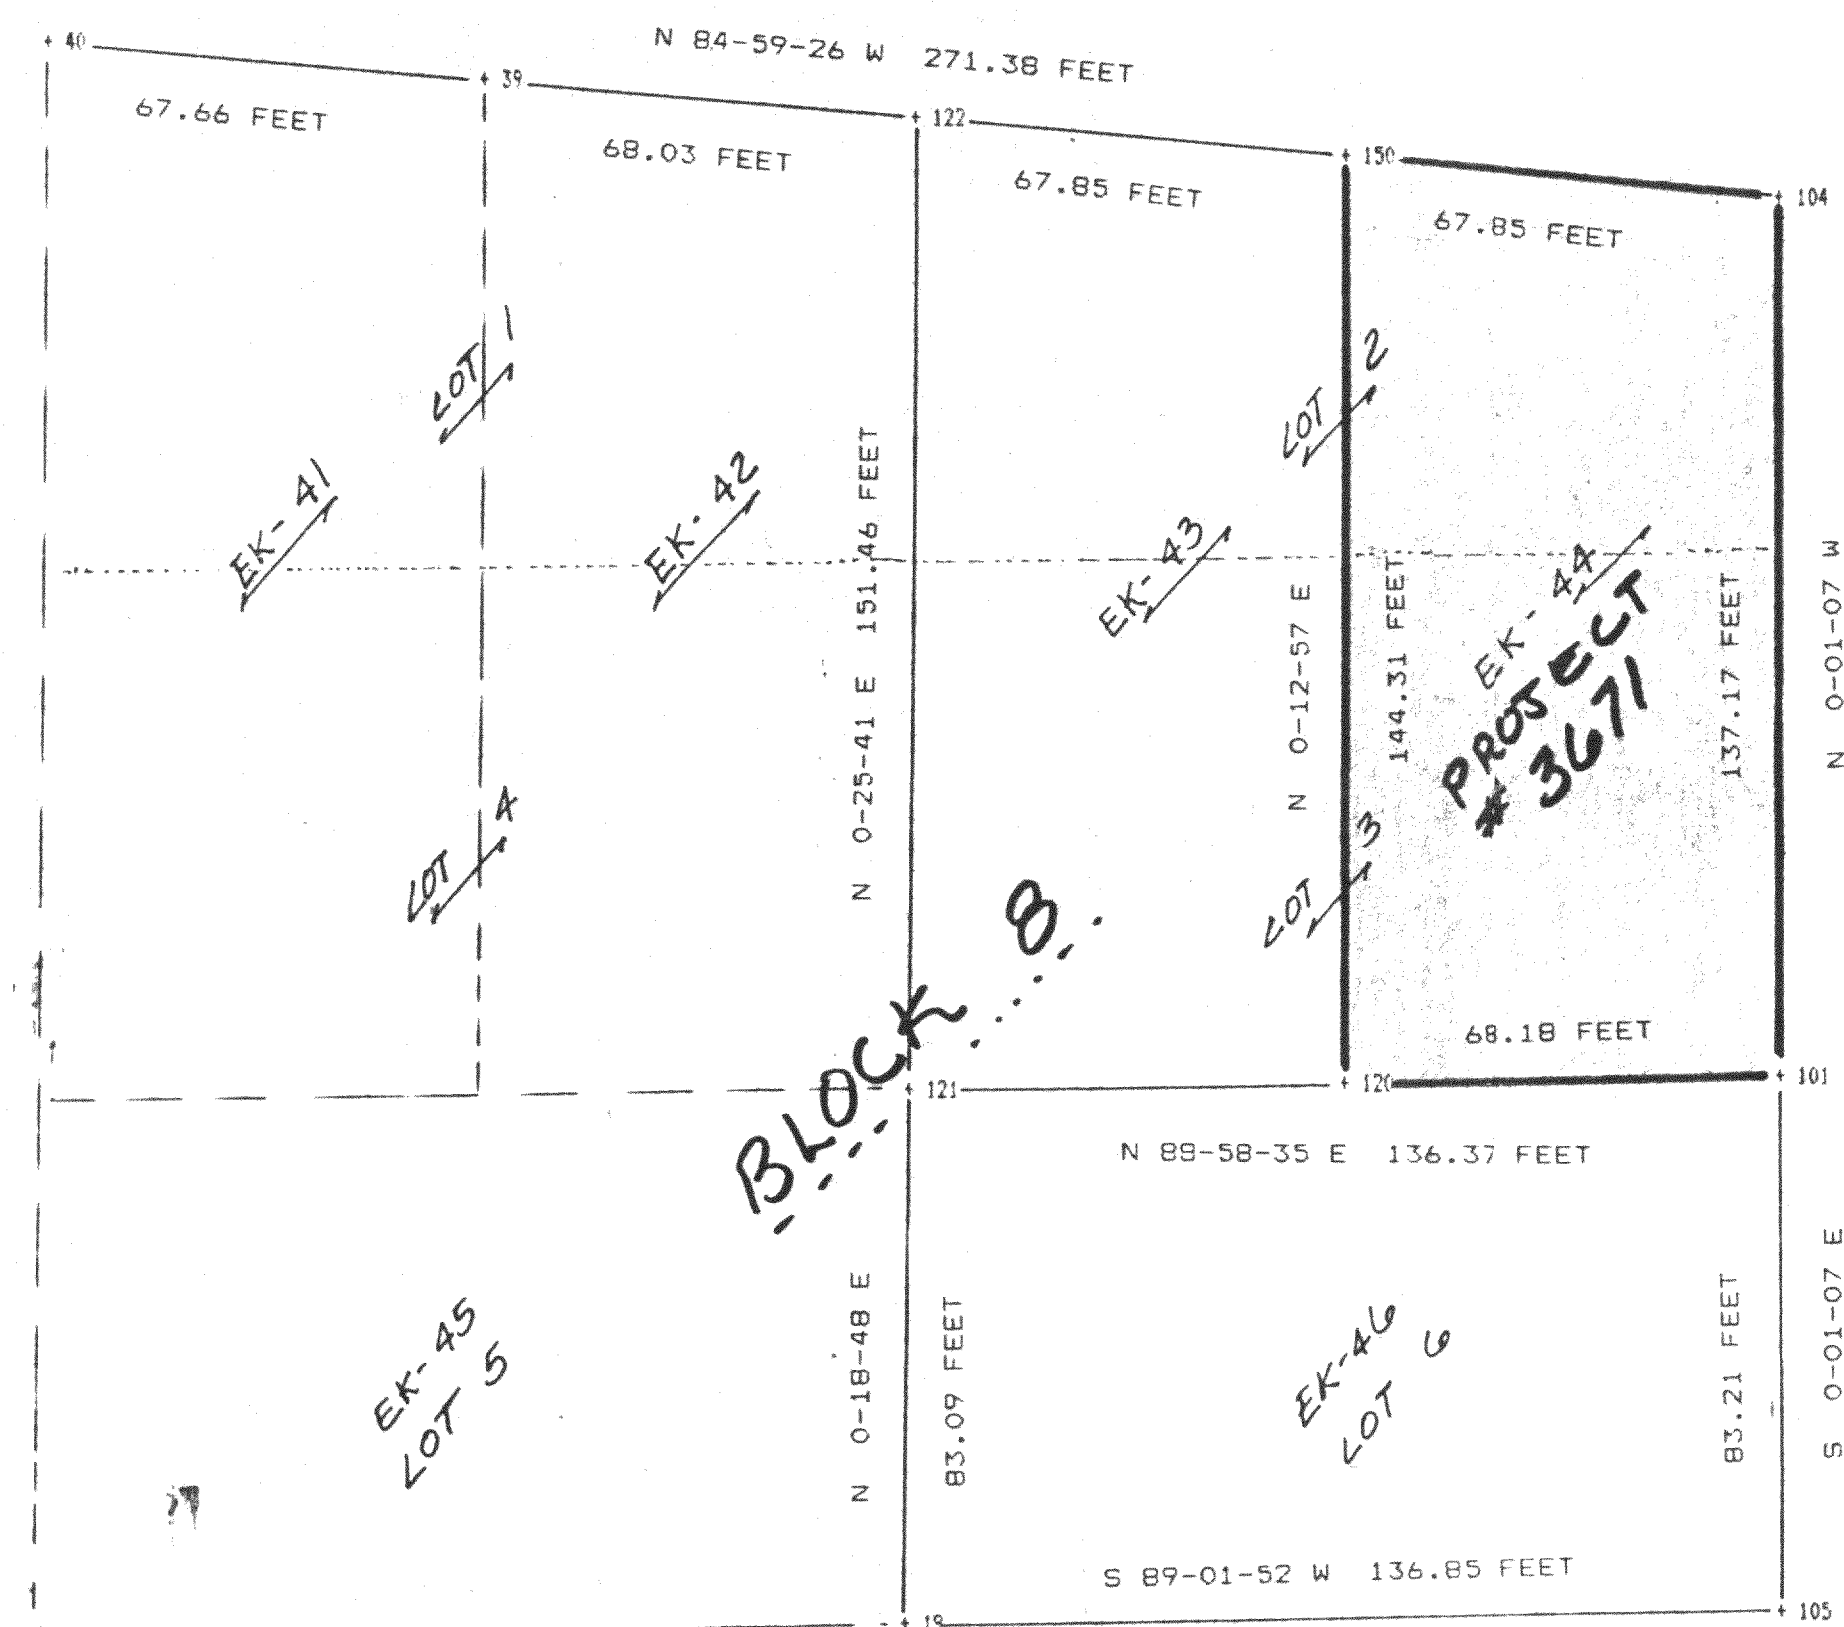


DESCRIPTION OF
NUMBERED POINTS


40 IS AN IRON REBAR STAKE FOUND
39 IS AN IRON PIPE STAKE FOUND
122 IS CALCULATED POSITION FOR NW COR LOT 2
FOUND IRON PIPE STAKE LEANING NORTHEASTERLY
N 66-35 E 0.29 FROM 122
150 IS CALCULATED POSITION FOR NW COR EK-44 -SET REBAR STAKE
104 IS ON EAST LINE OF LOT 6 EXTENDED NORTHERLY
USING EAST LINE OF LOT 6 AS MEASUREMENT INDEX - PAINTED WALK
101 FOUND IRON PIPE STAKE 1 FOOT WEST OF THIS POINT AS
SHOWN ON SURVEY OF LOT 6 BY DUNHAM IN 1957 - FOUND CHS "X"
105 FOUND IRON PIPE STAKE 1 FOOT WEST OF THIS POINT AS
SHOWN ON SURVEY OF LOT 6 BY DUNHAM IN 1957
19 FOUND IRON PIPE STAKE
121 CALCULATED POSITION FOR NW COR LOT 6 USING DIMENSIONS
SHOWN ON SURVEY OF LOT 6 BY DUNHAM IN 1957
120 CALCULATED POSITION FOR SW COR OF EK-44 -SET REBAR STAKE

NOTE: COPIES OF THIS MAP TO WHICH THE FOLLOWING CERTIFICATE WILL APPLY ARE BLUE LINE PRINTS SHOWING SURVEYOR'S
ORIGINAL SEAL AND SIGNATURE IN BLACK INK. COPIES BY ANY OTHER MEANS MAY HAVE ALTERATIONS WHICH DO NOT
REPRESENT THE SURVEYOR'S WORK PRODUCT.

I HEREBY CERTIFY THAT THE ABOVE DESCRIBED PROPERTY HAS BEEN SURVEYED UNDER MY DIRECTION AND THAT THE ABOVE MAP IS A
TRUE REPRESENTATION THEREOF AND SHOWS THE SIZE AND LOCATION OF THE PROPERTY AND ITS EXTERIOR BOUNDARIES. THIS SURVEY
IS MADE FOR THE USE OF THE PRESENT OWNERS OF THE PROPERTY, AND ALSO THOSE WHO PURCHASE, MORTGAGE, OR GUARANTEE
THE TITLE THERETO WITHIN THE YEAR FROM THE DATE HEREOF.

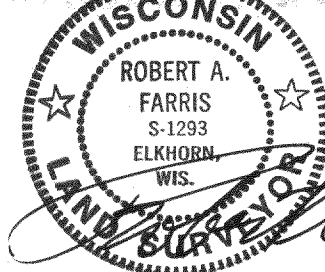


7/10/92

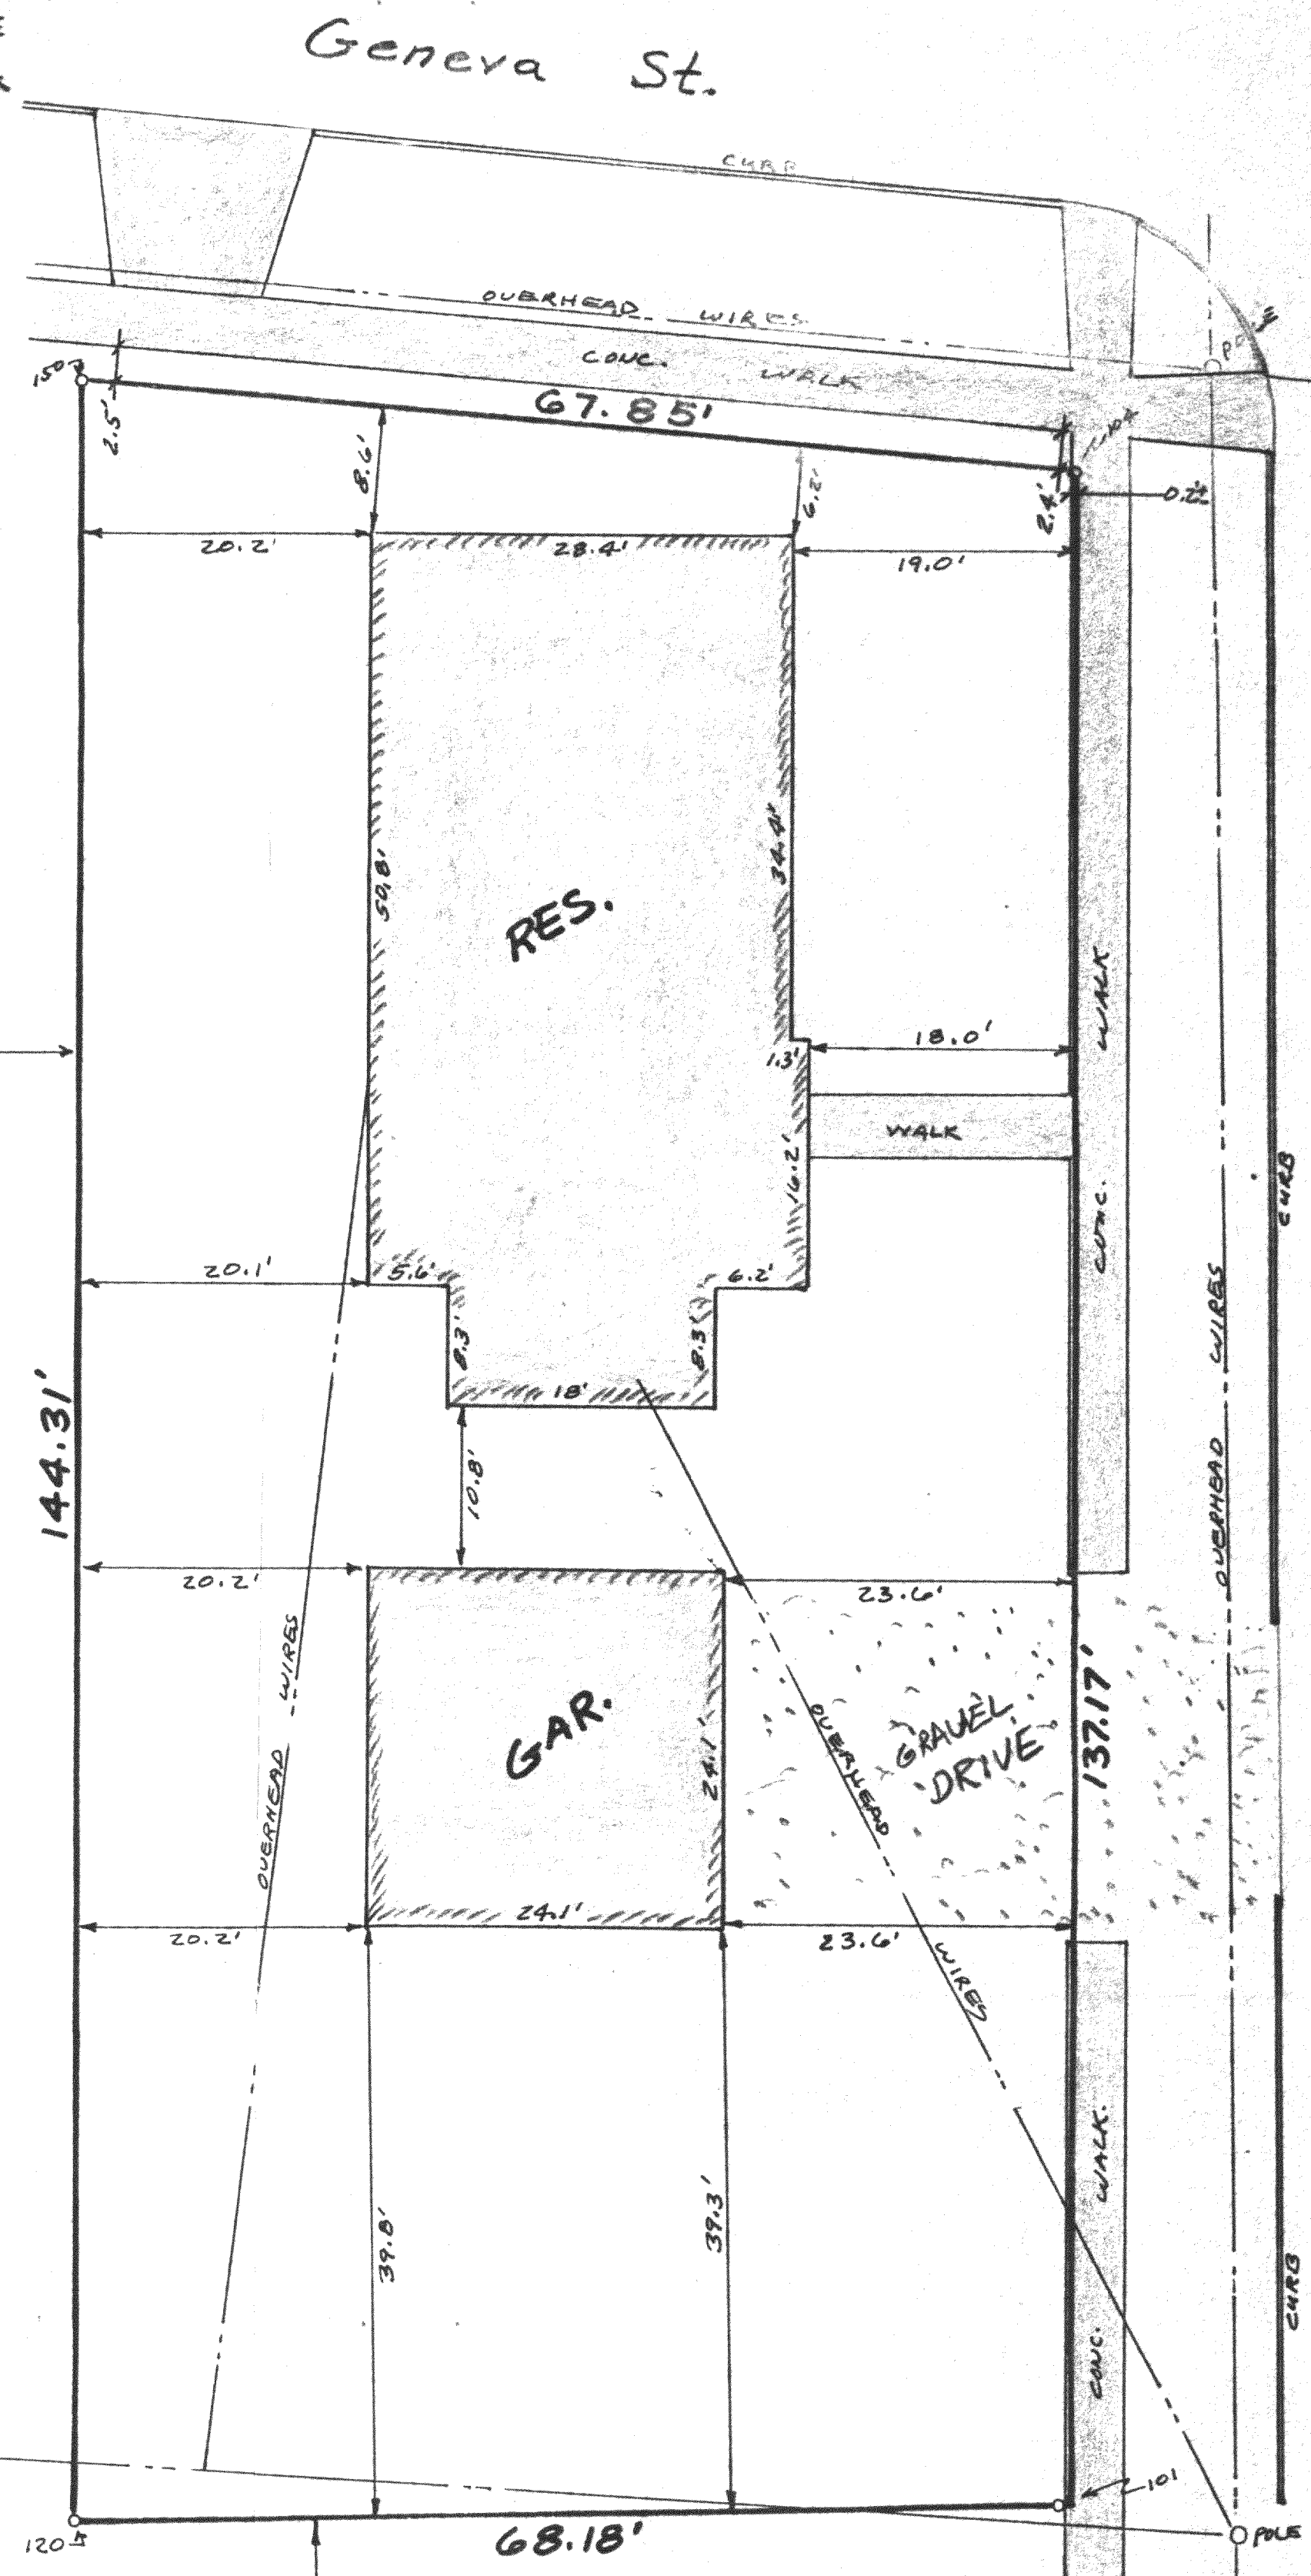

Wright St.

FARRIS, HANSEN & ASSOCIATES, INC.
Engineering, Architecture, Surveying
7 Ridgway Court, P.O. Box 457
ELKHORN, WISCONSIN 53121
Office: (414) 723-2098
Fax: (414) 723-5886

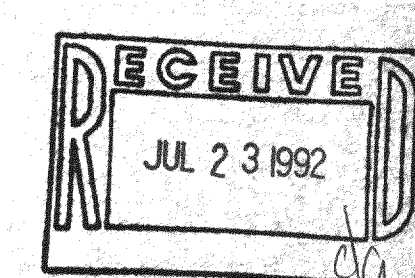

DOCUMENT NO. 234060

STATE BAR OF WISCONSIN FORM S-1000
PERSONAL REPRESENTATIVE'S DEED

VOL 570 PAGE 971

RECORDED IN VOL 570
PAGE 971

182 MAY 21 PM 2 33

LOIS M. KETTERHAGEN
REG. OF DEEDS
WALWORTH COUNTY, WIS.

for a valuable consideration, without warranty, to CHARLES S. STUBBS, GORDON D. STUBBS, and WILLIAM J. STUBBS, as tenants in common, the following described real estate in Walworth County, State of Wisconsin (hereinafter called the "Property"):

The East 1/2 of Lots 2 and 3 in Block 8 of Elderkin Addition to the City of Elkhorn, Walworth County, Wisconsin.

Tax Parcel No: YEK 00044

LEGAL DESCRIPTION OF
LANDS ORDERED SURVEYED

THIS CONVEYANCE IS EXEMPT FROM A WISCONSIN REAL ESTATE TRANSFER RETURN AND FEE UNDER 77.25 (11).

Personal Representative by this deed does convey to Grantee all of the estate and interest in the Property which the Decedent had immediately prior to Decedent's death, and all of the estate and interest in the Property which the Personal Representative has since acquired.

Dated this 18th day of May, 1992.

CHARLES S. STUBBS
Personal Representative

ACKNOWLEDGMENT

STATE OF WISCONSIN

County: Walworth

Personally came before me this 18th day of May, 1992, the above named


to me known to be the person who executed the foregoing instrument and acknowledge the same.

Notary Public

My Commission is permanent. (If not, state expiration date:)

I hereby certify that I have on this 22nd day of May, 1992, microphotographed the above document in accordance with standards established by Sec. 228.03 (1) of Statutes with established procedures. T. J. Meyer

ELDERKIN ADDITION
CITY OF ELKHORN
COPY PART OF TAX LISTOR'S MAP

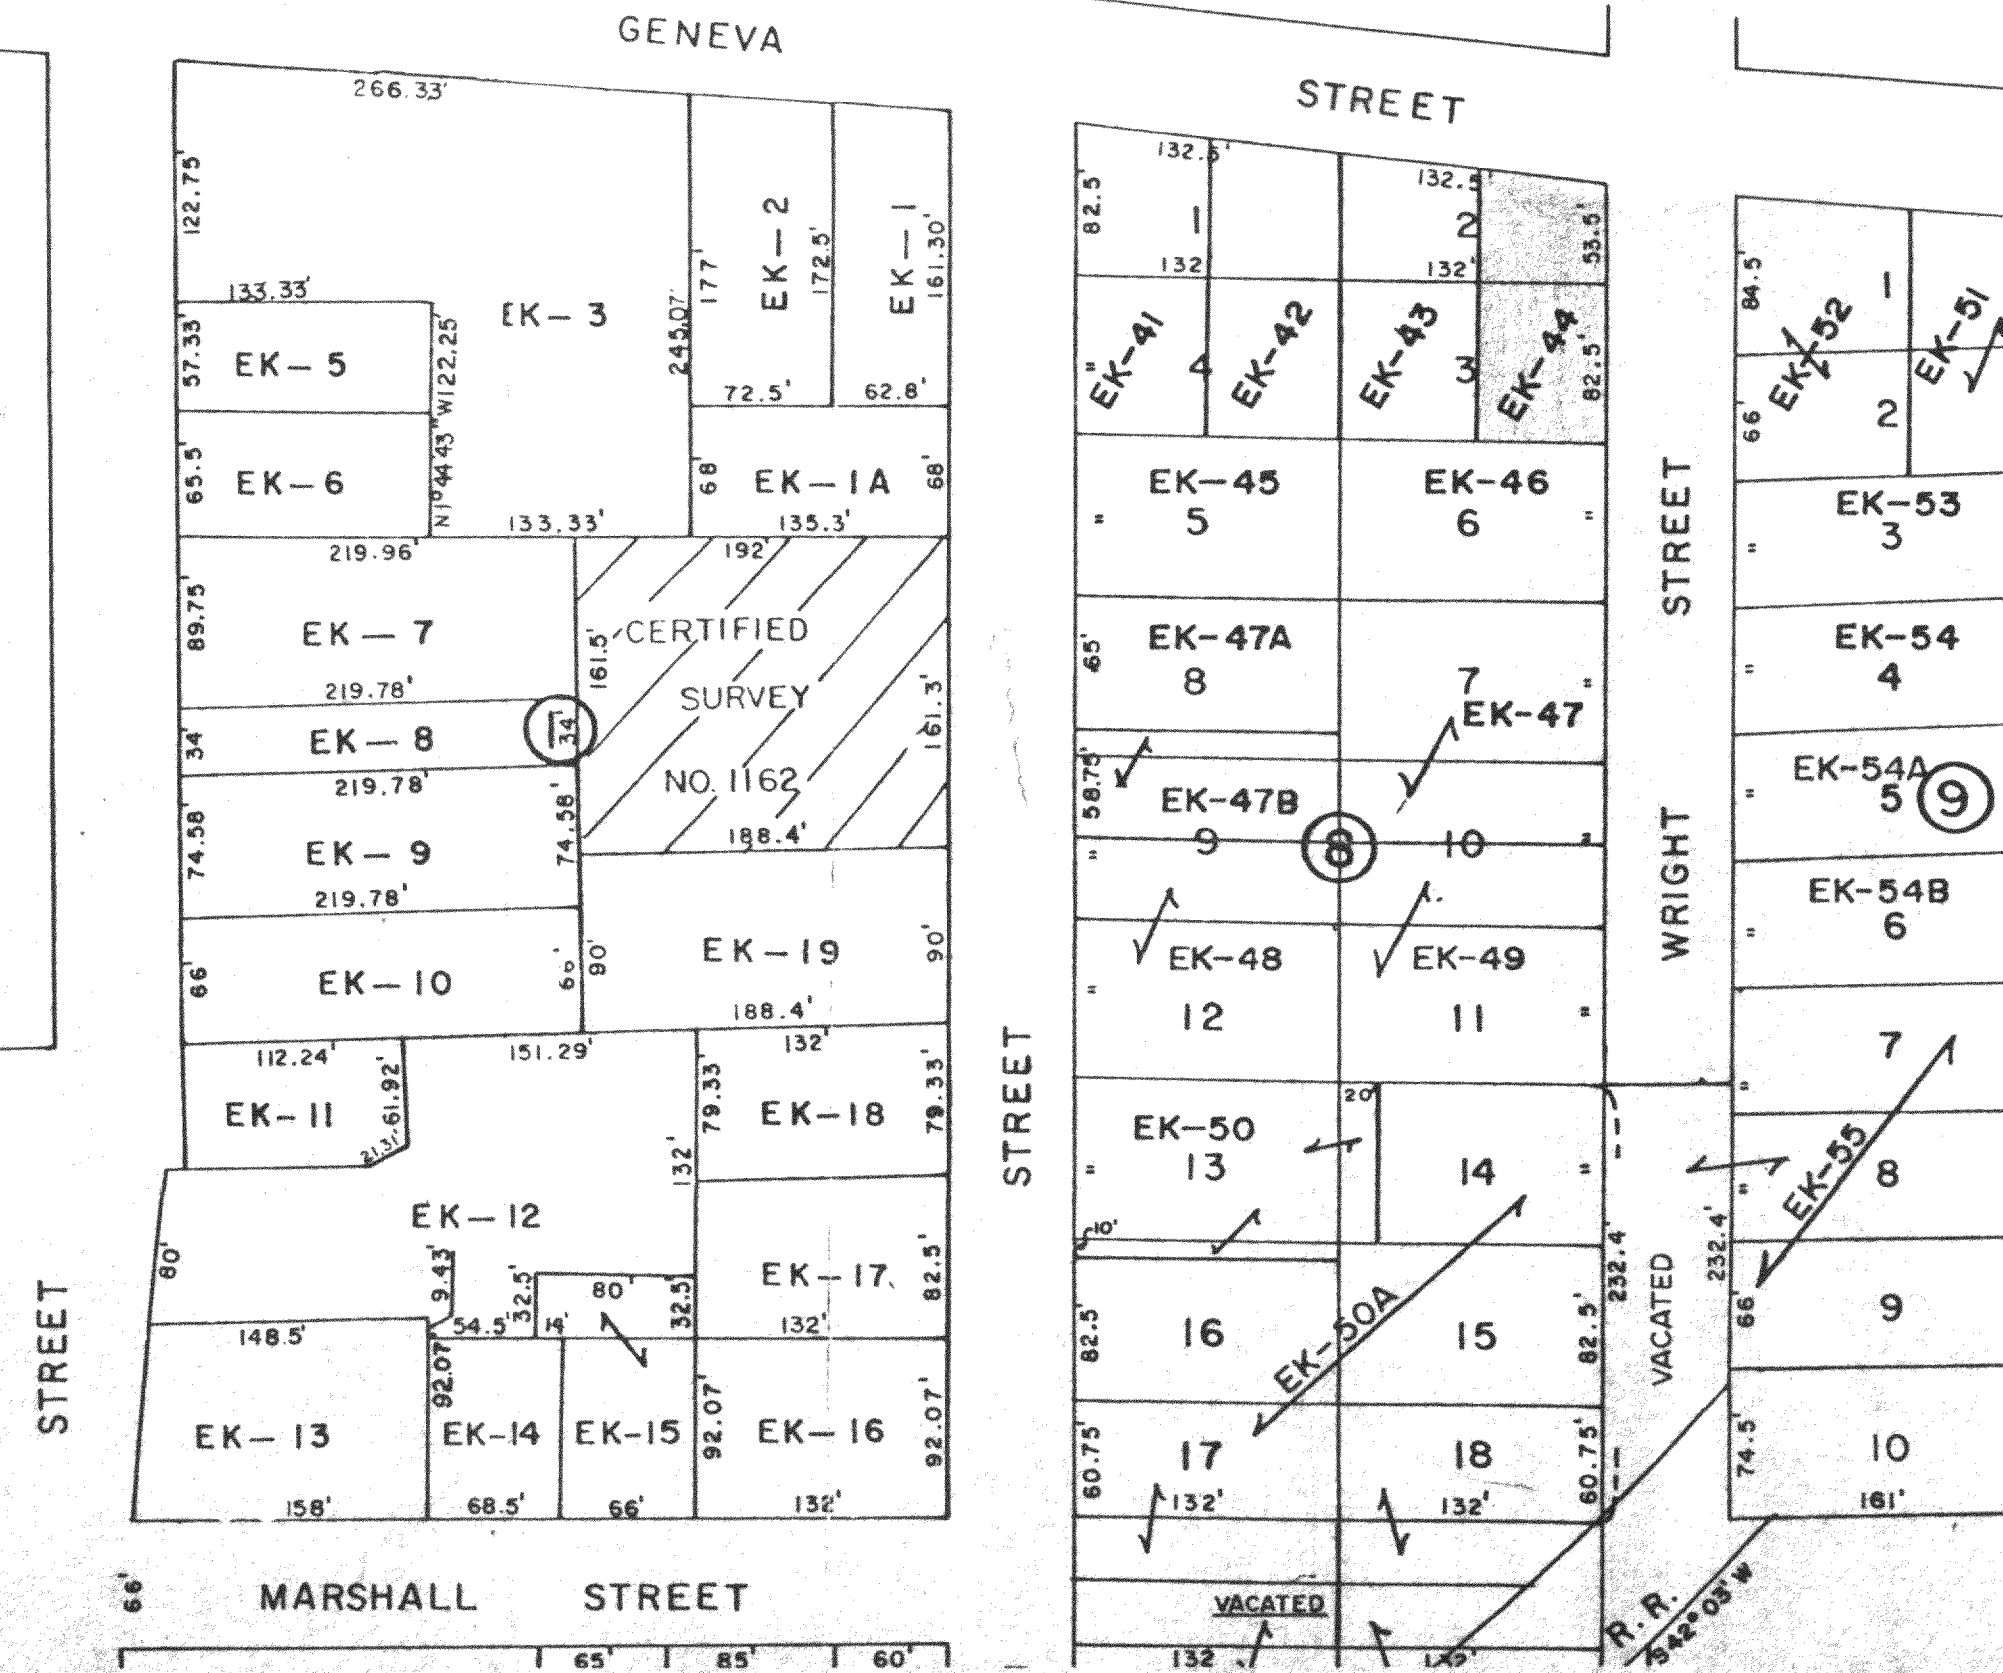

PLAT of SURVEY
for
CHARLES STUBBS

FIELD MEASUREMENTS MADE ON 6/22/92

DATE PLAT 7/10/92

DRAWN BY RAF

REVISIONS

CHECKED BY

APPROVED BY

PROJECT NO. 3671

LAST REVISION

SHEET NO. 1 of 1