


PLAT OF SURVEY

No. 5236

56-6  
5  
1  
1  
t

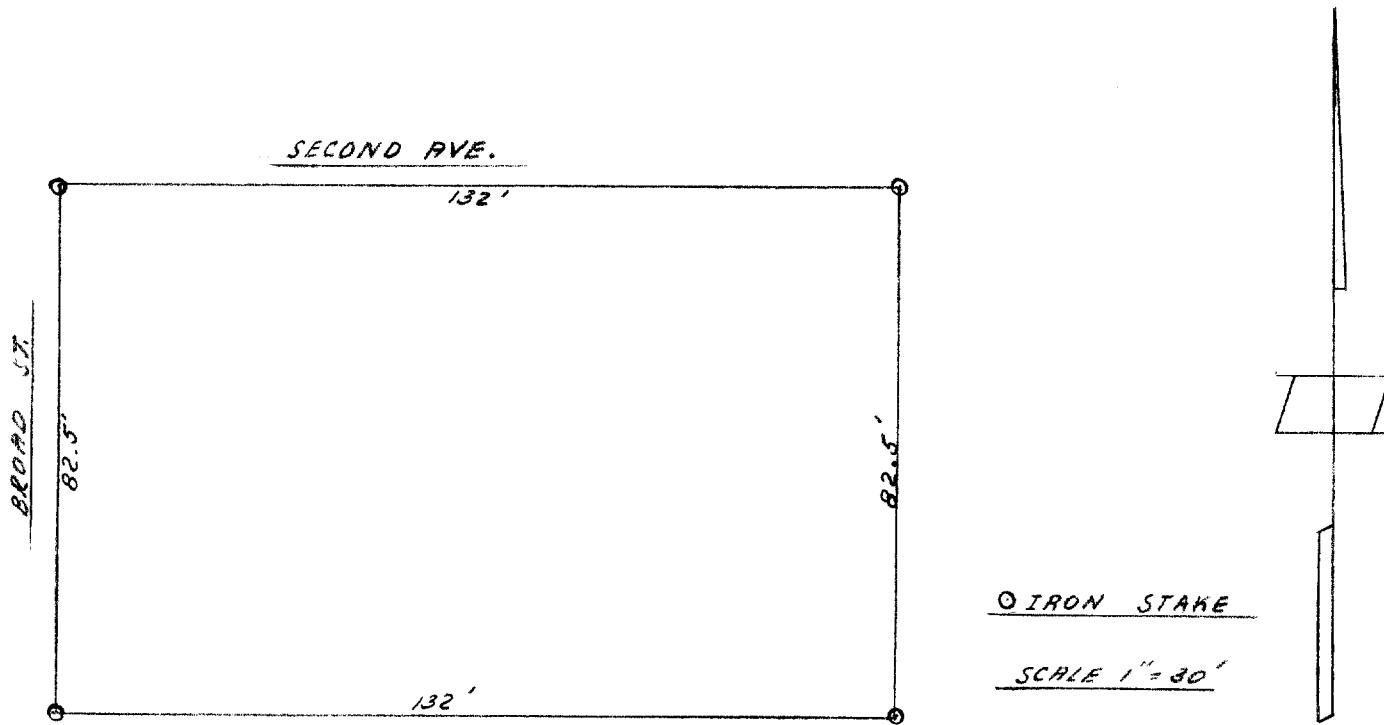


DESCRIPTION: Lot # 2 Block 40 of Davis Addition to the city of Elkorn, Walworth County, Wisconsin.

CERTIFICATE: I hereby certify that on this the 15th day of May 1956, I have surveyed the above described property, that the above description and drawing are accurate copies of said survey and in accordance with the records on file at the Register of Deeds office Walworth County, Wisconsin.

Stan Bader  
Surveyor

Reg. Land Surveyor No. 272

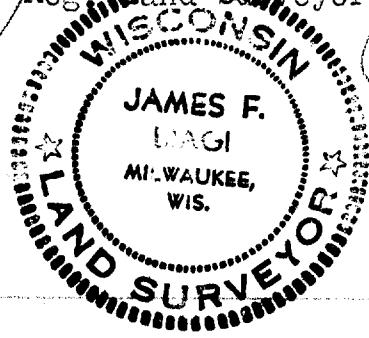

YD-34

4-72