


PLAT OF SURVEY


LOTS 3, 4, & SOUTH 1/2 LOT 2
BLOCK 50
ROCKWELL 2ND ADDITION TO THE CITY OF ELKHORN
WALWORTH COUNTY, WISCONSIN

LEGEND

- FOUND IRON PIPE STAKE
- FOUND IRON REBAR STAKE
- SET IRON REBAR STAKE
- (---) RECORDED AS

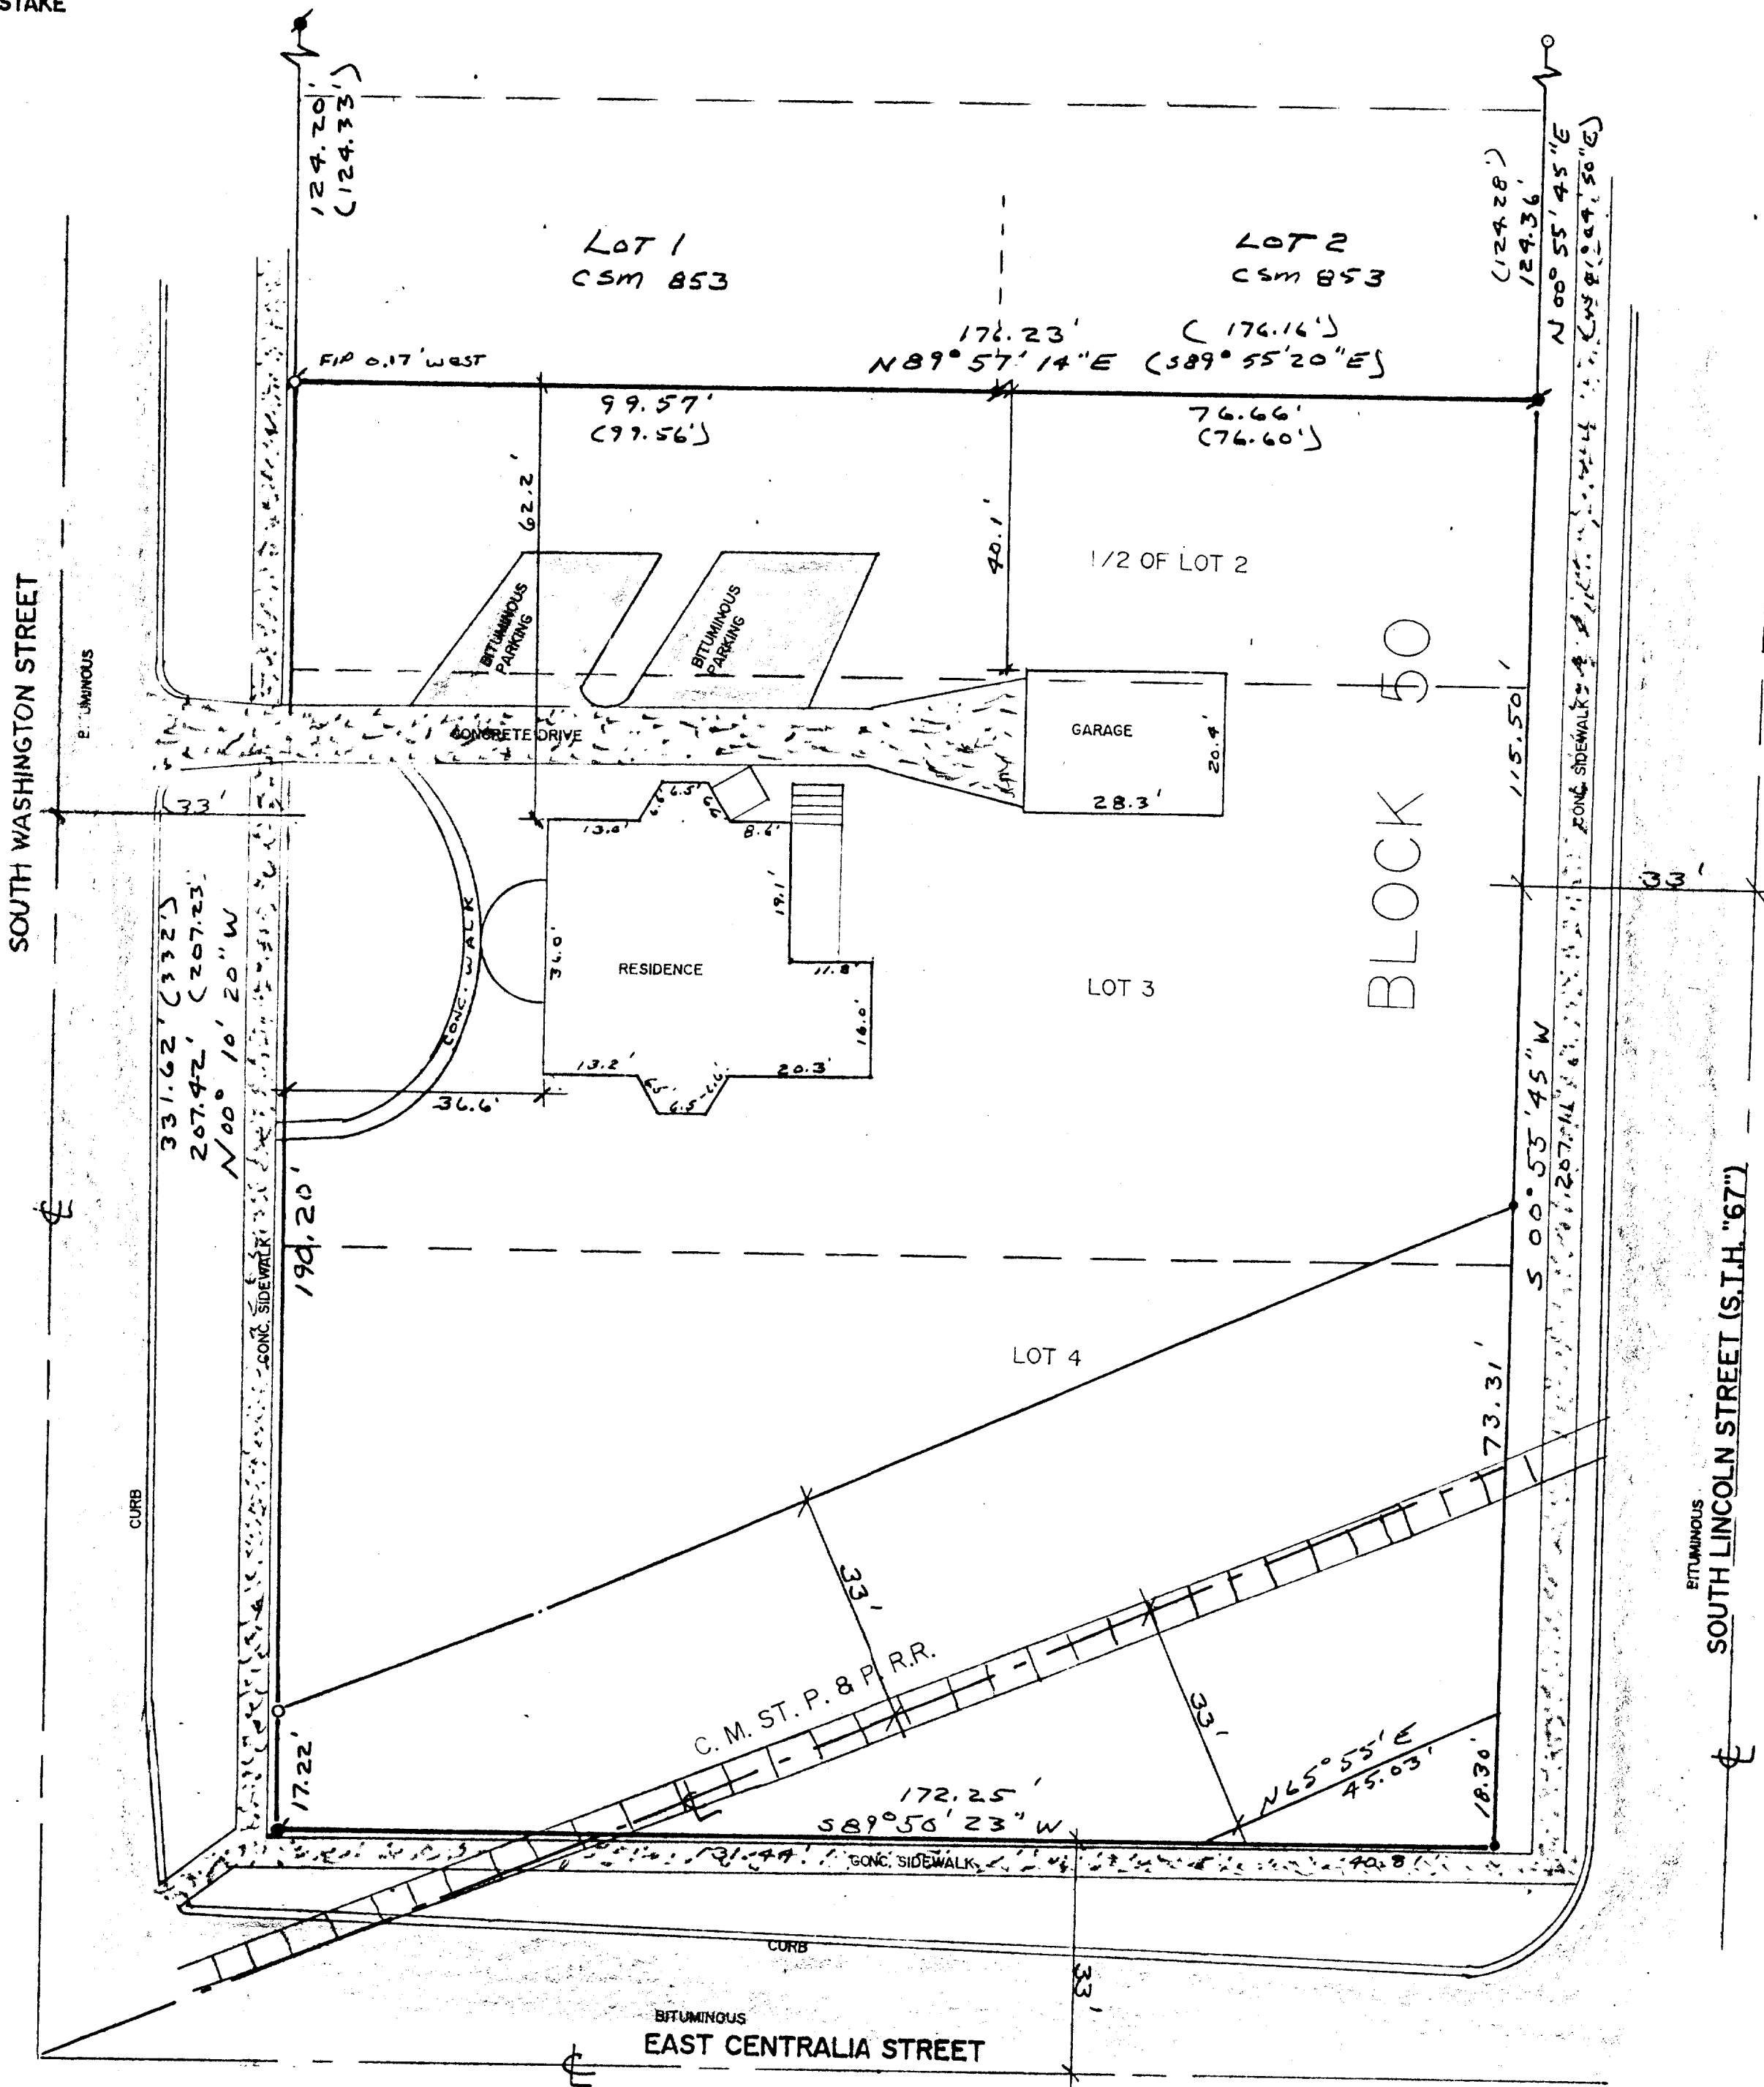


ASSIGNED NORTH LINE E. CENTRALIA ST.
S 89° 50' 23" W

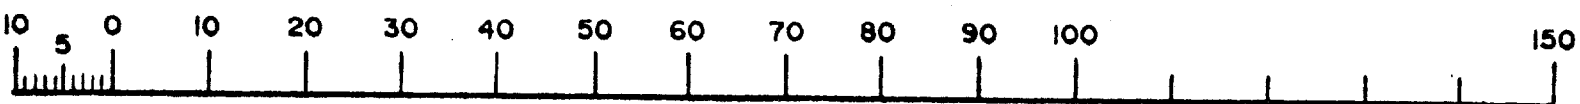

NOTE: COPIES OF THIS MAP TO WHICH THE FOLLOWING CERTIFICATE WILL APPLY ARE BLUE LINE PRINTS SHOWING SURVEYOR'S ORIGINAL SEAL AND SIGNATURE IN BLACK INK. COPIES BY ANY OTHER MEANS MAY HAVE ALTERATIONS WHICH DO NOT REPRESENT THE SURVEYOR'S WORK PRODUCT.

I HEREBY CERTIFY THAT THE ABOVE DESCRIBED PROPERTY HAS BEEN SURVEYED UNDER MY DIRECTION AND THAT THE ABOVE MAP IS A TRUE REPRESENTATION THEREOF AND SHOWS THE SIZE AND LOCATION OF THE PROPERTY AND ITS EXTERIOR BOUNDARIES. THIS SURVEY IS MADE FOR THE USE OF THE PRESENT OWNERS OF THE PROPERTY, AND ALSO THOSE WHO PURCHASE, MORTGAGE, OR GUARANTEE THE TITLE THERETO WITHIN ONE YEAR FROM THE DATE HEREOF.

DATED: 8/14/1992 *Peter S. Gordon*

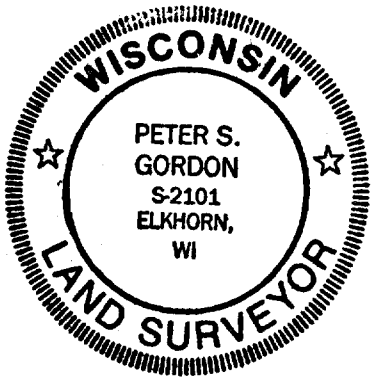

WORK ORDERED BY: JOHN PAPPAS

11689


VOL 174 PAGE 694

THIS DEED, made between Dolores Dankwardt, Assignee under Final Judgment estate Irene Brown, dated July 2, 1975

and John P. Pappas

Witnesseth, That the said Grantor for a valuable consideration Ten (\$10) dollars and other good and valuable consideration conveys to Grantee the following described real estate in Walworth County, State of Wisconsin:

Lots 3 and 4 and the South one-half (S1/2) of Lot 2, Block 50, Rockwell 2nd Addition to the City of Elkhorn, Walworth County, Wisconsin, Excepting therefrom any and all rights which the Western Railroad Company may have in said property.

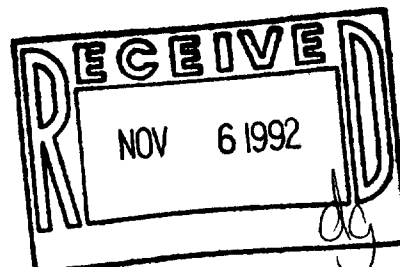

FARRIS, HANSEN & ASSOCIATES, INC.
Engineering, Architecture, Surveying
7 Ridgway Court P.O. Box 437
ELKHORN, WISCONSIN 53121
Office: (414) 723-2098
Fax: (414) 723-5886

REVISIONS

PROJECT NO
3697
DATE
8/14/92
SHEET NO.
1 OF 1