

SURVEY MAP OF THE SHAW PROPERTY

BEING PART OF BLOCK 1, ELDERKIN ADDITION, CITY OF ELKHORN, WALWORTH COUNTY - STATE OF WISCONSIN, ALSO

In the NW $\frac{1}{4}$ -NW $\frac{1}{4}$ of Section 6, T2N, R17E and in the SW $\frac{1}{4}$ -SW $\frac{1}{4}$ of Section 31, T3N, R17E, 4TH PM.

+ 247 800.00

E. Geneva Street

S. Lincoln Street (Hwy 67)

S. Jackson Street

Scale 1" = 30'

Survey based on the State Plane Coordinates of the NW, the N $\frac{1}{4}$ and the W $\frac{1}{4}$ corners of Section 6, T2N, R17E


Legend

- Corner monument, nature as indicated.
- Indicates a line not surveyed to the side of the dotted end, for information only.
- + Indicate State Plane Coord. grid corners.
- EK-2 Indicates the parcel Tax Number.

This survey is made at the request of Mr and Mrs Harry SHAW, 130 S. Jackson Street in Elkhorn, for the purpose of selling the property and is valid for that purpose only. It represents the situation as found at the time of the survey. The most likely deed lines from the description dated back to October 28, 1885 are represented for information only.

Surveyed and Mapped by Albert E. PENNEQUIN
a Wisconsin Registered Land Surveyor.

This November 8, 1986.

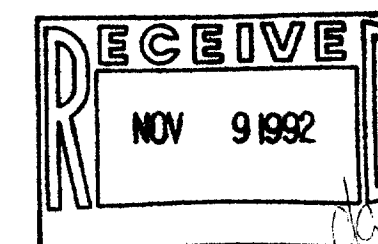

VEK-1
VEK-1A
VEK-2
VEK-3

2,392 300.00
+ 247 300.00
State Plane Coordinates Grid

2,392 600.00


2,392 900.00

SURVEY MAP OF THE SHAW PROPERTY

BEING PART OF BLOCK 1, ELDERKIN ADDITION, CITY OF ELKHORN, WALWORTH COUNTY - STATE OF WISCONSIN, ALSO

In the NW¼-NW¼ of Section 6, T2N, R17E and in the SW¼-SW¼ of Section 31, T3N, R17E, 4TH P.M.

E. Geneva Street

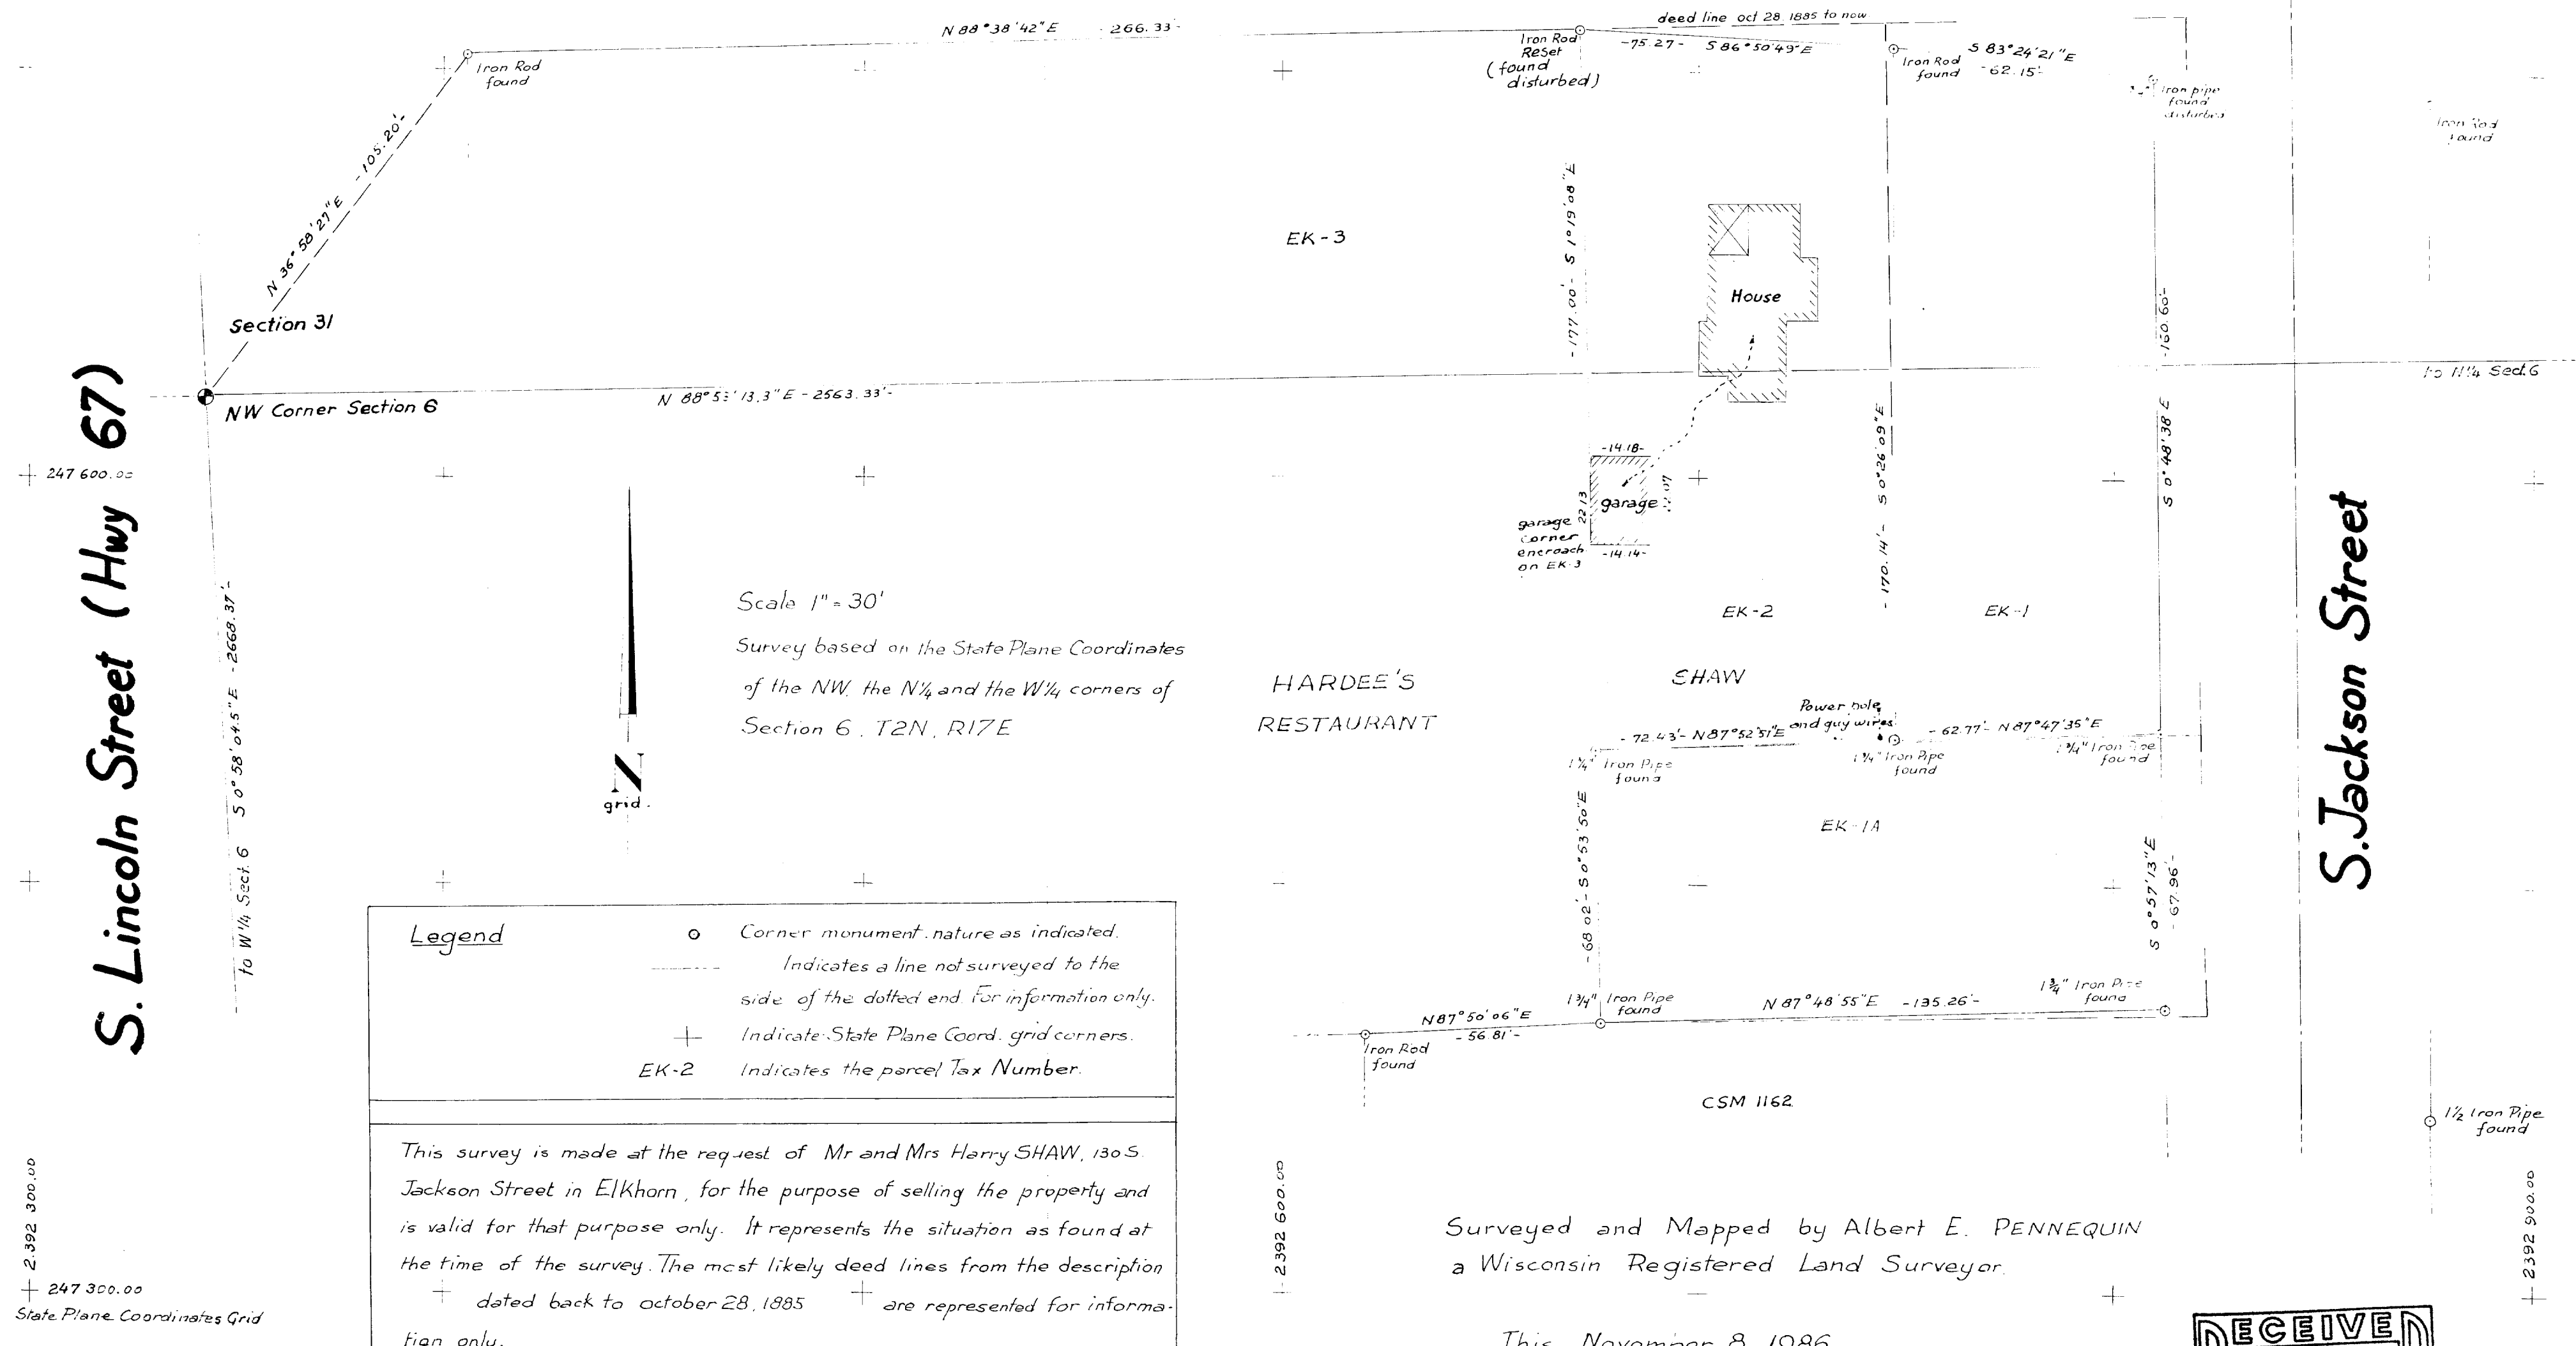

Surveyed and Mapped by Albert E. PENNEQUIN
a Wisconsin Registered Land Surveyor.

This November 8, 1986.

