


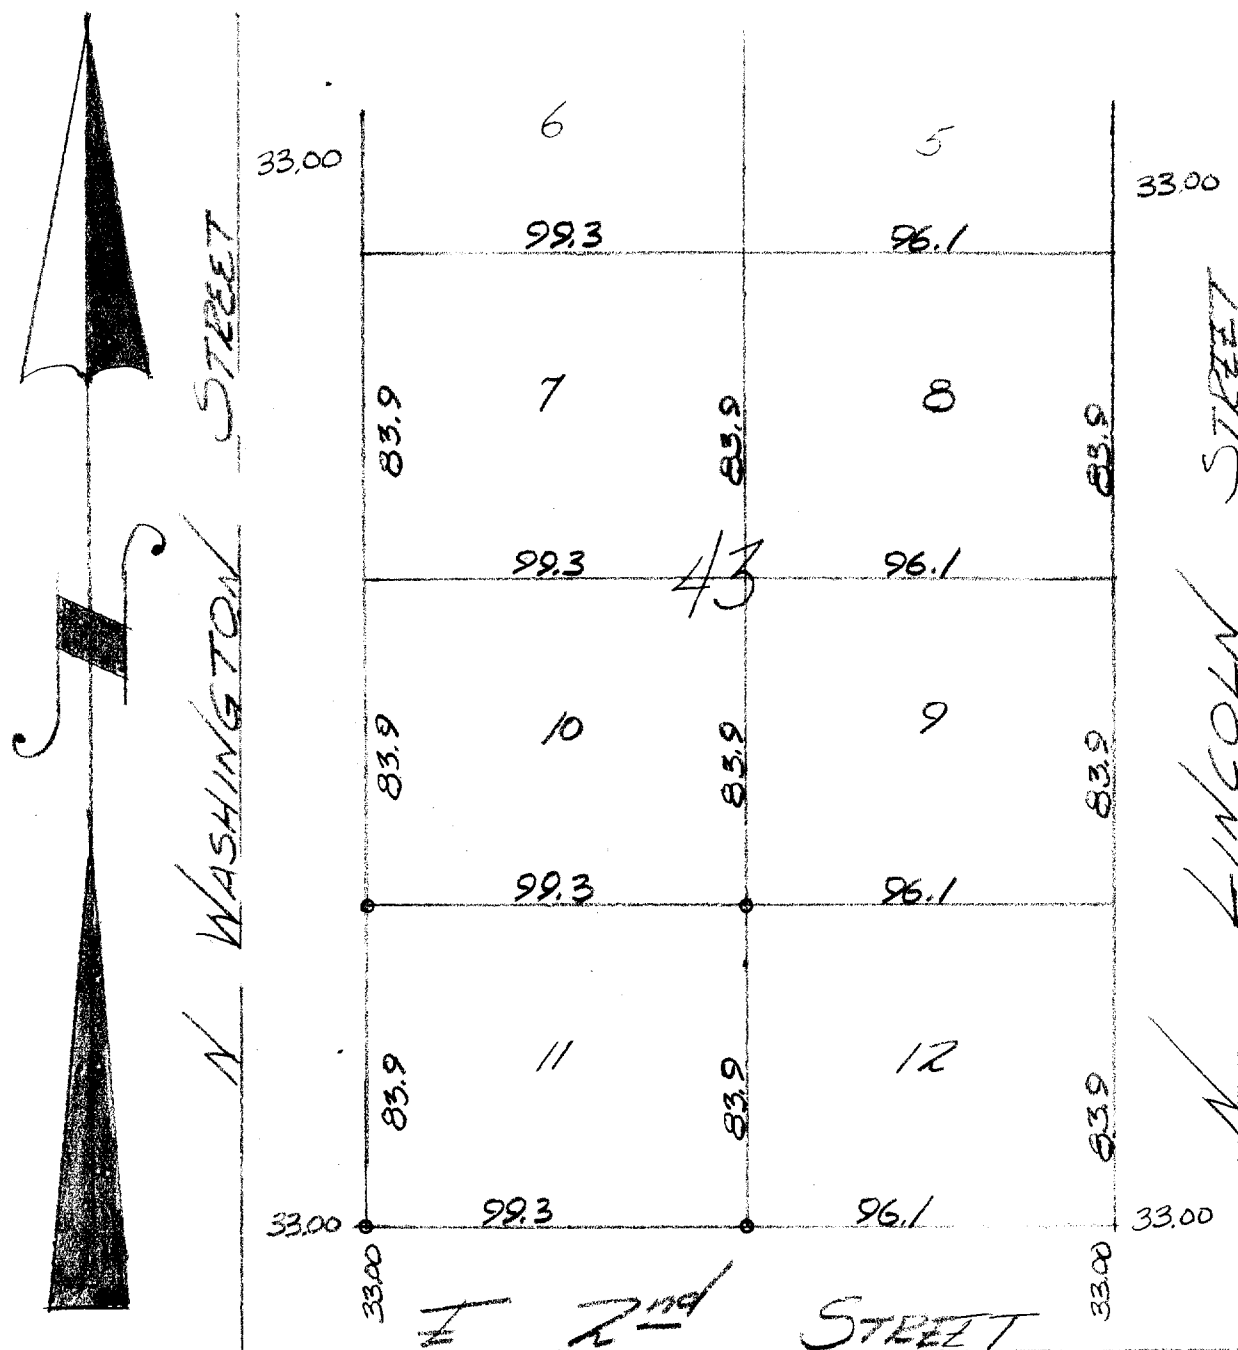

• - Indicates Iron Stake

DESCRIPTION: Lot 11 of Block 43 of Davis Addition to the City of Elkhorn, Walworth County, Wisconsin.

CERTIFICATE: I hereby certify that I have, on this 31 day of October 1958, surveyed the property described and shown above in accordance with the records on file in the Register of Deeds office.

SIGNED AND SEALED 1 November, 1958

*James H. Biagi*