


PLAT OF SURVEY & SITE GRADING PLAN

LOT 1 OF URBANDALE SUBDIVISION
CITY OF ELKHORN
SECTION 1, TOWN 2 NORTH, RANGE 16 EAST
WALWORTH COUNTY, WISCONSIN

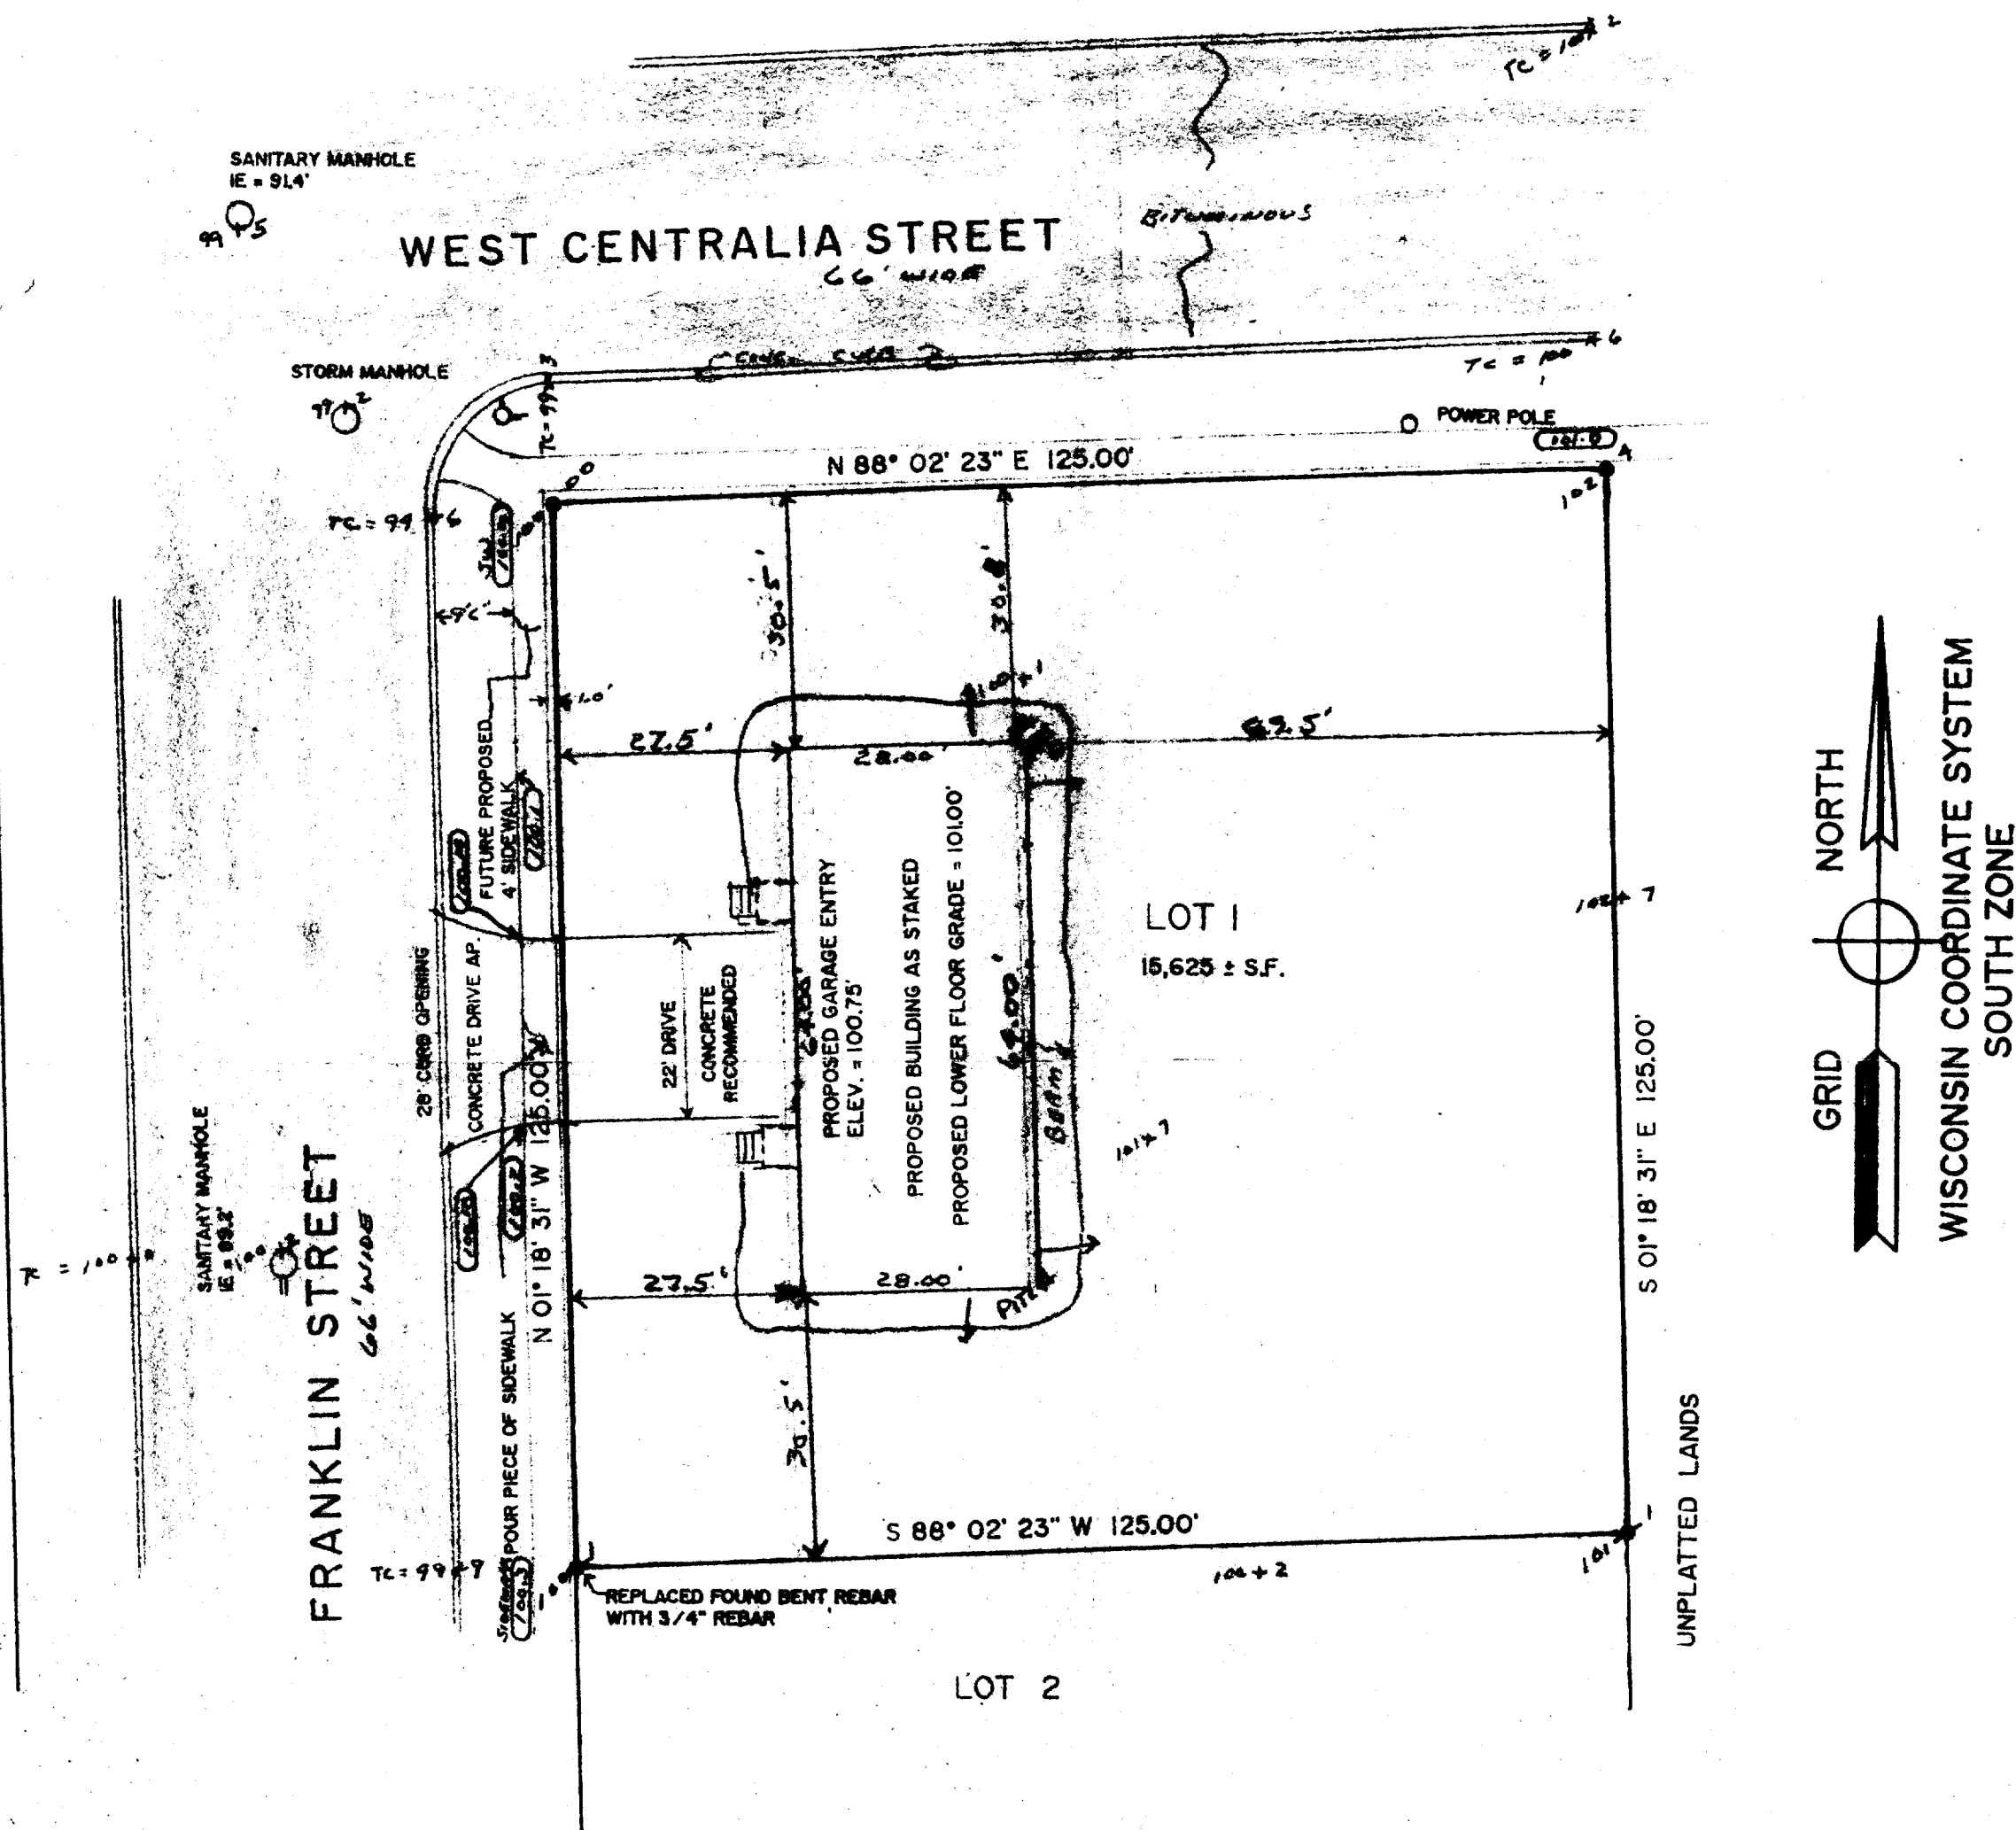

NOTE

BENCHMARK ASSIGNED TOP OF FOUND IRON REBAR STAKE
NW CORNER AS 100.00'
SET 10' OFFSET HUBS TO NEW BUILDING CORNERS ON WEST
8.5' OFFSET HUBS TO EAST

LEGEND




- FOUND IRON REBAR STAKE 1 3/16" DIA
- FOUND IRON REBAR STAKE 3/4" DIA
- PROPOSED FINISHED GRADE

NOTE: COPIES OF THIS MAP TO WHICH THE FOLLOWING CERTIFICATE WILL
APPLY ARE BLUE LINE PRINTS SHOWING SURVEYOR'S ORIGINAL SEAL AND
SIGNATURE IN BLACK INK. COPIES BY ANY OTHER MEANS MAY HAVE
ALTERATIONS WHICH DO NOT REPRESENT THE SURVEYOR'S WORK PRODUCT.

I HEREBY CERTIFY THAT THIS PLAT OF SURVEY IS A TRUE AND ACCURATE
REPRESENTATION OF THE BOUNDARY LINES OF THE SUBJECT PARCEL AND
SHOWS THE SIZE AND LOCATION OF THE PROPOSED BUILDING AS STAKED ON
THE PARCEL SHOWN HEREON, TO THE BEST OF MY PROFESSIONAL KNOWLEDGE
AND BELIEF. THIS SURVEY IS MADE FOR THE USE OF THE PRESENT OWNERS
OF THE PROPERTY, AND ALSO THOSE WHO PURCHASE, MORTGAGE, OR
GUARANTEE THE TITLE THERETO WITHIN ONE YEAR FROM THE DATE HEREOF.

DATED: 11/06/92
REVISION: 11/09/92

PETER S. GORDON RLS 2101

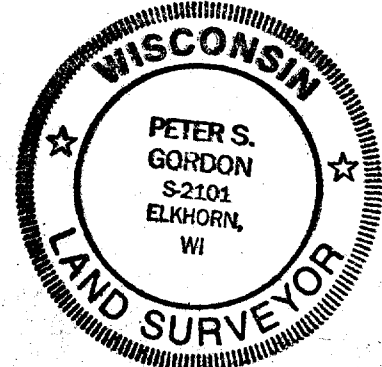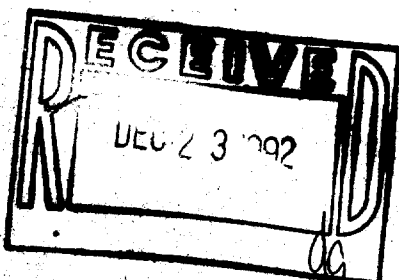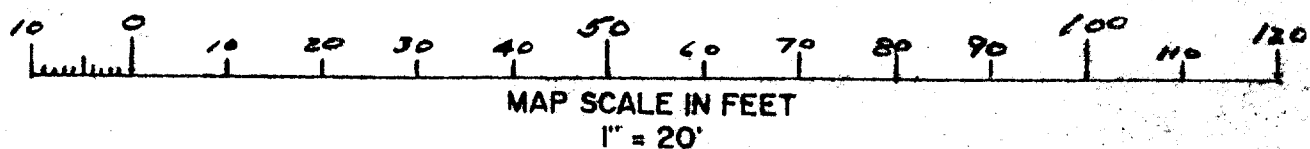

SURVEY AND SITE GRADING PLAN
LOT 1 URBANDALE SUB.
CITY OF ELKHORN
SECTION 1, TOWN 2 NORTH, RANGE 16 EAST
WALWORTH COUNTY, WISCONSIN

FARRIS, HANSEN & ASSOCIATES, INC.
Engineering, Architecture, Surveying
7 Ridgway Court P.O. Box 437
ELKHORN, WISCONSIN 53121
Office: (414) 723-2098
Fax: (414) 723-5886

REVISIONS

11/09/92
RESTATE
BLOCK 1.5' EAST

PROJECT NO

3747

DATE

11/06/92

SHEET NO

141

WORK ORDERED BY: FREDRICK STEELE

004-768