


NORTH WISCONSIN ST.

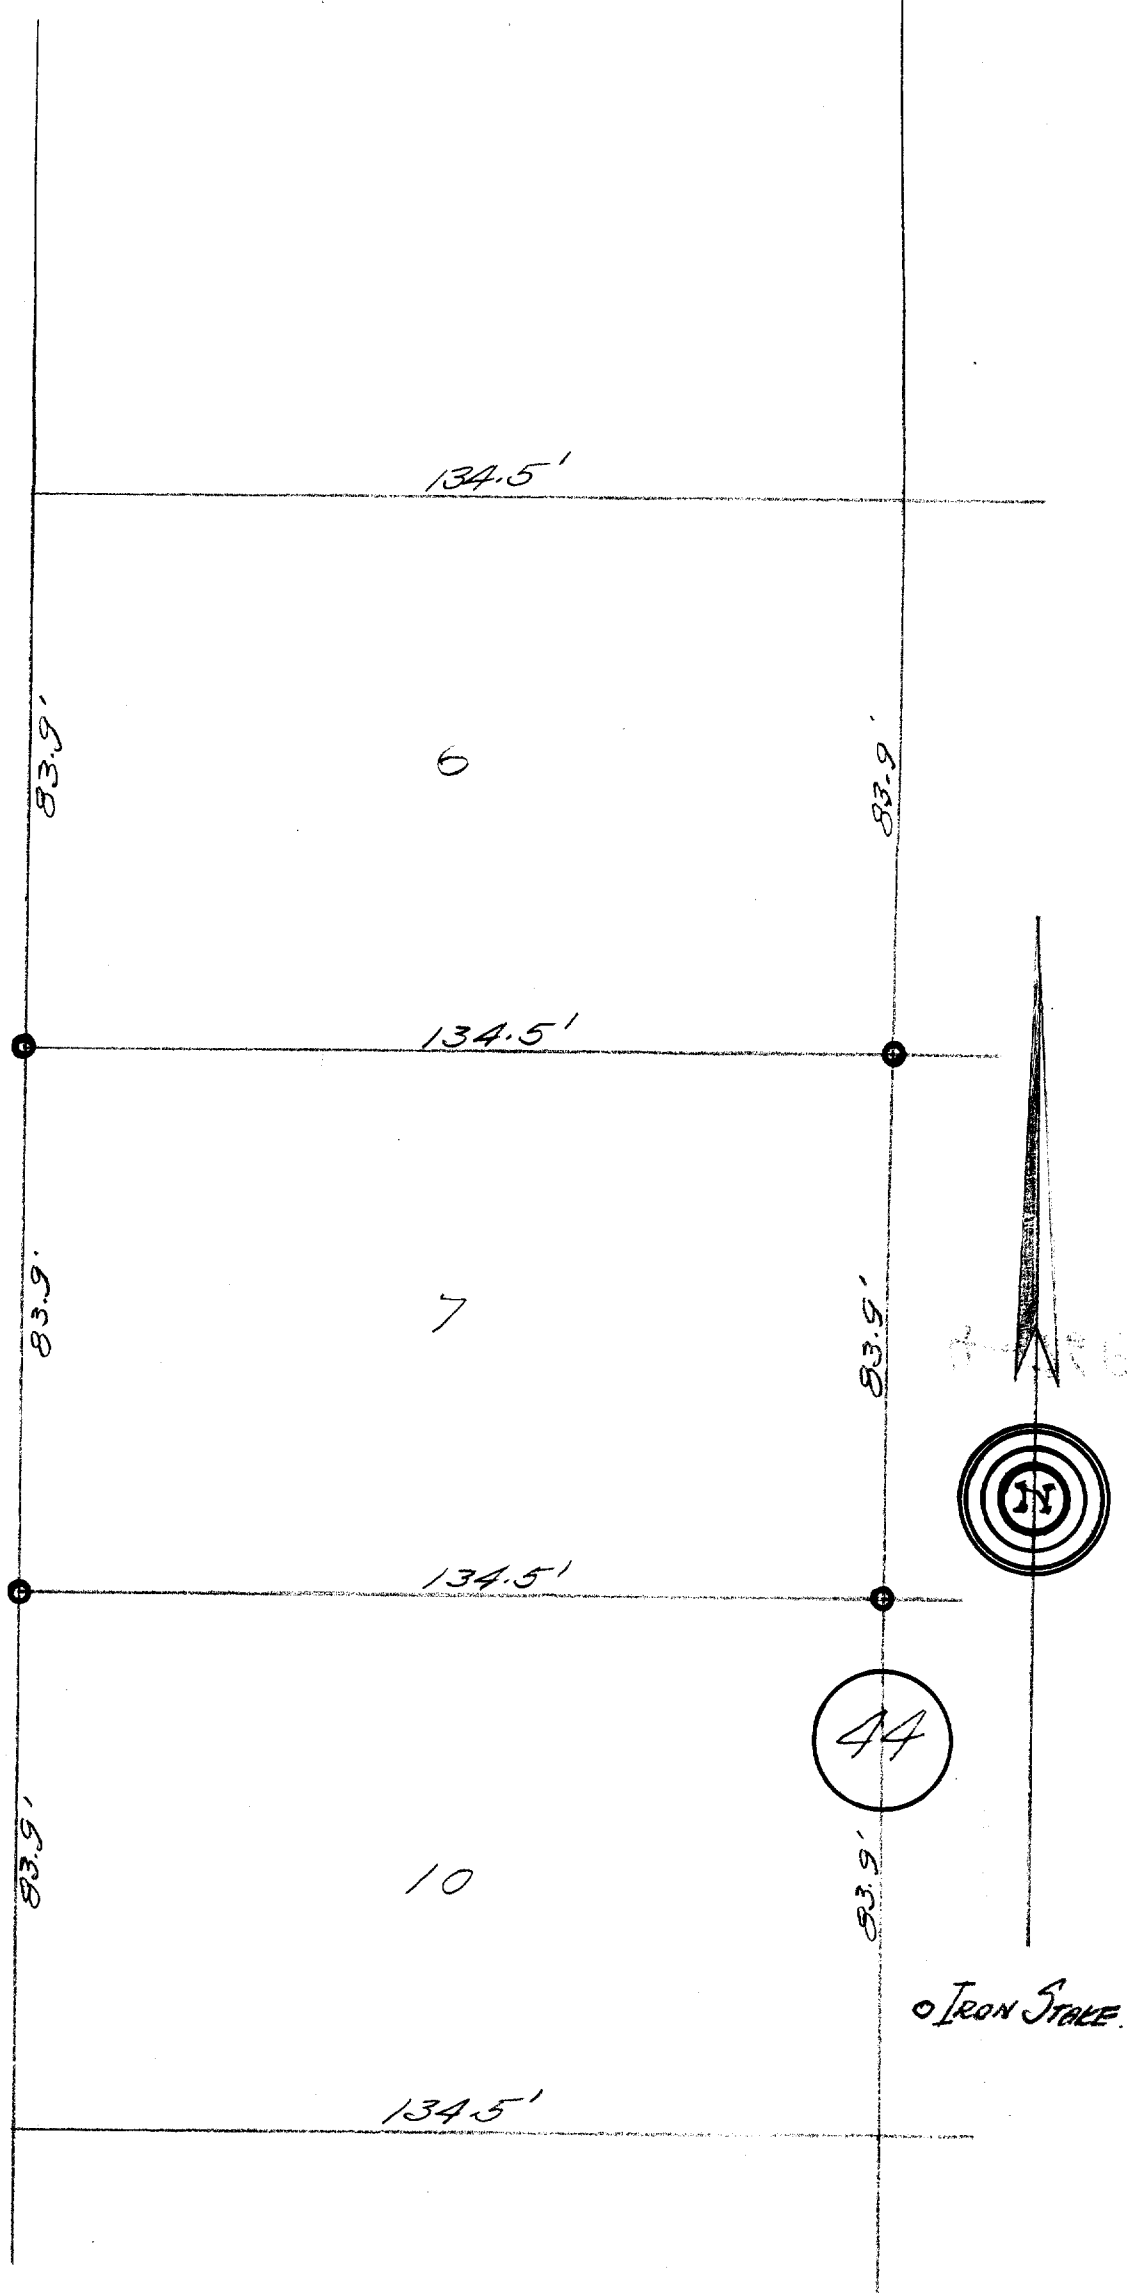

DESCRIPTION:

Lot 7, Block 44 Davis Addition to the City of Elkhorn, Walworth County, Wisconsin.

CERTIFICATE:

I, hereby certify that I have on this the 16th day of May 1949, surveyed the above described property according to the official record on file in the office of the Recorder of Deeds in and for Walworth County, Wisconsin, and find that the measurements and bearings of the boundary lines of said property as taken at the site on this day, substantially agree with those in said official record and that no encroachments exist

SIGNED AND SEALED THIS 18TH DAY OF MAY 1949.

Joseph M. Biagi. Professional Engineer.
Elkhorn Wisconsin.