



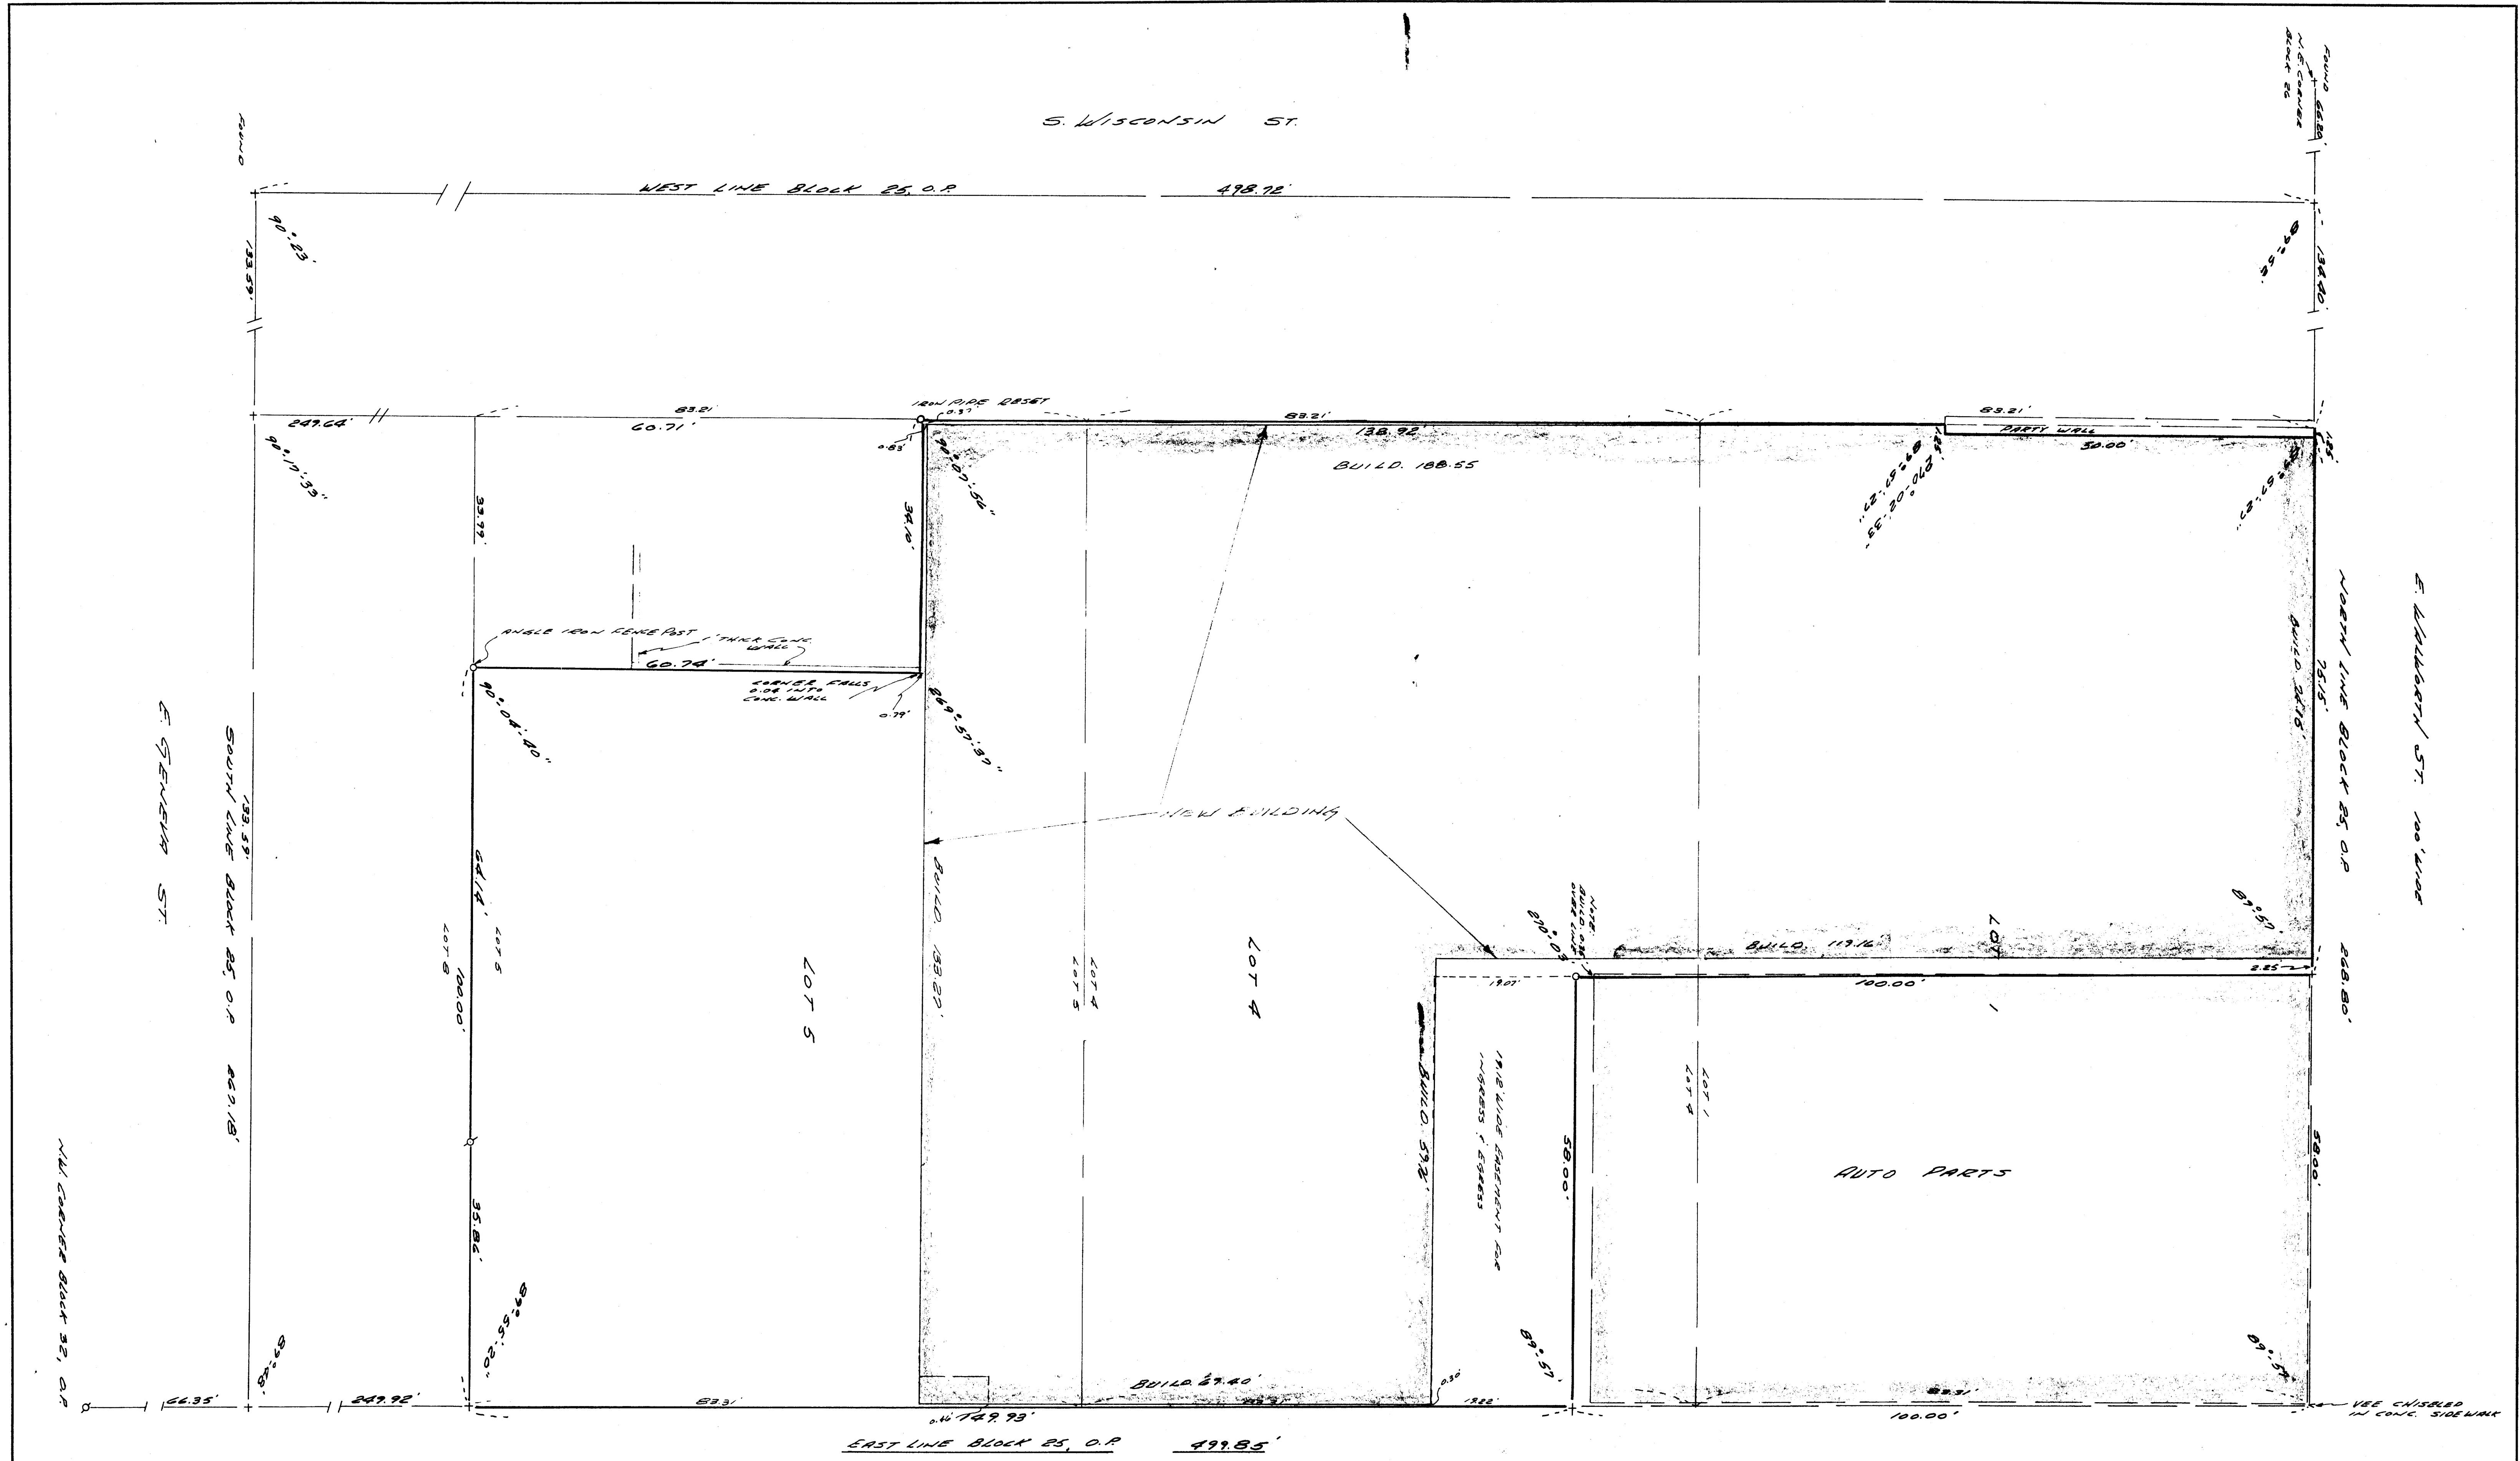

WE CERTIFY THAT WE HAVE SURVEYED THE ABOVE DESCRIBE PROPERTY & THAT THE PLAT SHOWN HEREON IS AN ACCURATE SURVEY AND A TRUE REPRESENTATION THEREOF & CORRECTLY SHOWS THE EXTERIOR BOUNDARY LINES AND DIVISIONS OF SAID PROPERTY AND THE LOCATION OF ALL BUILDINGS ON SAID PROPERTY. JUNE 1972

Lloyd L. Jensen
LLOYD L. JENSEN
SURVEYOR 5-211

S. WASHINGTON ST.

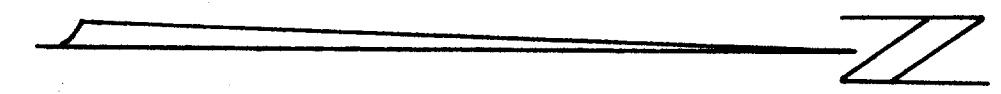

+ - CHISEL CROSS CUT IN CONC. WALK
X - IRON PIPE FOUND
O - IRON PIPE SET
NOTE:
THE ESTABLISHMENT OF ALL BLOCK CORNERS IN ORIGINAL PLAT ARE BASED ON AVAILABLE RECORDS IN THE CITY ENGINEERS' OFFICE. UNDER RUN & OVER RUN OF LOT & BLOCK DISTANCES WERE ESTABLISHED FROM SAID RECORDS.



PLAT OF SURVEY OF PART OF LOTS 4, 5, BLOCK 25, ORIGINAL PLAT, CITY OF ELKHORN, WASHINGTON COUNTY, WISCONSIN.		
DRAWN BY F.R. JENSEN	JENSEN & JOHNSON CIVIL ENGINEERS ELKHORN, WIS. DATE JULY 1971	SCALE: 1" = 10'
CHECKED BY Lloyd L. Jensen		REVISED
APPROVED BY		SHEET NO. 1 OF 1

REVISED DATE 1972
Lloyd L. Jensen 4-765