
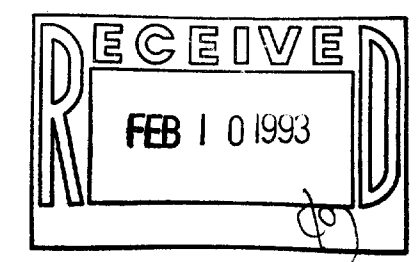
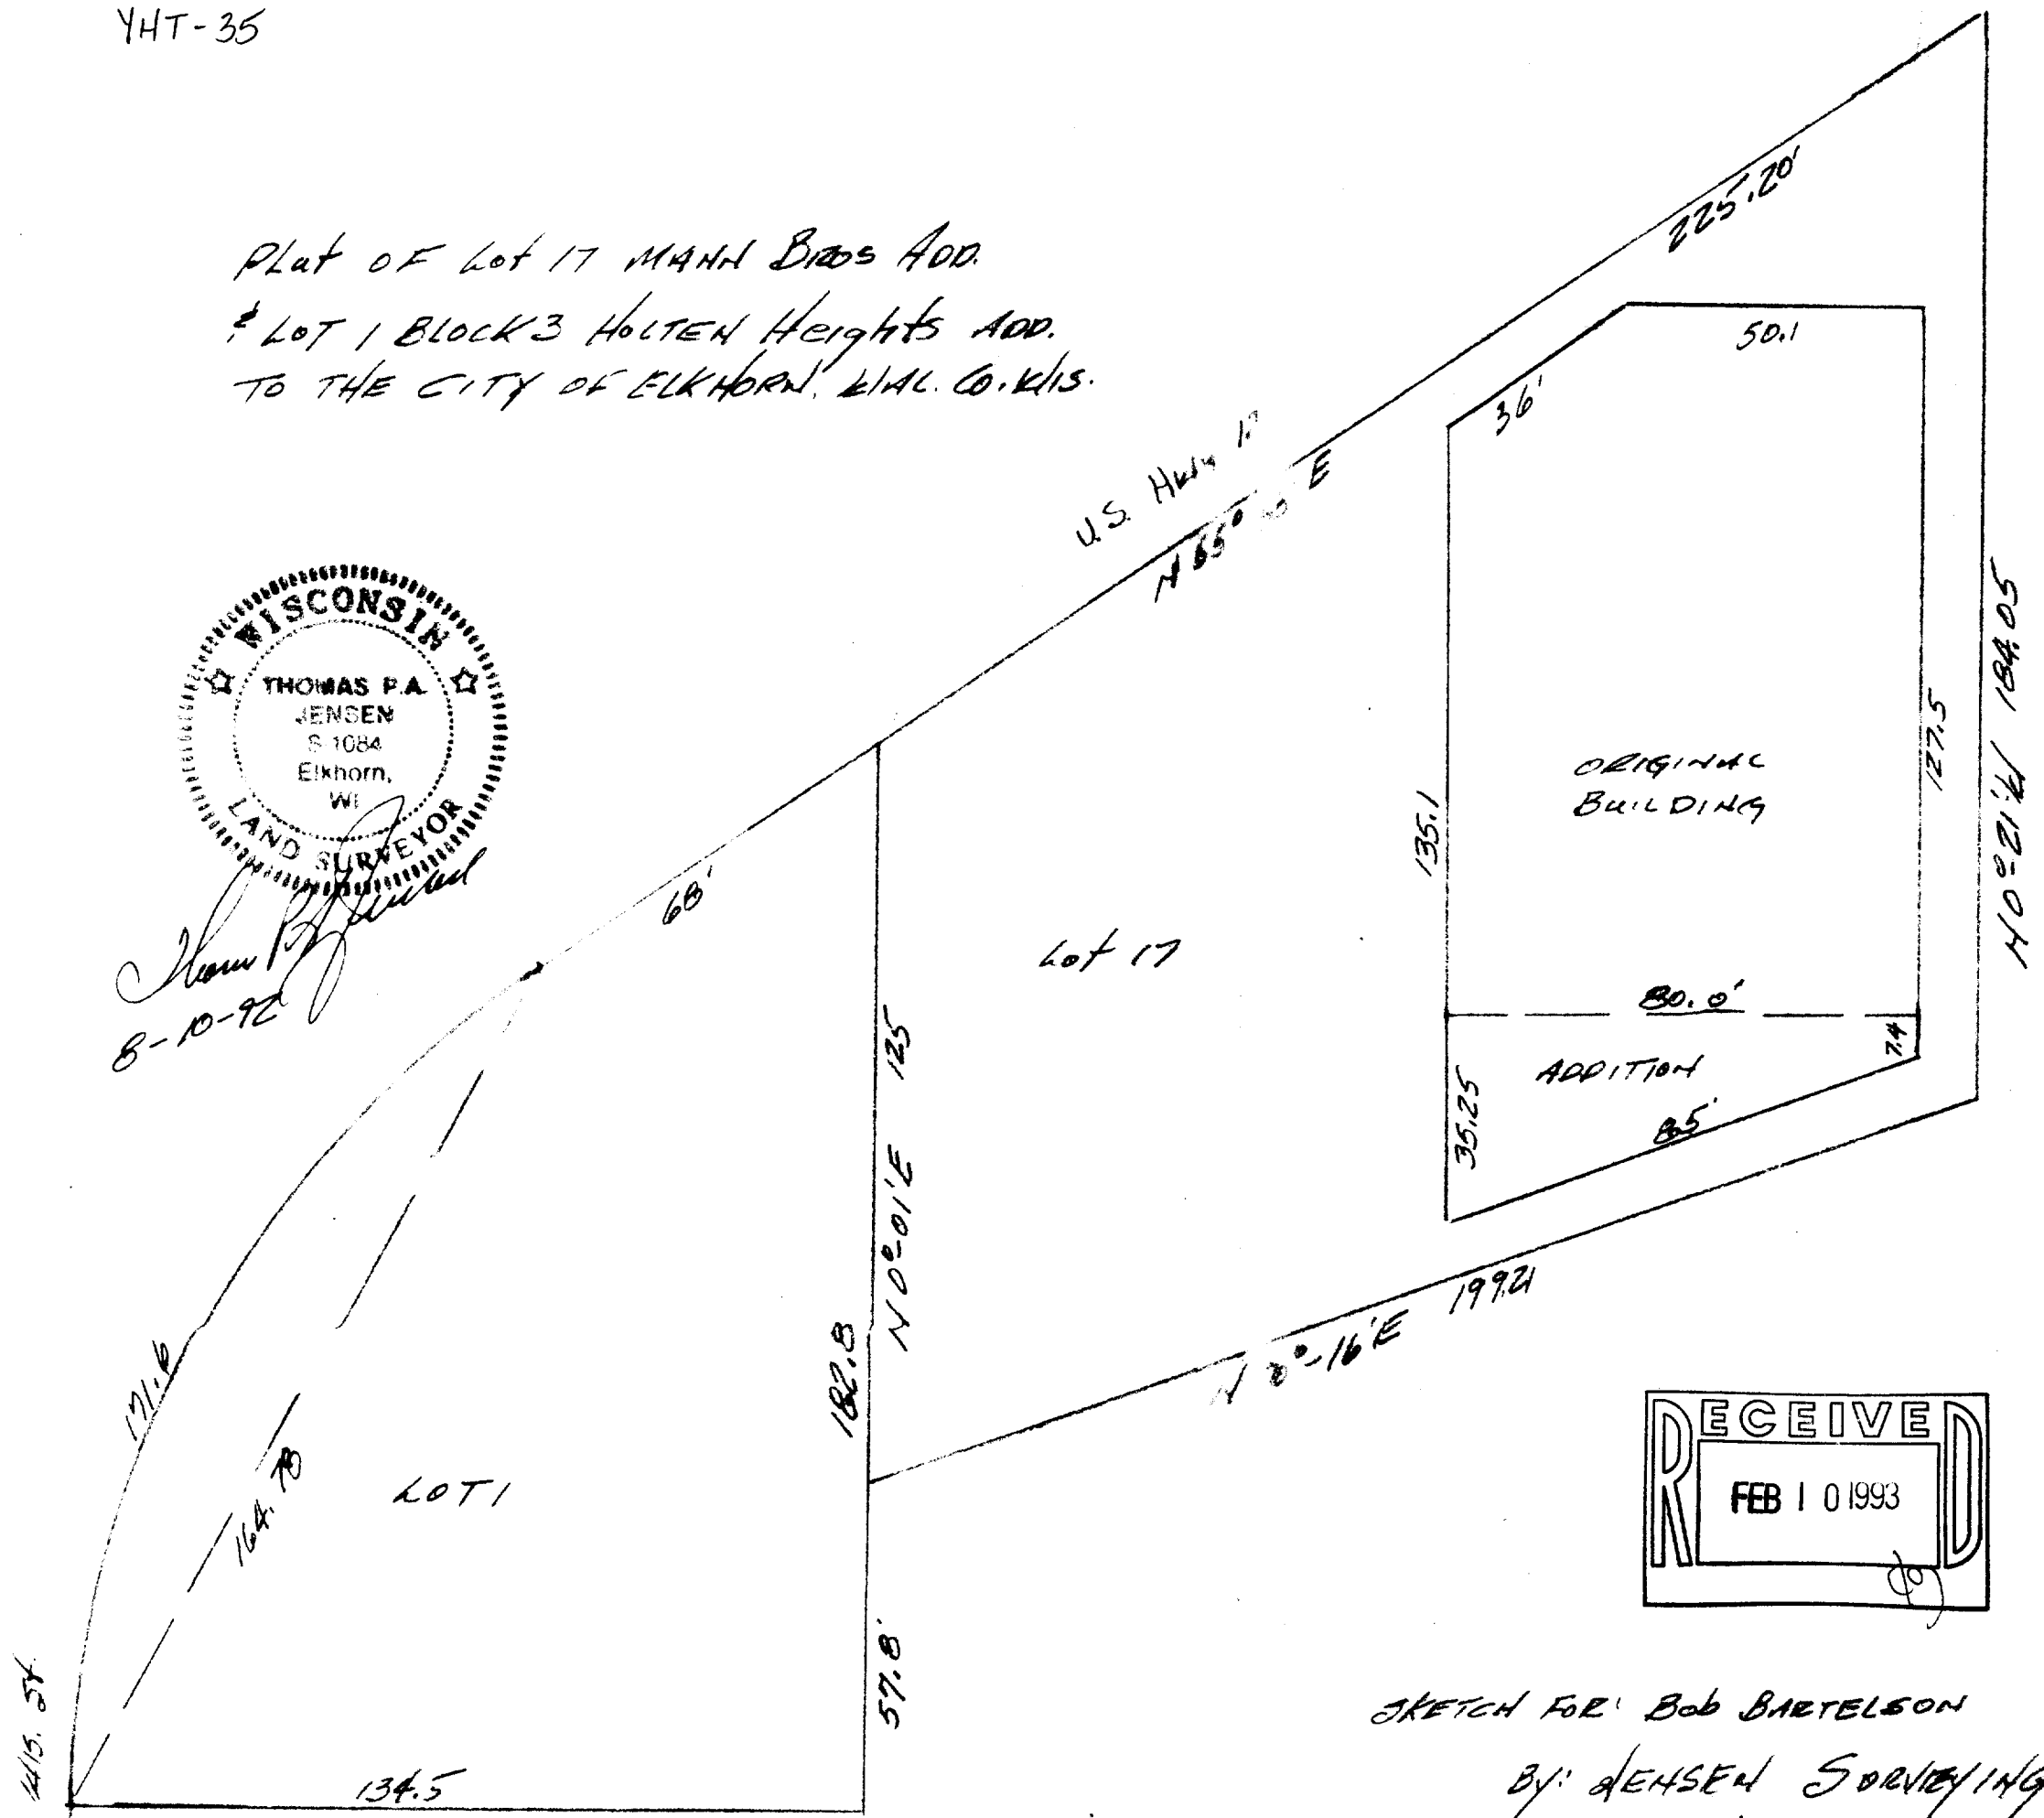


YMB-17
YHT-35

ØØ4-770

Plat of Lot 17 MANN Bros ADD.
LOT 1 BLOCK 3 HOLTEN HEIGHTS ADD.
TO THE CITY OF ELKHORN, WIS. CO. WIS.

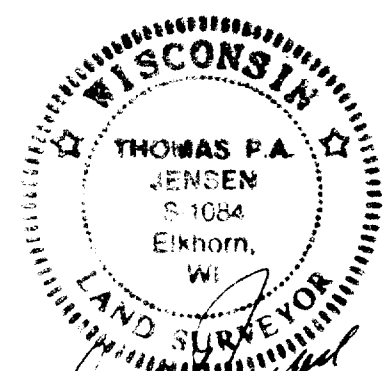

SKETCH FOR: BOB BARTELSON

BY: JENSEN SURVEYING & MAPPING SC.
ELK. 6/15.
1992.100