



PLAT OF SURVEY
OF

LOT 15 & THE W 1/2 OF LOT 16 OF OAKLAND SUBDIVISION
LOCATED IN SECTION 36, T3N, R16E, CITY OF ELKHORN,
WALWORTH COUNTY, WISCONSIN

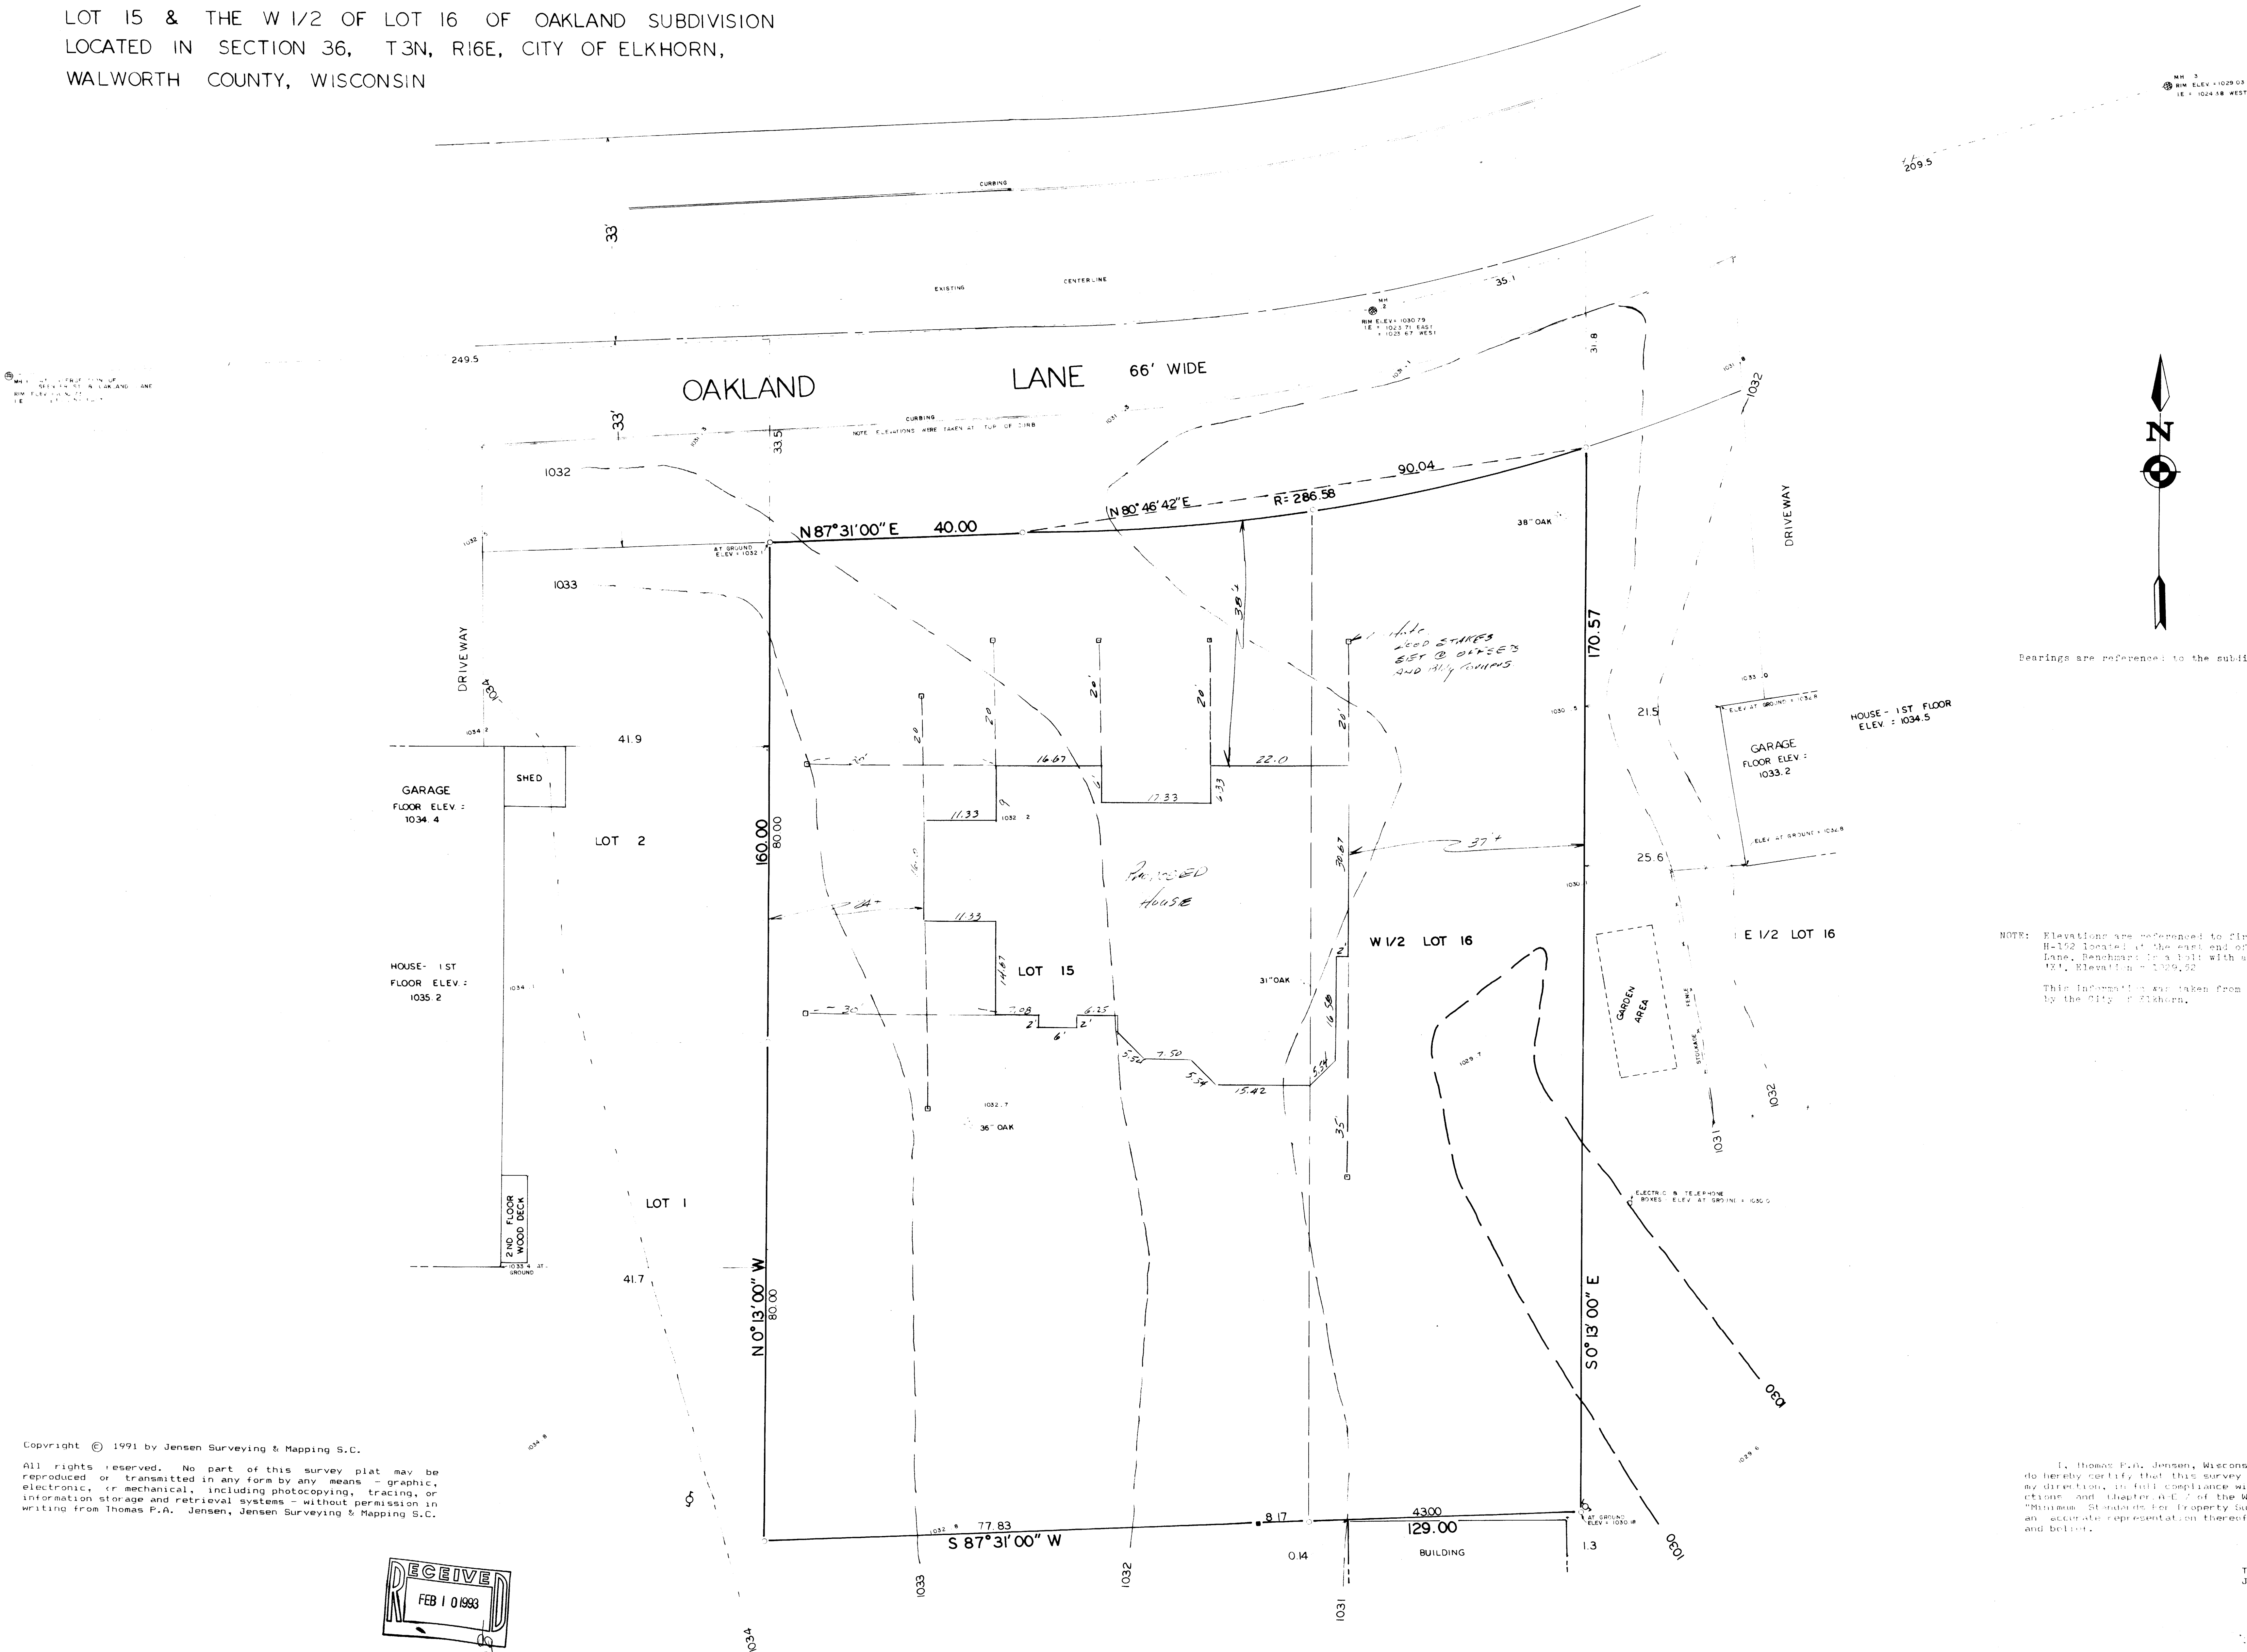

Copyright © 1991 by Jensen Surveying & Mapping S.C.
All rights reserved. No part of this survey plat may be reproduced or transmitted in any form by any means - graphic, electronic, or mechanical, including photocopying, tracing, or information storage and retrieval systems - without permission in writing from Thomas P.A. Jensen, Jensen Surveying & Mapping S.C.

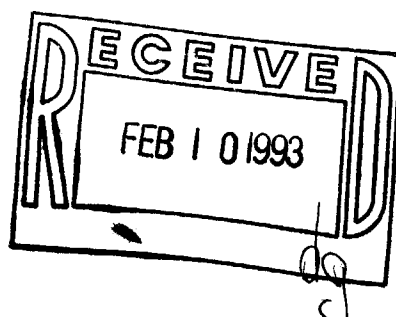

I, Thomas P.A. Jensen, Wisconsin Registered Land Surveyor, do hereby certify that this survey was performed by me, or under my direction, in full compliance with the owner's agent's instructions and Chapter 19.02 of the Wisconsin Administrative Code "Minimum Standards for Property Survey"; and that this map is an accurate representation thereof to the best of my knowledge and belief.

Thomas P.A. Jensen R.L.S.-1084
Jensen Surveying & Mapping S.C.

Mapping date: 12-13-91
Revisions:

Scale: 1" = 10'
0 5 10 20 30

JENSEN SURVEYING & MAPPING S.C.
45 South Wisconsin Street P.O. Box 322
Elkhorn, Wisconsin 53121
(414) 723-3434

Legend
FOUND CONC. MONUMENT
POWER UTILITY POLE
SPOT ELEVATION

Sheet no. 1 of 1 Sheets.
Job reference number
1991 215