

PLAT OF SURVEY

OF
A PARCEL OF LAND LOCATED IN THE SE 1/4 OF THE SE 1/4 OF
SECTION 25, T3N, R16E, CITY OF ELKHORN,
WALWORTH COUNTY, WISCONSIN

Copyright © 1992 by Jensen Surveying & Mapping S.C.
All rights reserved. No part of this survey plat may be reproduced or transmitted in any form by any means - graphic, electronic, or mechanical, including photocopying, tracing, or information storage and retrieval systems - without permission in writing from Thomas P.A. Jensen, Jensen Surveying & Mapping S.C.

BEARINGS REFERENCED TO THE WISCONSIN STATE
PLANE COORDINATE SYSTEM, SOUTH ZONE
COORDINATES ARE NAD 27 - COMBINATION FACTOR : 0.9999622
ELEVATIONS REFERENCED TO MEAN SEA LEVEL NAVD 29

ORDERED BY: ROBIN RICHARDS
ERM NORTH CENTRAL
1110 N. 3RD ST. SUITE 660
MILWAUKEE, WI 53203
(414) 289-9505

LEGAL DESCRIPTION
That part of Section 25, Township 3 North, Range 16 East, commencing at the Southeast corner of said section; thence West in said section line 480 feet; thence North in a straight line parallel to the East section line of said section and at a distance from said section line of 480 feet to a point 635.6 feet North of said section line; thence easterly in a straight line parallel to the South line of said section 180 feet; thence South in a line parallel with the East section line 200 feet; thence East parallel with the South section line 300 feet; thence South along the East section line to the place of beginning.
VOL. 420 PAGE 356




MONITORING WELL DATA

WELL	Y	X	ELEVATION TOP OF CASING	ELEVATION TOP OF PVC PIPE
MW-1	253,065.30	2,391,914.84	1014.08	1013.94
MW-2	253,070.93	2,391,937.54	1014.52	1014.29
MW-3	253,034.65	2,391,942.16	1014.87	1014.61

NOTE: GROUND ELEVATIONS ARE SHOWN AT WELL SITES

I, Thomas P.A. Jensen, Wisconsin Registered Land Surveyor, do hereby certify that this survey was performed by me, or under my direction, in full compliance with the owner's/agent's instructions and Chapter A-E 7 of the Wisconsin Administrative Code "Minimum Standards For Property Surveys"; and that this map is an accurate representation thereof to the best of my knowledge and belief.
Thomas P.A. Jensen R.L.S-1084
Jensen Surveying & Mapping S.C.

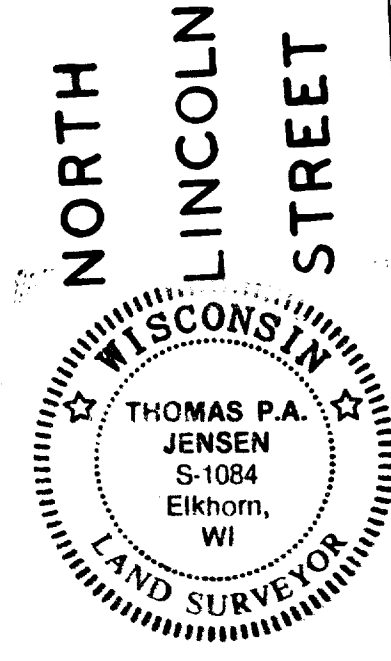


Note: This survey plat is not certified unless signed and sealed in red ink.

Sheet no. 1 of 1 Sheets.
Job reference number
1992.062

Legend
● CONCRETE COUNTY MONUMENT
● FOUND IRON PIPE, 1" DIAMETER
● FOUND IRON ROD, 3/4" DIAM.
● SET IRON ROD, 3/4" X 24"
● UTILITY POLE
● MONITORING WELL
● GAS PUMP
— OVERHEAD WIRES

JENSEN SURVEYING & MAPPING S.C.
45 South Wisconsin Street P.O. Box 322
Elkhorn, Wisconsin 53121
(414) 723-3434

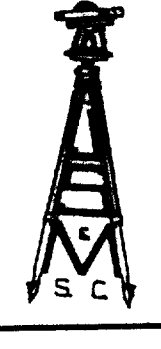

Scale: 1" = 30'
0 15 30 60 90

Mapping date: MAY 8, 1992
Revisions: _____

Y01NW-232