


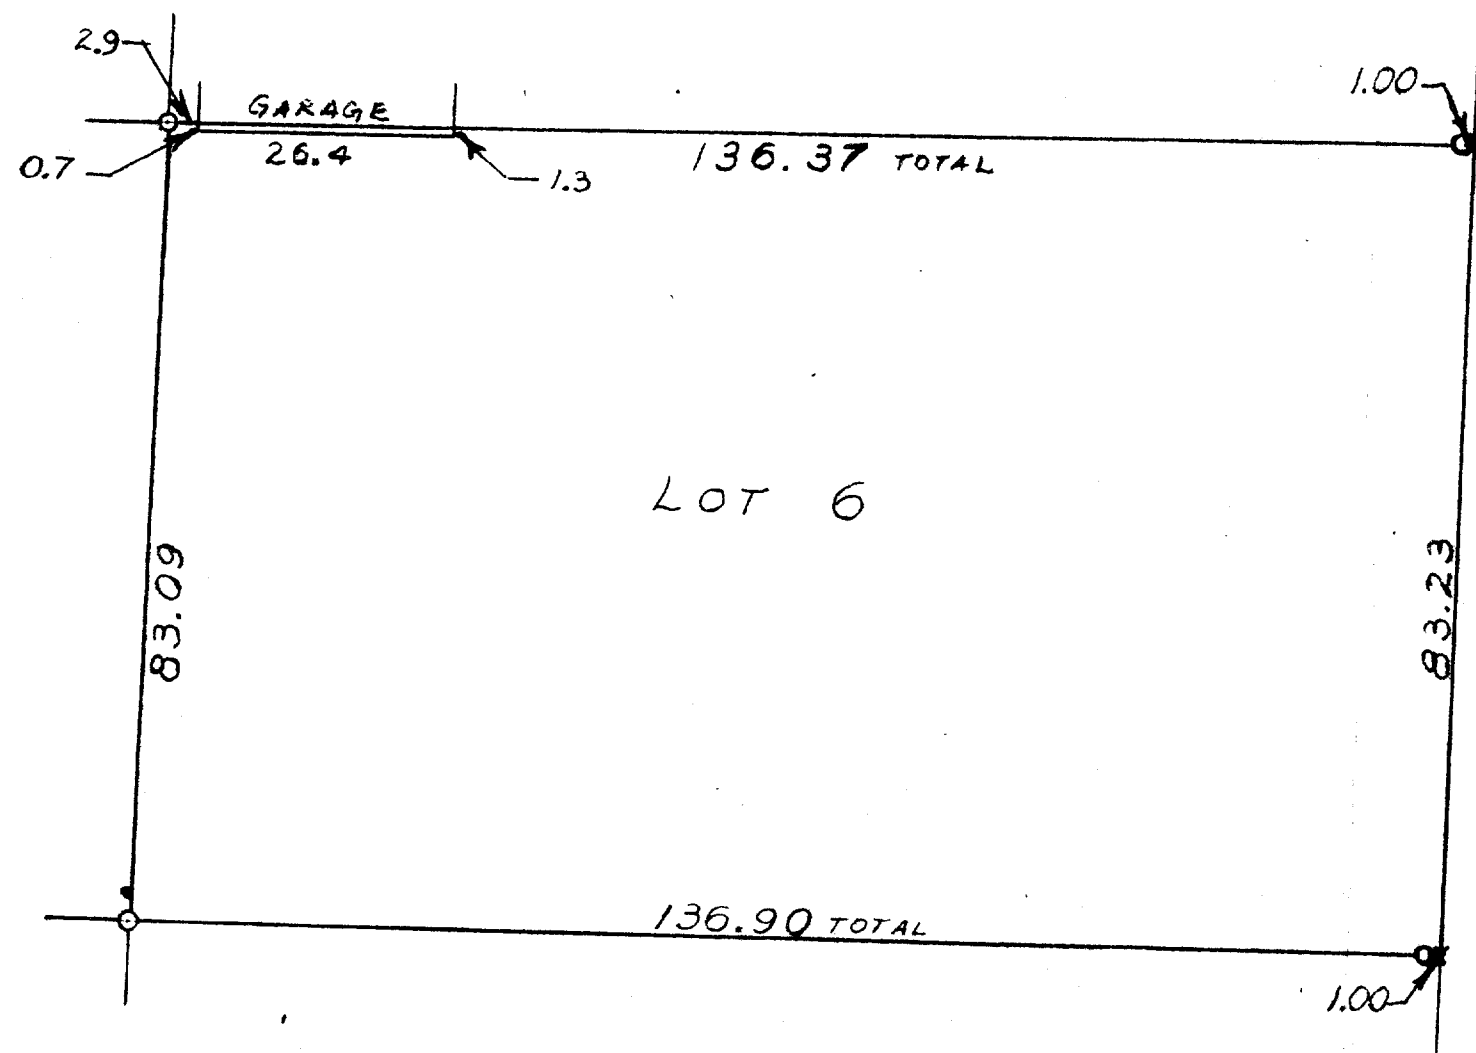

SCALE ~ 1"=20'
 O ~ IRON PIPE
 X ~ CROSS

PLAT OF SURVEY OF LOT 6, BLOCK 8, ELDERKINS ADDITION LOCATED IN
 THE CITY OF ELKHORN, WALWORTH COUNTY, WISCONSIN
 MAY 8, 1957.

YER-46

George T. Dunham
 GEORGE T. DUNHAM, SURVEYOR
 DELAVAN, WISCONSIN

4-8