

FARRIS, HANSEN & ASSOCIATES, INC.





7 RIDGEWAY COURT, P.O. BOX 437
ELKHORN, WISCONSIN 53121

PLAT OF SURVEY

PHONE: (414) 723-2088
FAX: (414) 723-5886

LOCATION: LOT 10 NICHOLS SUBDIVISION
NW 1/4 OF THE NW 1/4, SEC. 31, T. 3 N., R. 17 E.
WALWORTH COUNTY, WI.

- MAP LEGEND
- - IRON PIPE STAKE FOUND
 - - IRON PIPE STAKE SET
 - - IRON ROD STAKE FOUND
 - - IRON ROD STAKE SET
 - - CONCRETE MONUMENT FOUND
 - - RECORD DIMENSION

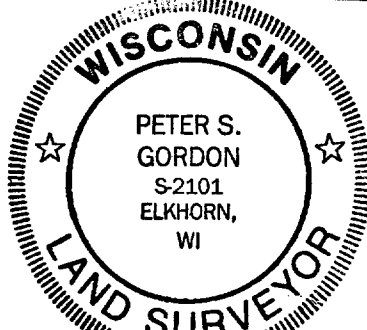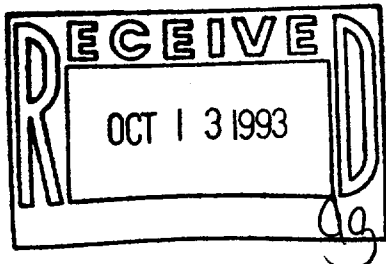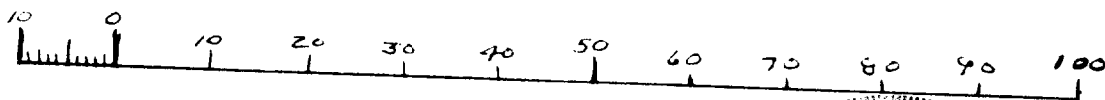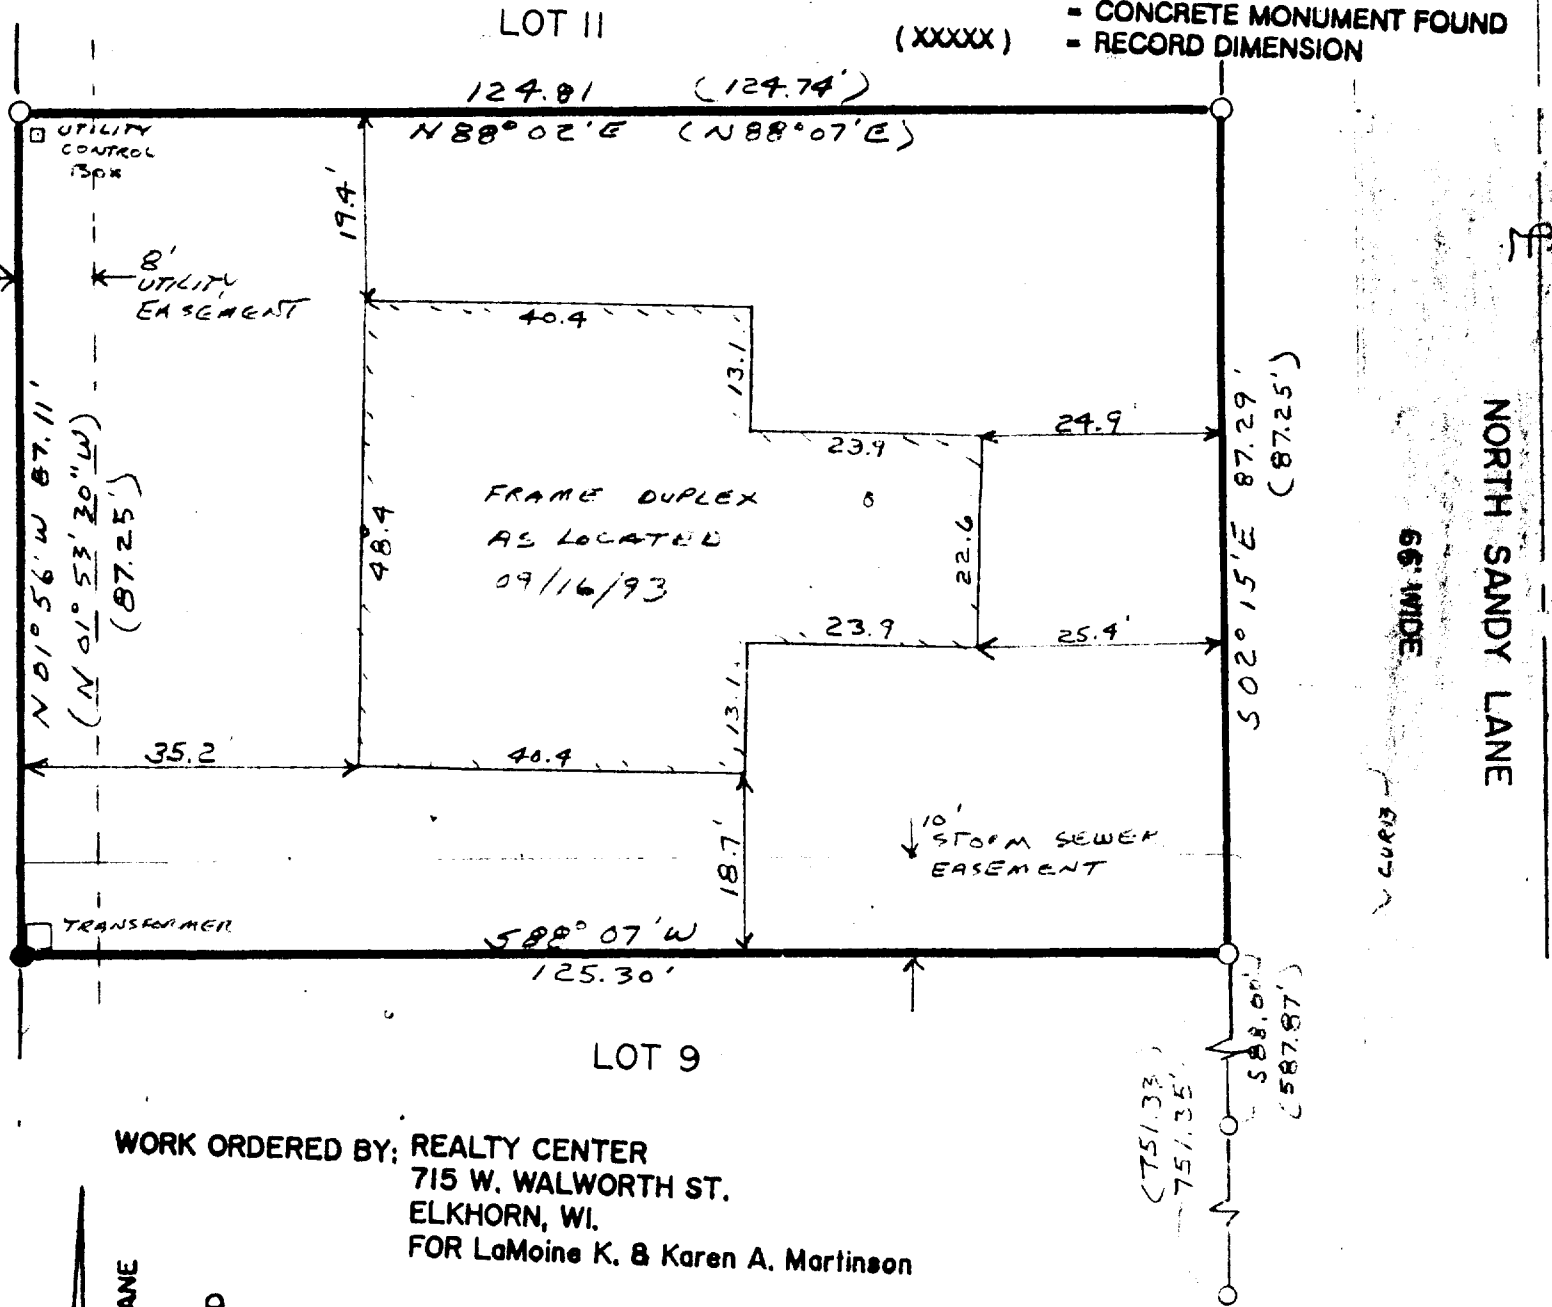

NOTE: COPIES OF THIS MAP TO WHICH THE FOLLOWING CERTIFICATE WILL APPLY ARE BLUE LINE PRINTS. COPIES BY ANY OTHER MEANS MAY HAVE ALTERATIONS WHICH DO NOT REPRESENT THE SURVEYOR'S WORK PRODUCT.

I HEREBY CERTIFY THAT THE ABOVE DESCRIBED PROPERTY HAS BEEN SURVEYED UNDER MY DIRECTION AND THAT THE ABOVE MAP IS A TRUE REPRESENTATION THEREOF AND SHOWS THE SIZE AND LOCATION OF THE PROPERTY AND ITS EXTERIOR BOUNDARIES. THIS SURVEY IS MADE FOR THE USE OF THE PRESENT OWNERS OF THE PROPERTY, AND ALSO THOSE WHO PURCHASE, MORTGAGE, OR GUARANTEE THE TITLE THERETO WITHIN ONE YEAR FROM THE DATE HEREOF.

DATED: 09/16/93

Peter S. Gordon

PROJECT NO. 2567.10

4N-10

4-811