


**ABELL
SURVEYING & MAPPING
DELAVAN, WISCONSIN 53115
414-728-6737**

WALWORTH STREET


100' WIDE

JACKSON STREET

66' WIDE

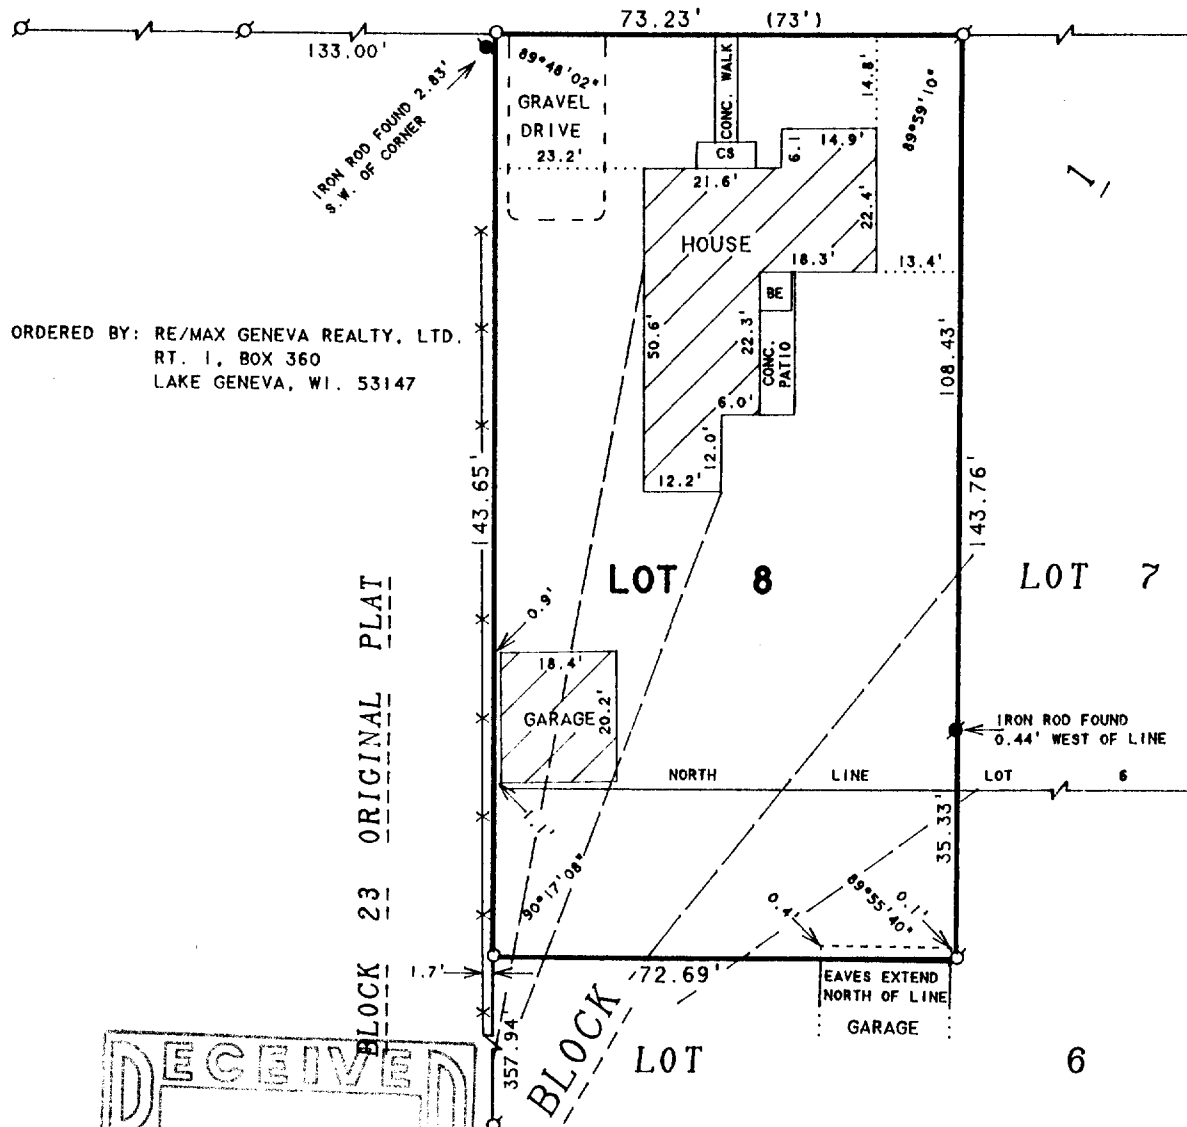

ORDERED BY: RE/MAX GENEVA REALTY, LTD.
RT. 1, BOX 360
LAKE GENEVA, WI. 53147

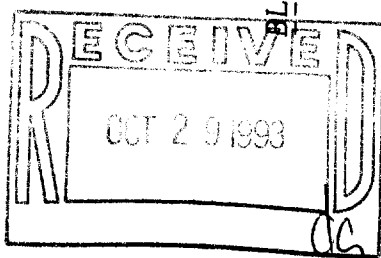

SCALE 1"=30'

LEGEND

- Ø - IRON PIPE FOUND
- - IRON ROD FOUND
- - IRON ROD SET
- CS - CONCRETE STOOP
- BE - BASEMENT ENTRY
- X— - CHAINLINK FENCE
- — — - OVERHEAD UTILITY LINES
- () - RECORDED AS

PLAT OF SURVEY OF

LOT 8 AND THE WEST 1/2 OF THE NORTH 47 FEET
OF LOT 6 IN BLOCK 1 OF ARNOLDS ADDITION TO
THE CITY OF ELKHORN, WALWORTH COUNTY, WISCONSIN.
EXCEPTING PARCEL CONVEYED TO GROVE HARKNESS,
DESCRIBED AS THE SOUTH 21 FEET OF THE WEST 1/2
OF THE NORTH 47 FEET OF SAID LOT 6.

I HEREBY CERTIFY THAT I HAVE SURVEYED THE ABOVE DESCRIBED PROPERTY AND THAT THE ABOVE MAP IS A TRUE REPRESENTATION THEREOF AND SHOWS THE SIZE AND LOCATION OF THE PROPERTY, ITS EXTERIOR BOUNDARIES, THE LOCATION OF ALL VISIBLE STRUCTURES AND DIMENSIONS OF ALL PRINCIPAL BUILDINGS THEREON, BOUNDARY FENCES, APPARENT EASEMENTS, ROADWAYS AND VISIBLE ENCROACHMENTS, IF ANY, TO THE BEST OF MY KNOWLEDGE AND BELIEF.

THIS SURVEY IS MADE FOR THE USE OF THE PRESENT OWNERS OF THE PROPERTY, AND ALSO THOSE WHO PURCHASE, MORTGAGE, OR GUARANTEE THE TITLE THERETO WITHIN ONE (1) YEAR FROM DATE HEREON.

David F. Abell

DAVID F. ABELL
WISCONSIN REGISTERED LAND SURVEYOR, S-1596

August 24, 1993

DATE: August 24, 1993
JOB NUMBER - 93181
NOTE: THIS IS NOT A CERTIFIED COPY UNLESS SEALED.