

#89-64

BAKER STREET

33.00'

• INDICATES IRON PIPE

S 89° 25' W
120.00'

115.00' 34.74'

N 89° 25' E
120.00'

42.33' 30.5' 22.17'

RESIDENCE

35'

80.26'

39'

S 89° 20' E


N 89° 20' E

120.00'

34.74'

80.15'

114.89'

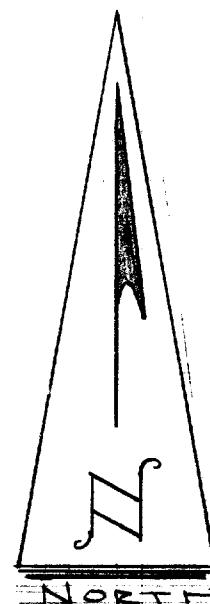

33.00'

33.00'


33.00'

CENTRALIA ST

DESCRIPTION: Lot 18 and the South 34.74 feet of Lot 17 of James Jones'
2nd. Addition to the City of Elkhorn, Walworth County, Wisc.
BLK. 3

CERTIFICATE: I, James F. Biagi, surveyor do hereby certify that I have
surveyed the property hereon described, and that the
location of the improvements are as shown hereon.

DECEMBER 15, 1964.

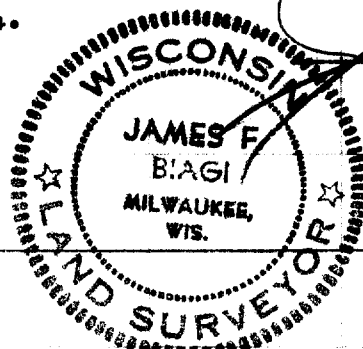

James F. Biagi RLS 272

JA2-49

4-81B