


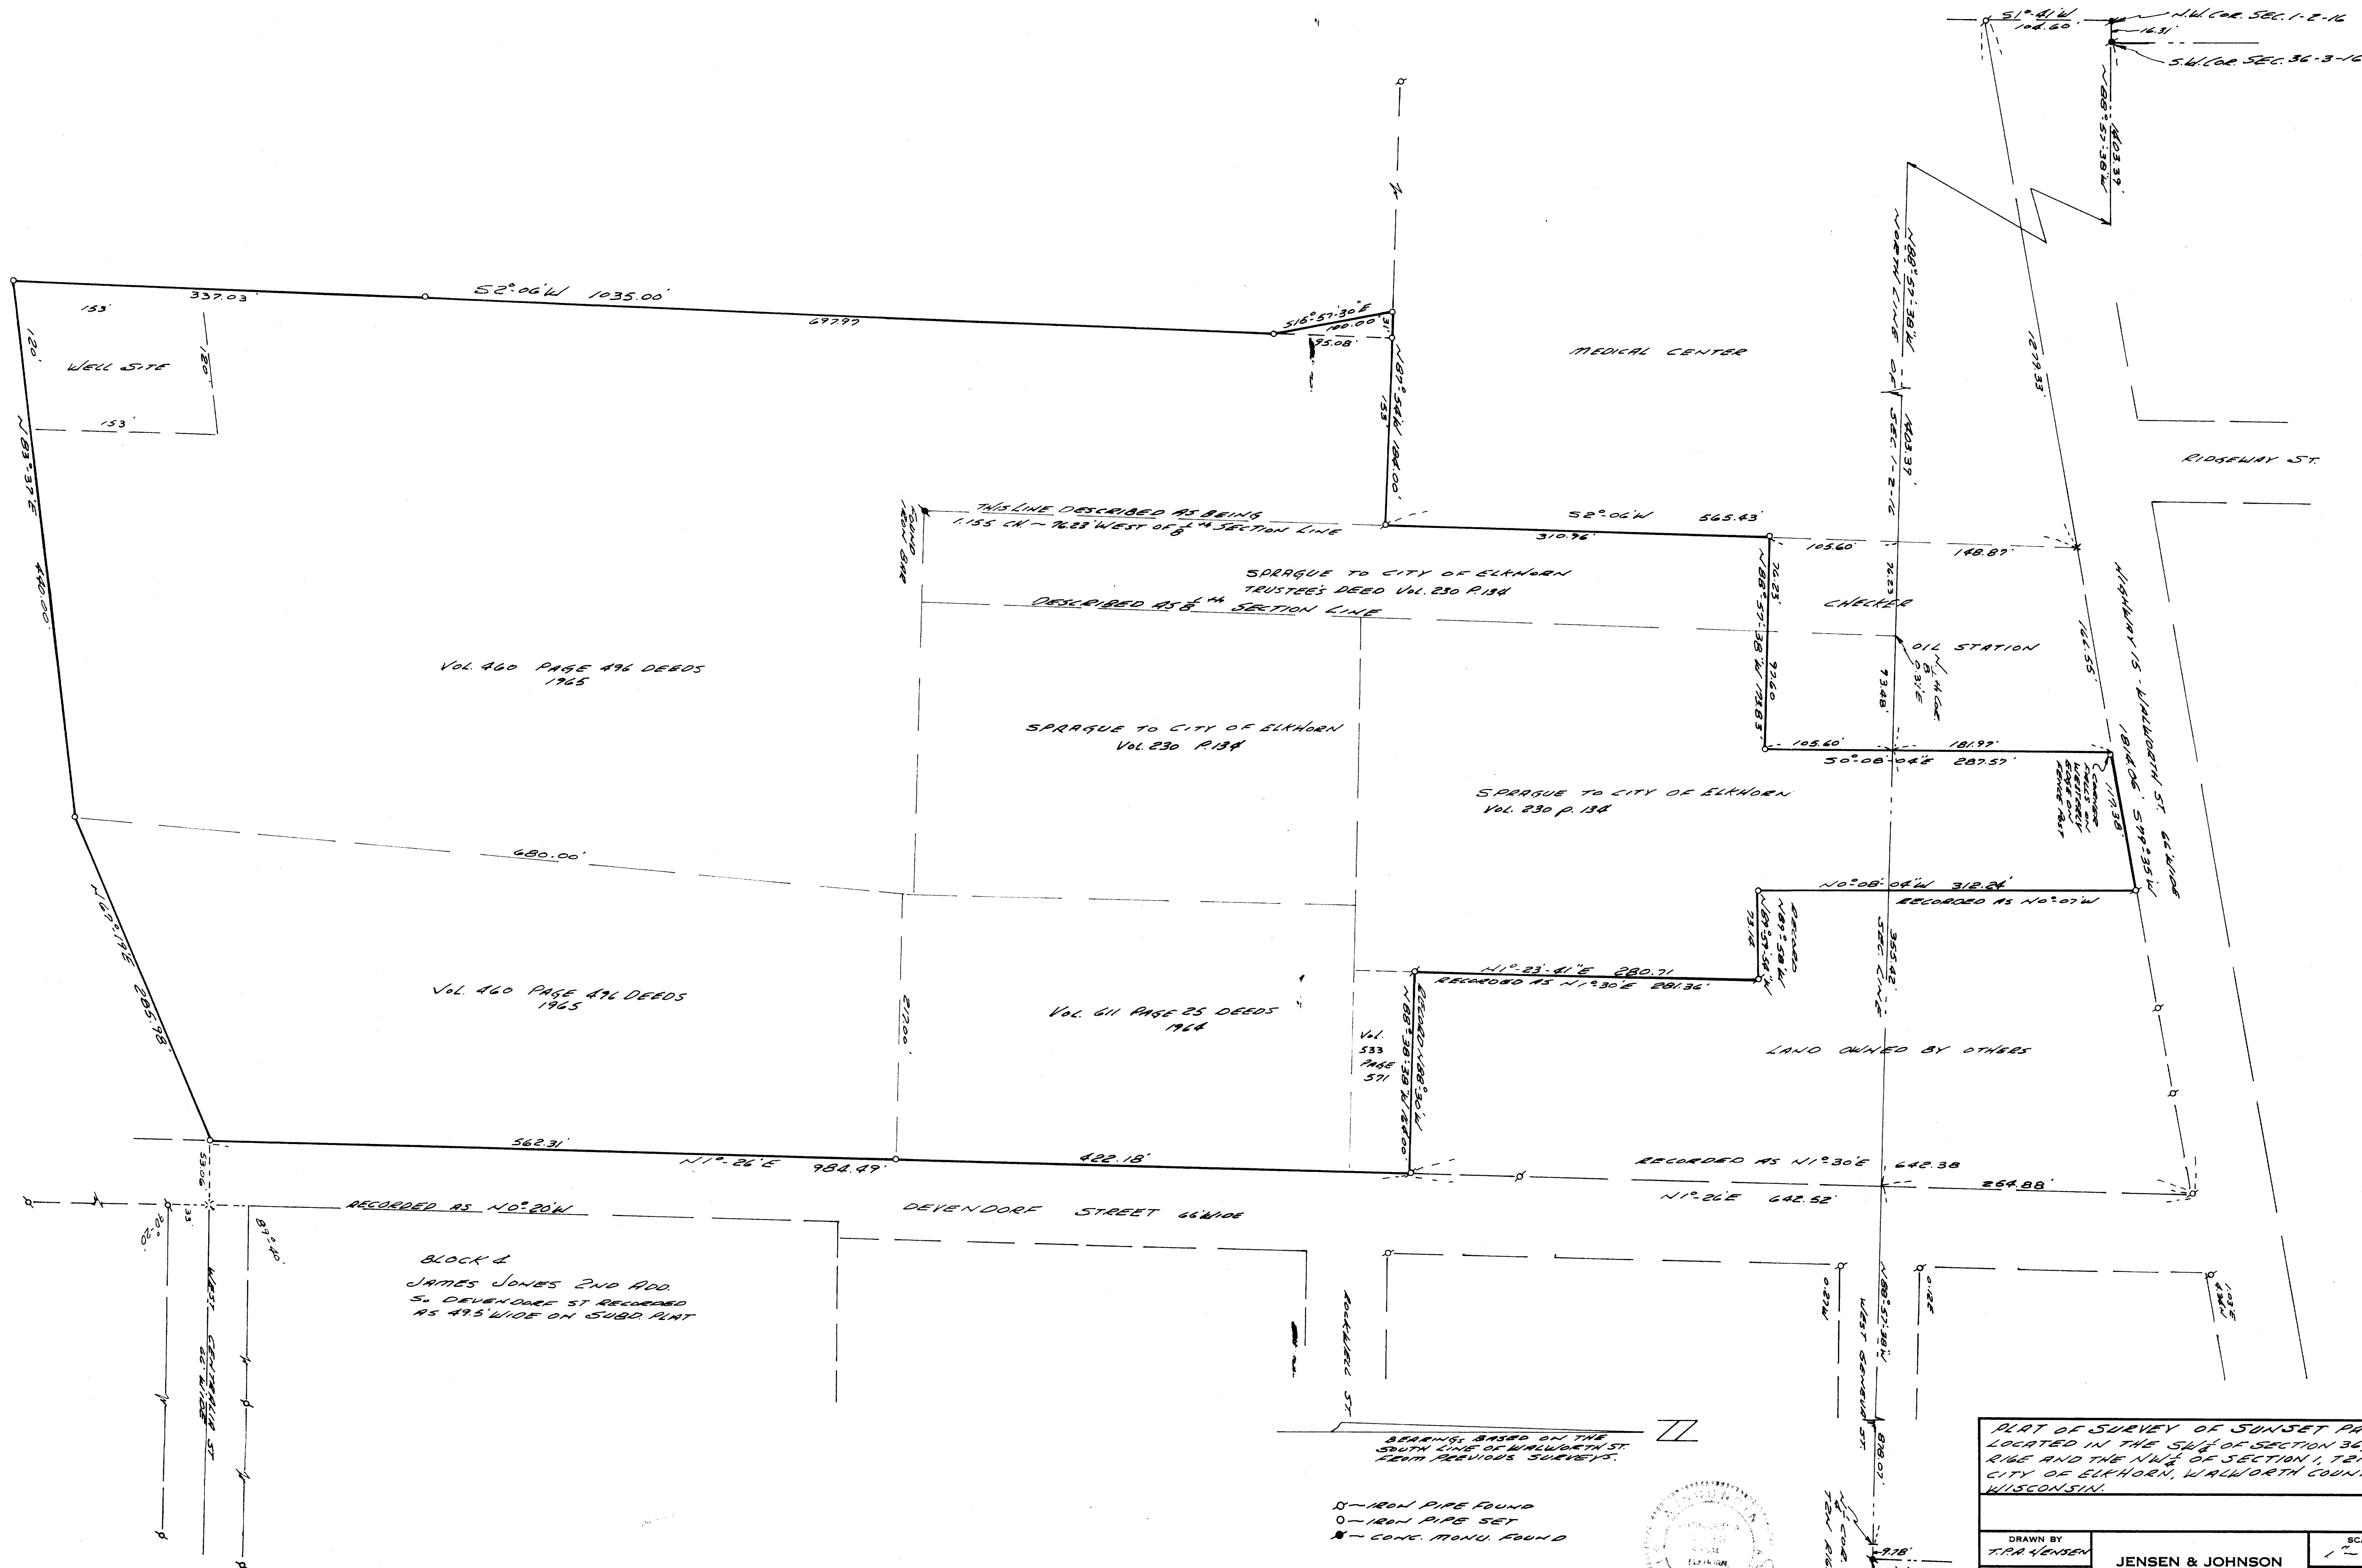

PLAT OF SURVEY OF SUNSET PARK
LOCATED IN THE SW 1/4 OF SECTION 36, T3N
R16E AND THE NW 1/4 OF SECTION 1, T6N R16E,
CITY OF ELKHORN, WALKWORTH COUNTY,
WISCONSIN.

DRAWN BY T.R.A. JENSEN	JENSEN & JOHNSON CIVIL ENGINEERS ELKHORN, WIS. DATE AUG 1978	SCALE: 1" = 60'
CHECKED BY		REVISED
APPROVED BY		SHEET NO. 1 OF 1