


GEORGE T. DUNHAM
SURVEYING & SUBDIVIDING
DELAVAL, WISCONSIN

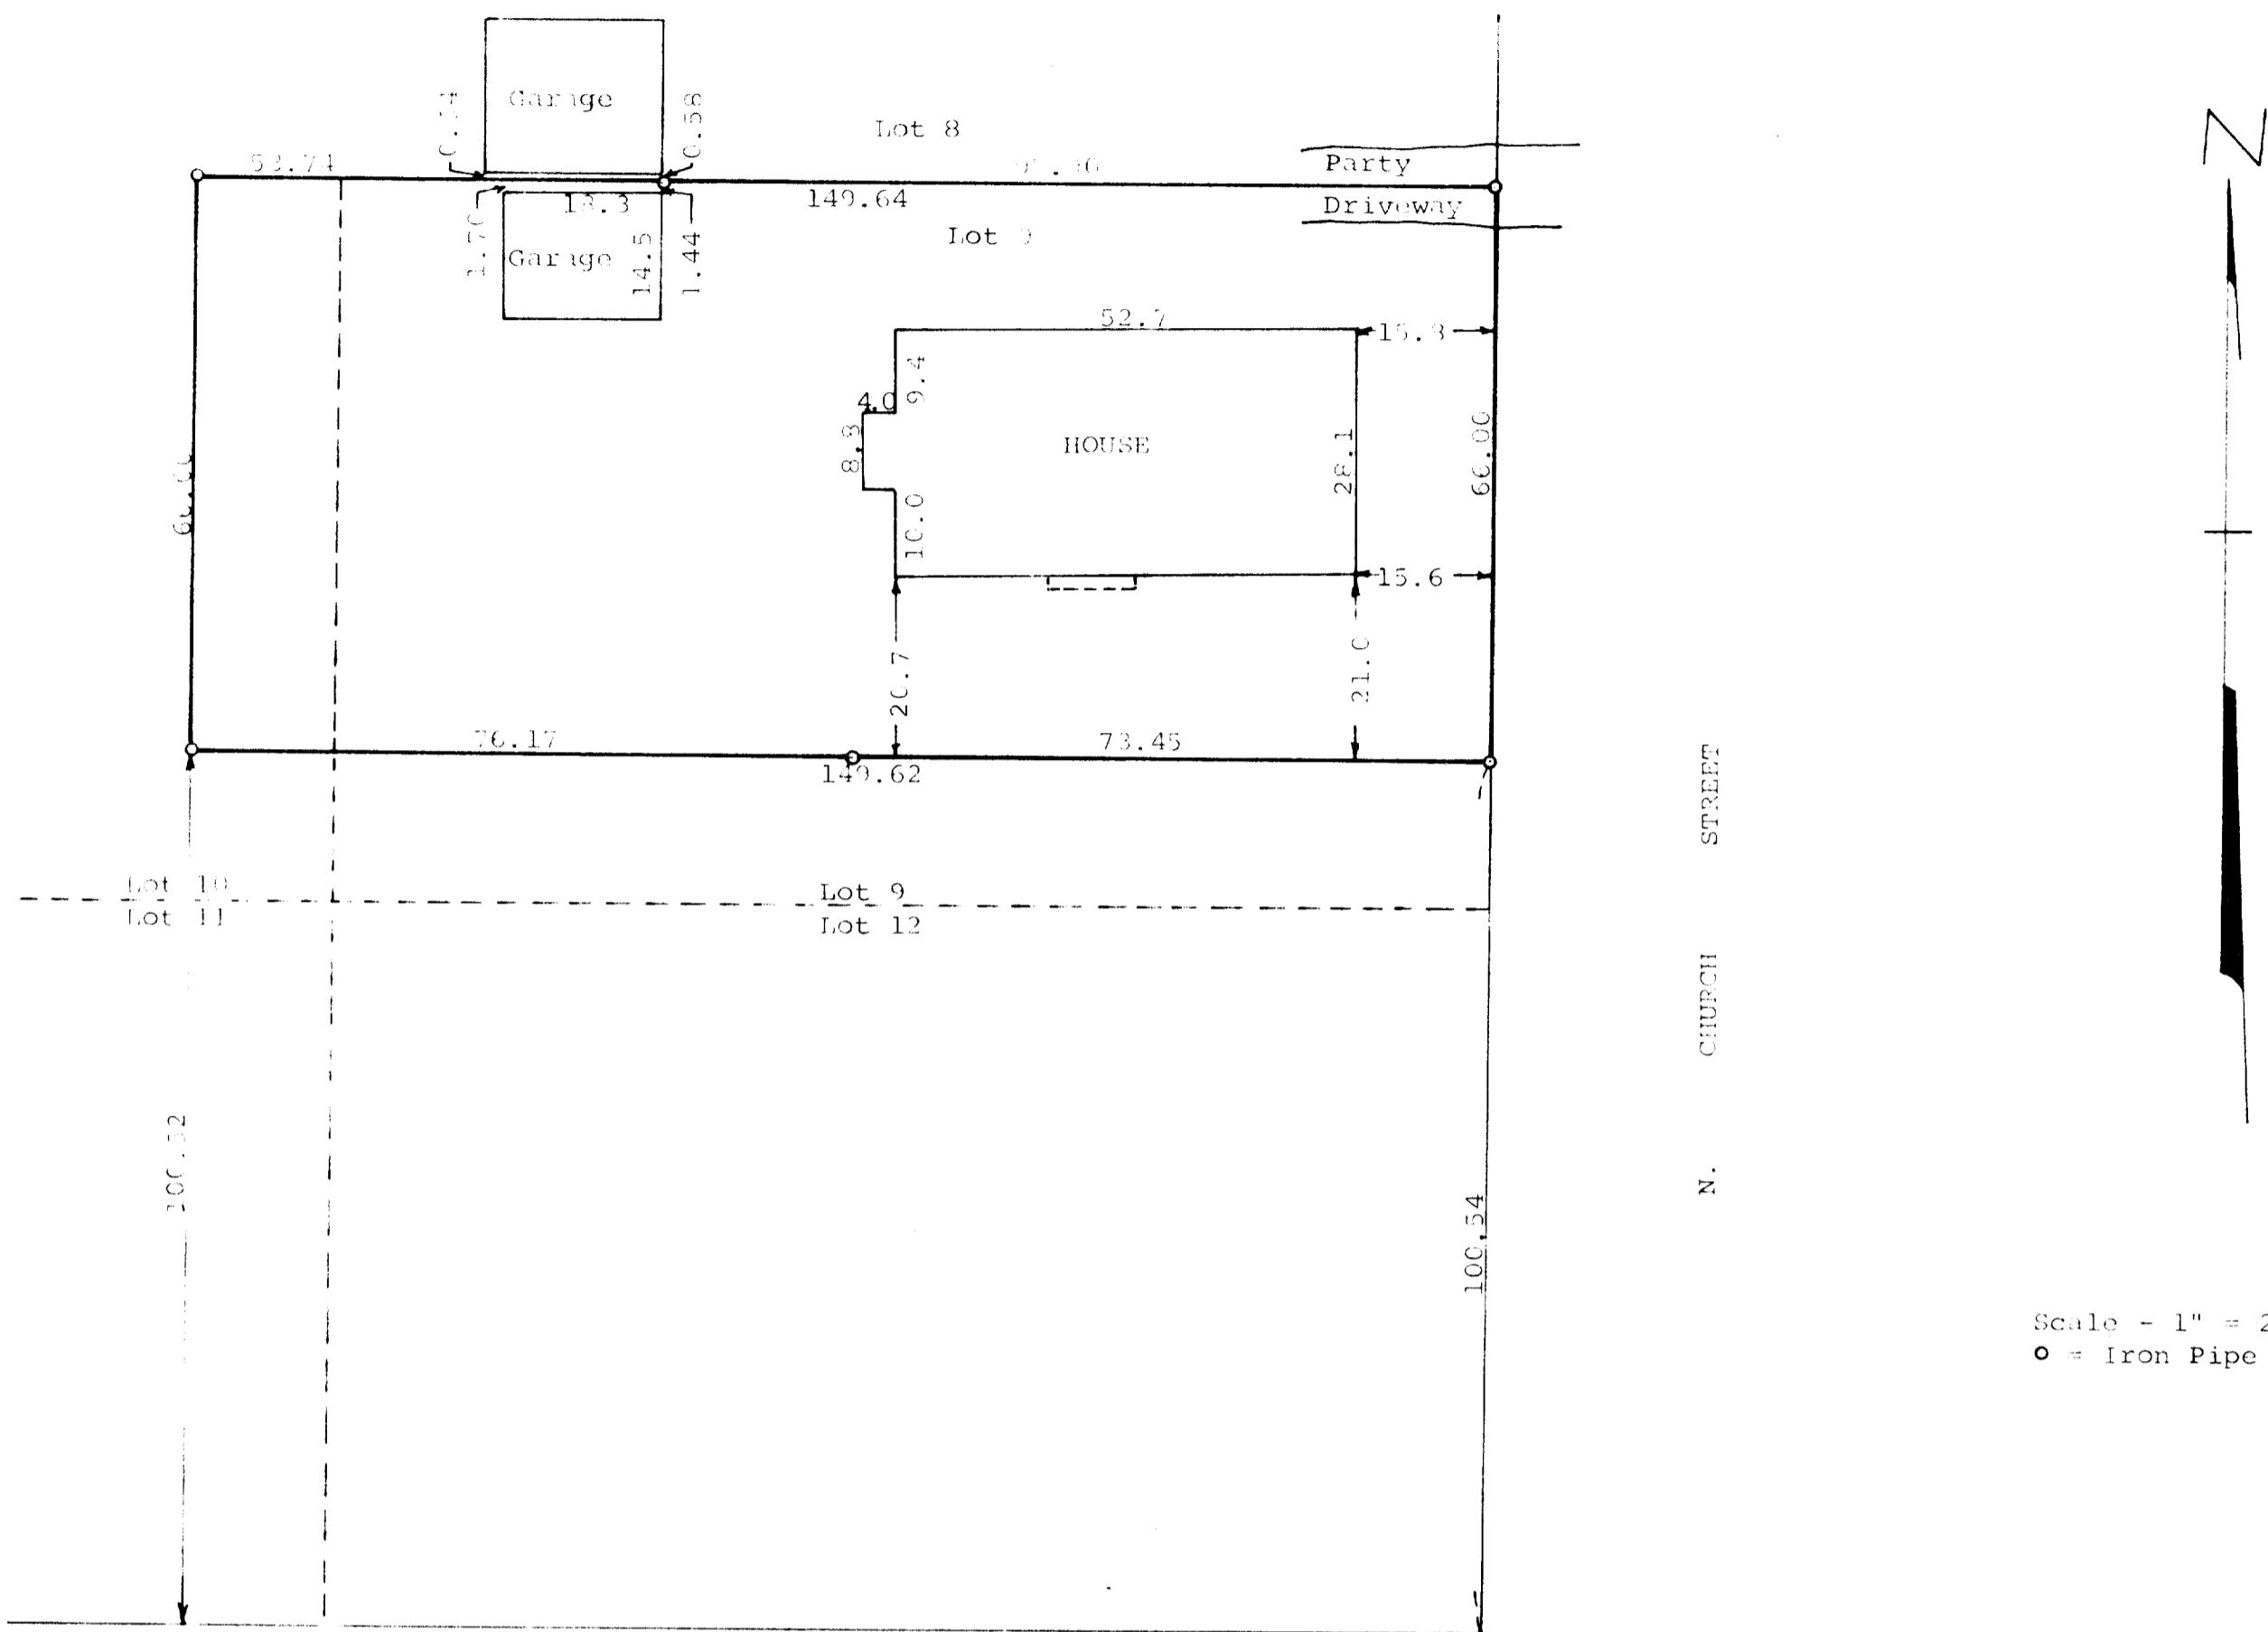

WENT COUPRT STREET

STATE OF WISCONSIN) SS
COUNTY OF WALWORTH:

I, George T. Dunham, Surveyor, certify that I have surveyed the property described as follows,

A part of Lots 9 and 10 in Block 18 of the Village (now City) of Elkhorn, Walworth County, Wisconsin, described as follows, to-wit: Beginning at the northeast corner of said Lot 9; thence West along the north line of said Lots 9 and 10, 149.64 feet to a point located 1 rod west of the northwest corner of said Lot 9; thence South parallel with the east line of said Lot 10, 66.00 feet; thence East parallel with the north line of said Lots 9 and 10, 149.62 feet to the east line of said Lot 9; thence North along the east line of said Lot 9, 66.00 feet to the place of beginning, and that the plat shown above is a correct survey and a true representation thereof and correctly shows the exterior boundary lines and location of buildings on said property and the correct measurements thereof.

June 30, 1971

George T. Dunham
George T. Dunham, Surveyor

