


ABELL
SURVEYING & MAPPING
DELANAN, WISCONSIN 53115
414-728-6737

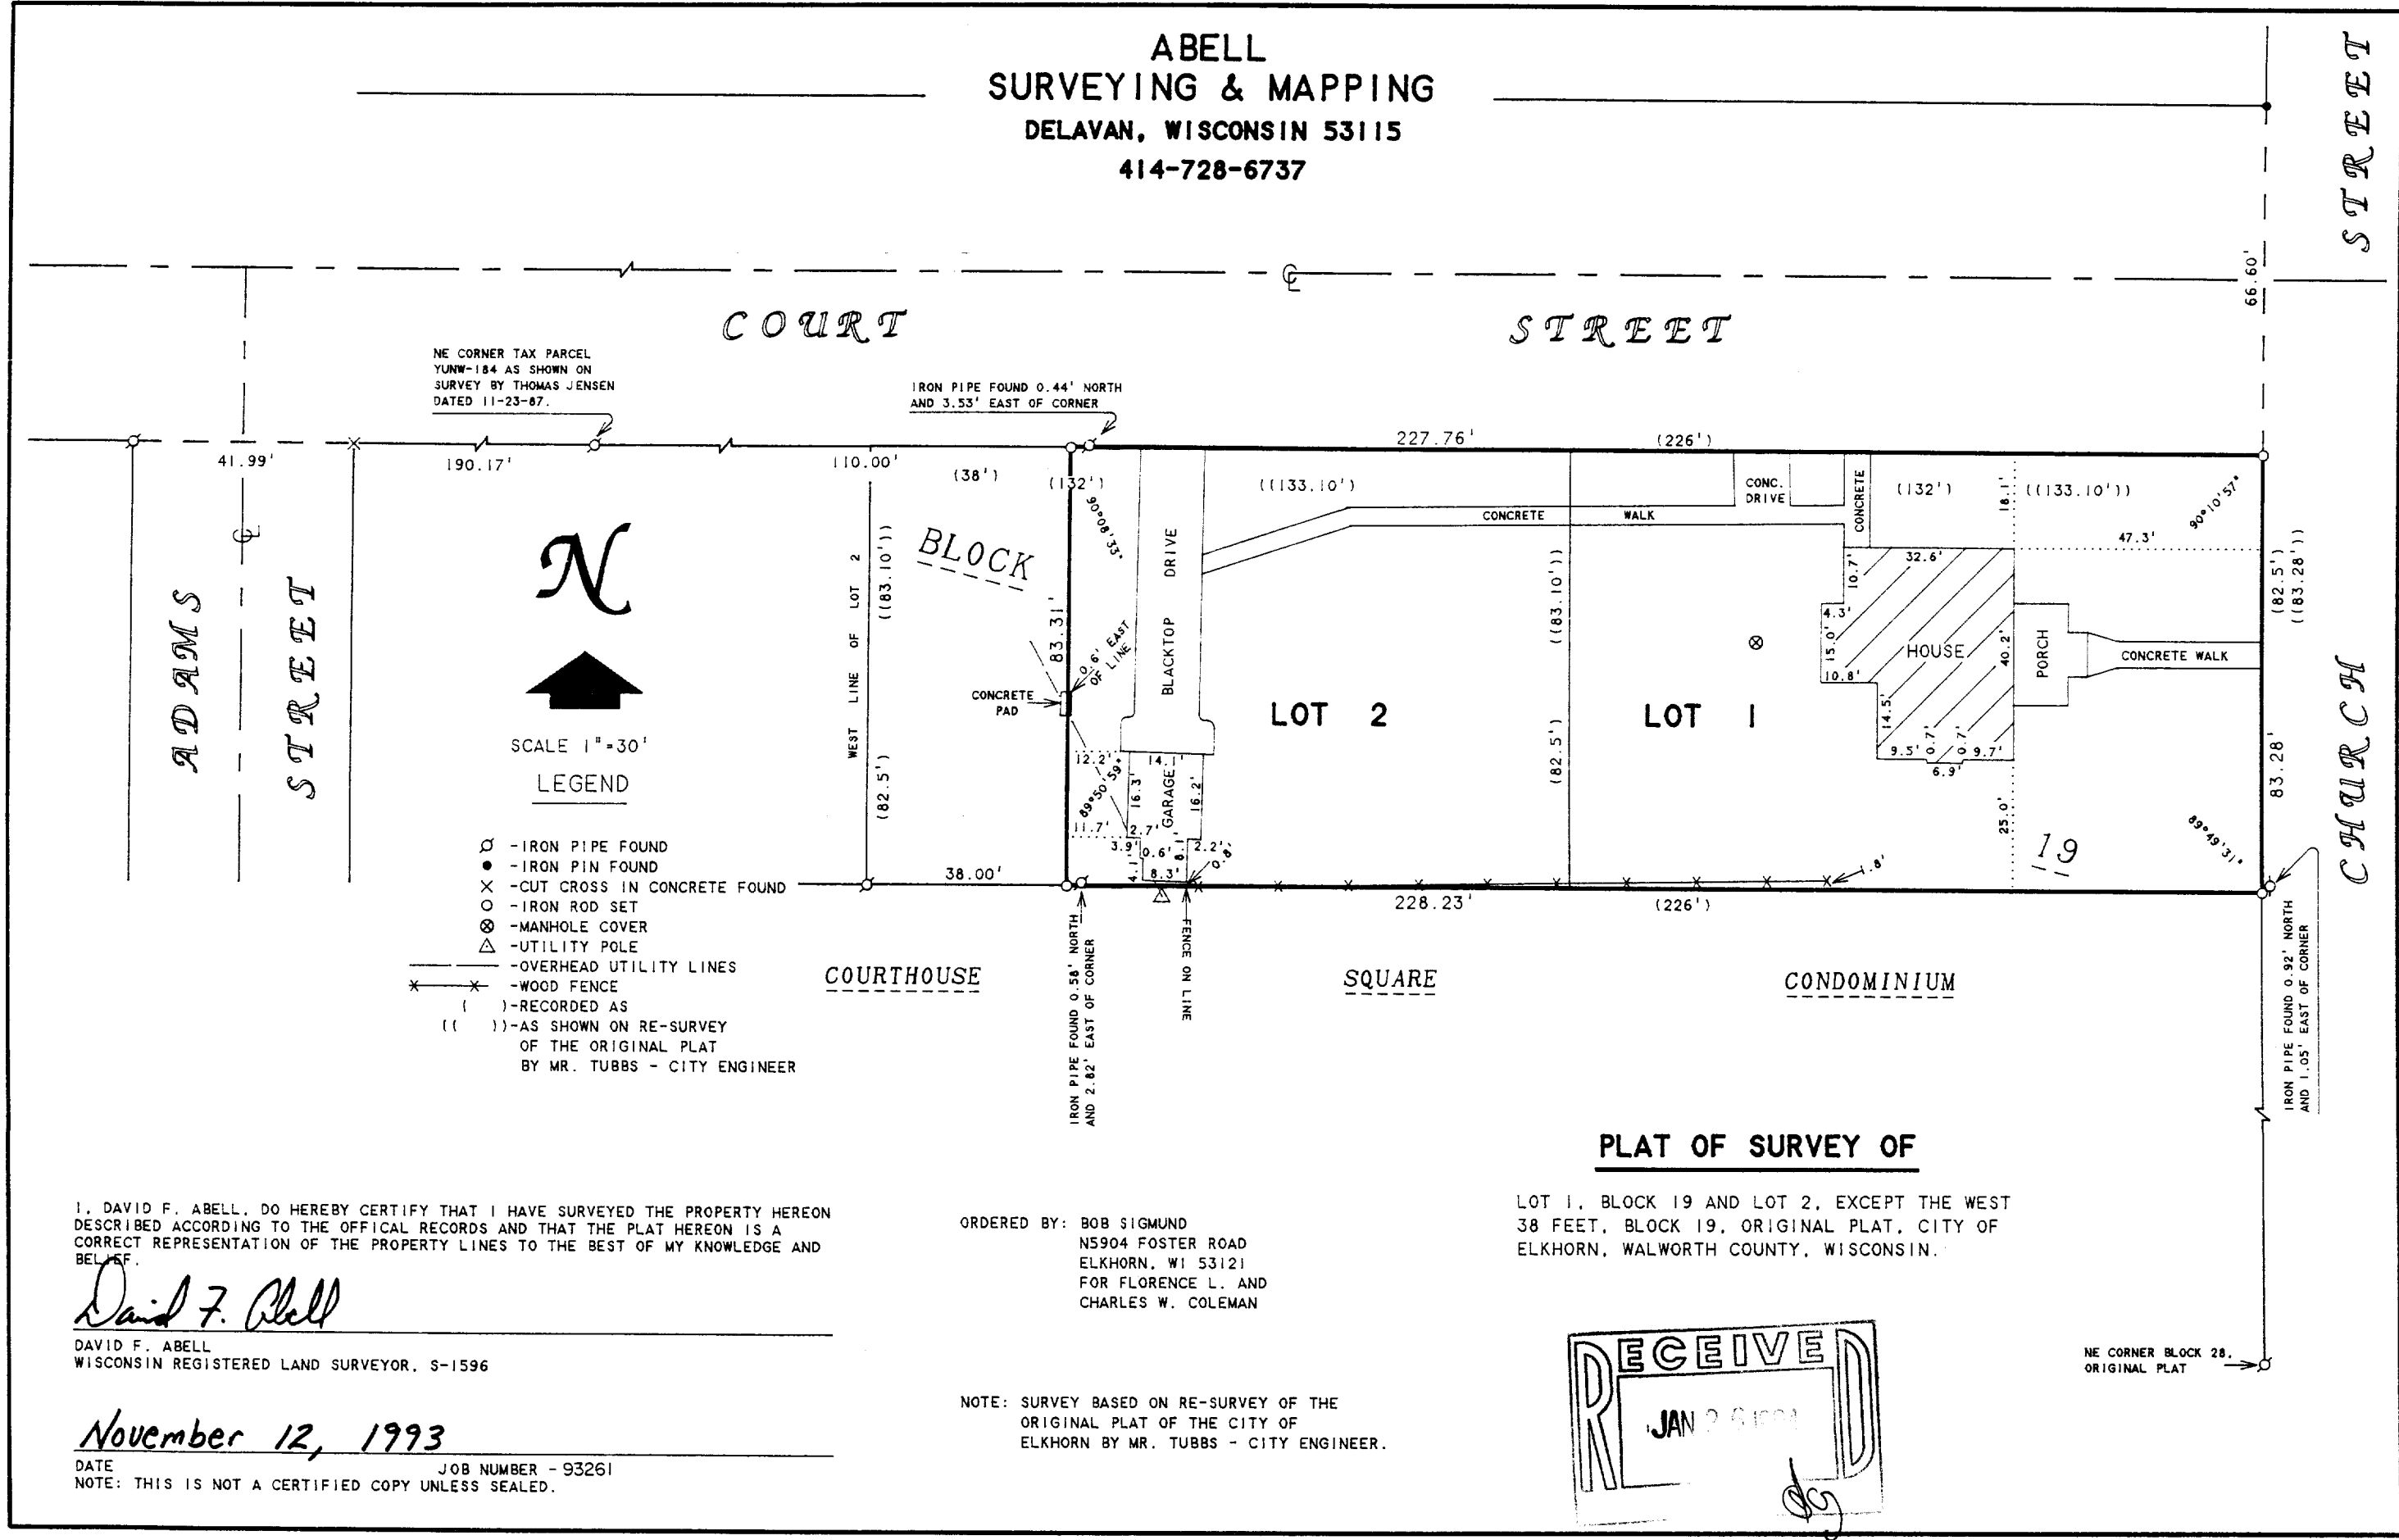

I, DAVID F. ABELL, DO HEREBY CERTIFY THAT I HAVE SURVEYED THE PROPERTY HEREON DESCRIBED ACCORDING TO THE OFFICIAL RECORDS AND THAT THE PLAT HEREON IS A CORRECT REPRESENTATION OF THE PROPERTY LINES TO THE BEST OF MY KNOWLEDGE AND BELIEF.

David F. Abell

DAVID F. ABELL
WISCONSIN REGISTERED LAND SURVEYOR, S-1596

November 12, 1993

DATE: November 12, 1993 JOB NUMBER - 93261
NOTE: THIS IS NOT A CERTIFIED COPY UNLESS SEALED.

YOP-135

4-830