


PLAT OF SURVEY
-OF-

LOT 7, RENDON SUBDIVISION, located in all quarters of the Northwest 1/4 of Section 31, Township 3 North, Range 17 East in the City of Elkhorn, Walworth County, Wisconsin.

Proposed house was staked on actual corners with 5 foot control on the longest house line. The Contractor will be responsible to field verify all stakes for location and dimension prior to construction. If any discrepancies should arise, notify this office at once.


Survey For: Southeastern Wisconsin Housing Corp.

Proposed Address: _____ Amparo Street
Proposed Fn. Fl.: _____


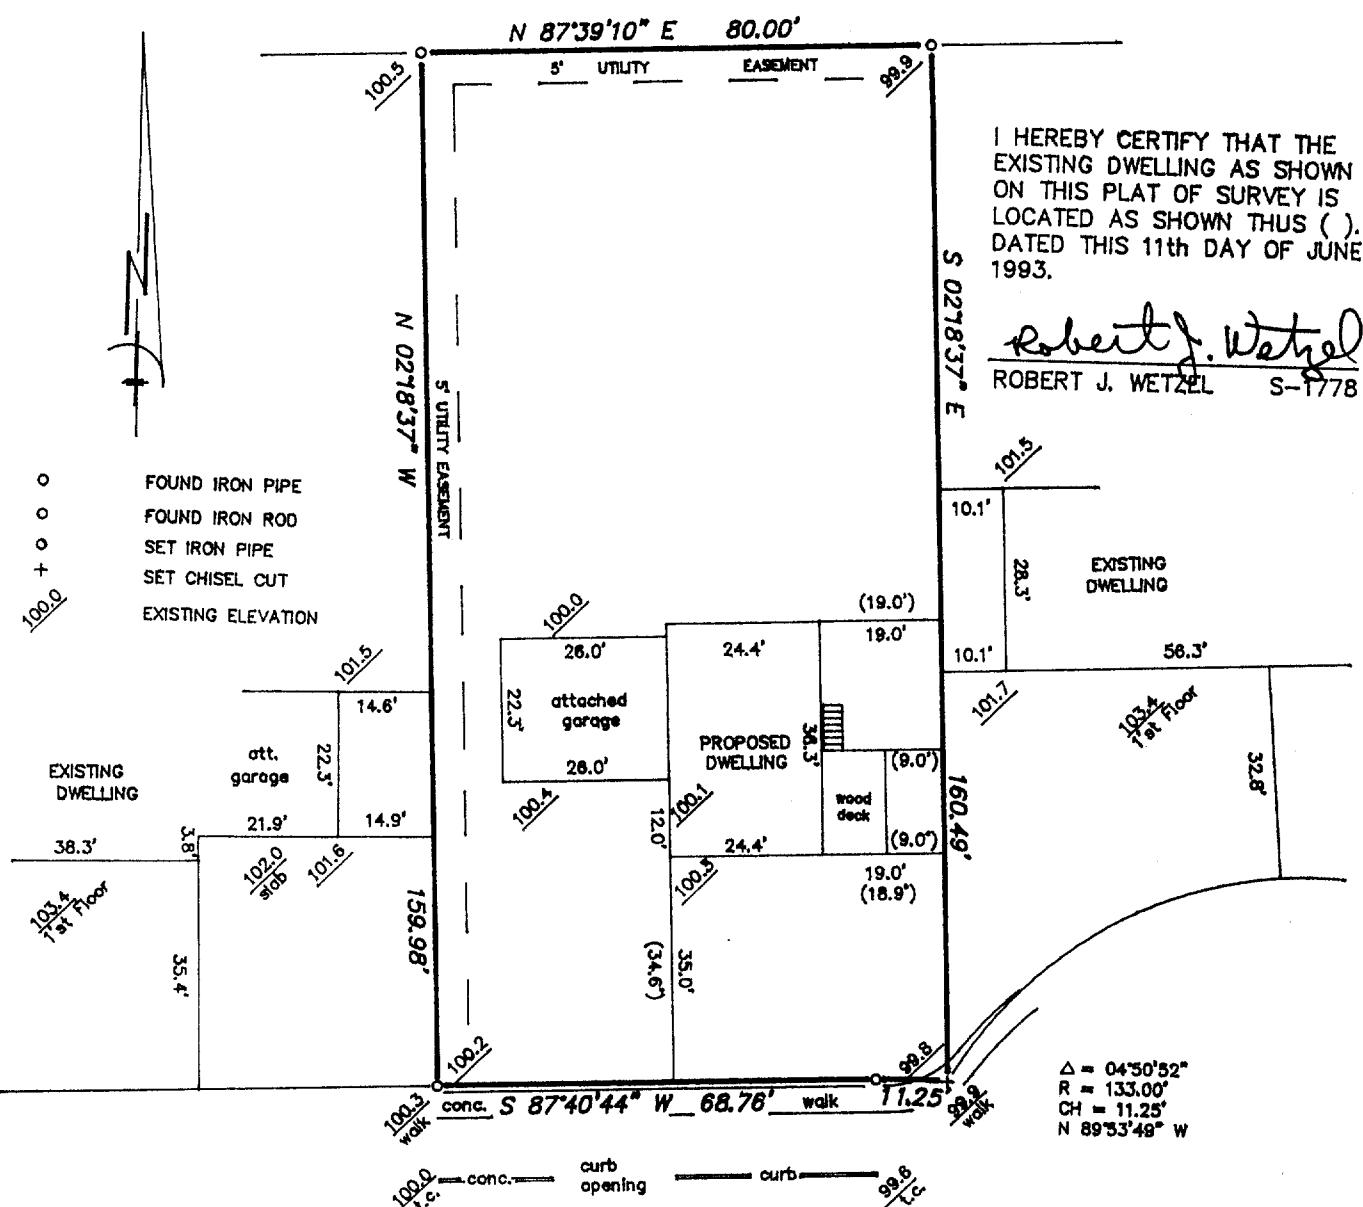


AMPARO —————  **100 FT.** **STREET**

manhole rim
assumed elevation 100.0

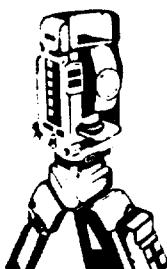

B.W. SURVEYING
Land Surveys
Mapping And Planning
35117 Academy Road
Burlington, Wisconsin 53105
(414) 534-4109

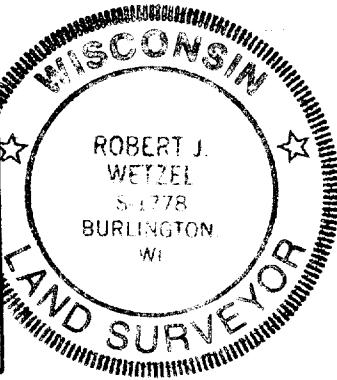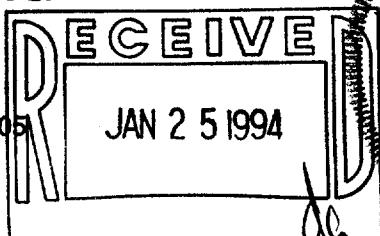

THIS IS NOT AN ORIGINAL PRINT
UNLESS THIS SEAL IS RED

"I hereby certify that I have surveyed the above described property and that the above map is a true representation thereof and shows the size and location of the property, its exterior boundaries, the location of all visible structures and dimensions of all principal buildings thereon, boundary fences, apparent easements, roadways and encroachments, if any."

ROBERT J. WETZEL
REGISTERED LAND SURVEYOR - 1778

Revised: 2/3/93

12/14/92
DATE

1101


PLAT OF SURVEY
-OF-

LOT 7, RENDON SUBDIVISION, located in all quarters of the Northwest 1/4 of Section 31, Township 3 North, Range 17 East. in the City of Elkhorn, Walworth County, Wisconsin.

Proposed house was staked on actual corners with 5 foot control on the longest house line. The Contractor will be responsible to field verify all stakes for location and dimension prior to construction. If any discrepancies should arise, notify this office at once.


Survey For: Southeastern Wisconsin Housing Corp.

Proposed Address: _____ Amparo Street.
Proposed Fln. Fl.: _____

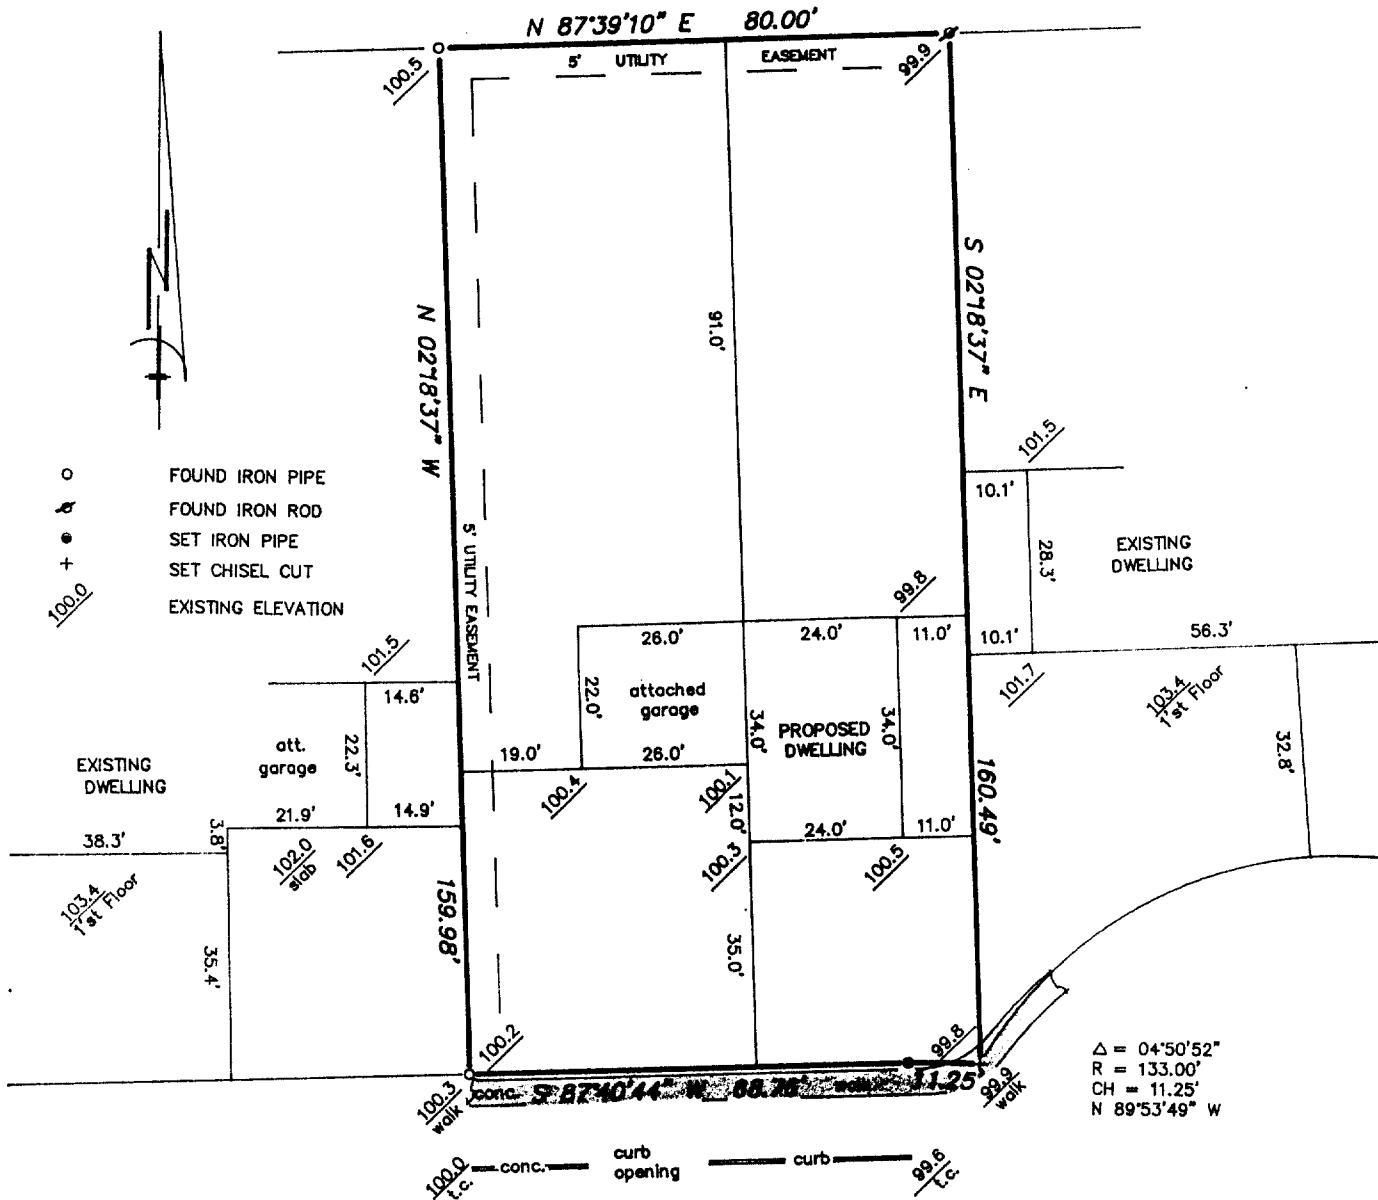


$\Delta = 04^{\circ}50'52''$
 $R = 133.00'$
 $CH = 11.25'$
 $N 89^{\circ}53'49'' W$

— — — **AMPARO** —  $\frac{100.0}{\text{ft}}$ (66' WIDE) — **STREET** —  $\frac{87.7}{\text{ft}}$ — — —
manhole rim
assumed elevation 100.0

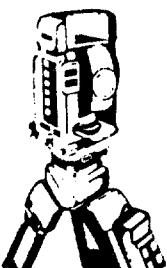

B.W. SURVEYING

Land Surveys
Mapping And Planning
35117 Academy Road
Burlington, Wisconsin 53105
(414) 534-4109

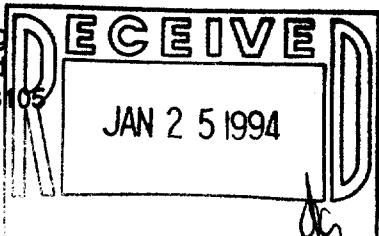

THIS IS NOT AN ORIGINAL PRINT
UNLESS THIS SEAL IS RED

ROBERT J. WETZEL
REGISTERED LAND SURVEYOR - 1778

"I hereby certify that I have surveyed the above described property and that the above map is a true representation thereof and shows the size and location of the property, its exterior boundaries, the location of all visible structures and dimensions of all principal buildings thereon, boundary fences, apparent easements, roadways and encroachments, if any."

"This survey is made for the use of the present owners of the property, and those who purchase, mortgage, or guarantee the title thereto within one year from date hereof."

12/14/92
DATE


1101
JOB NUMBER

PLAT OF SURVEY


-OF-

LOT 7, RENDON SUBDIVISION, LOCATED IN ALL QUARTERS OF THE NORTHWEST 1/4 OF SECTION 31, TOWNSHIP 3 NORTH, RANGE 17 EAST, IN THE CITY OF ELKHORN, WALWORTH COUNTY, WISCONSIN.

SURVEY FOR: SOUTHEASTERN WISCONSIN HOUSING CORP.


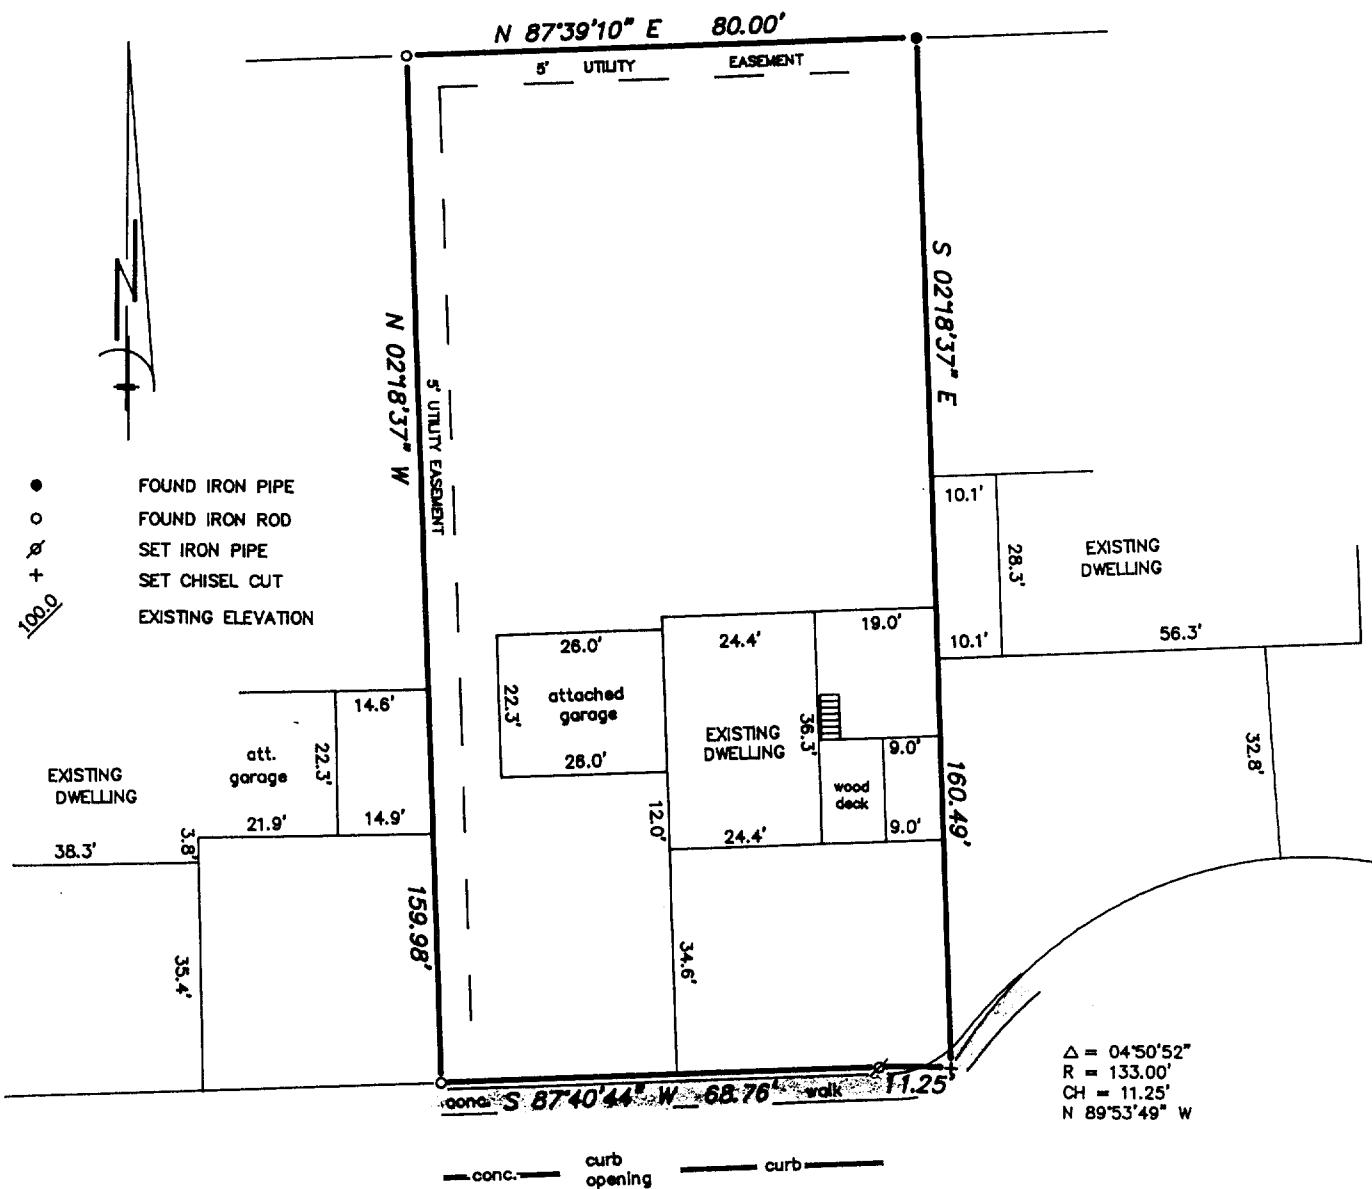


KIMBERLY — (66' WIDE) — **LANE**

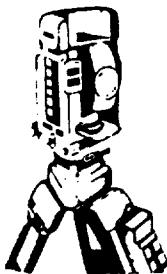

B.W. SURVEYING

Land Surveys
 Mapping And Planning
 35117 Academy Road
 Burlington, Wisconsin 53105
 (414) 534-4109

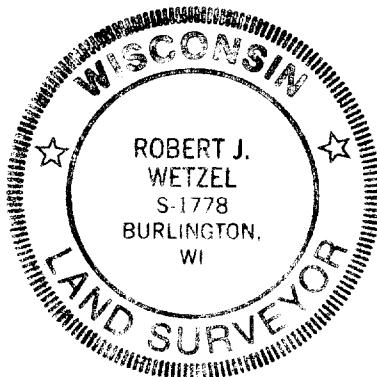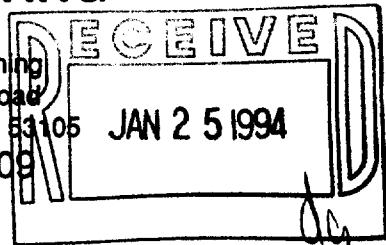

THIS IS NOT AN ORIGINAL PRINT
 UNLESS THIS SEAL IS RED

Robert J. Wetzel
 ROBERT J. WETZEL
 REGISTERED LAND SURVEYOR - 1778

"I hereby certify that I have surveyed the above described property and that the above map is a true representation thereof and shows the size and location of the property, its exterior boundaries, the location of all visible structures and dimensions of all principal buildings thereon, boundary fences, apparent easements, roadways and encroachments, if any."

"This survey is made for the use of the present owners of the property, and those who purchase, mortgage, or guarantee the title thereto within one year from date hereof."

7/14/93
 DATE

1101
 JOB NUMBER



PLAT OF SURVEY
-OF-

LOT 7, RENDON SUBDIVISION. Located in all quarters of the Northwest 1/4 of Section 31, Township 3 North, Range 17 East in the City of Elkhorn, Walworth County, Wisconsin.



Proposed house was staked on actual corners with 5 foot control on the longest house line. The Contractor will be responsible to field verify all stakes for location and dimension prior to construction. If any discrepancies should arise, notify this office at once.

Survey For: Southeastern Wisconsin Housing Corp.

Proposed Address: _____ Amparo Street
Proposed Fl. Fl.: _____

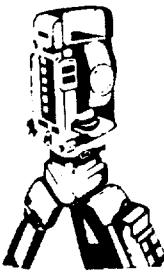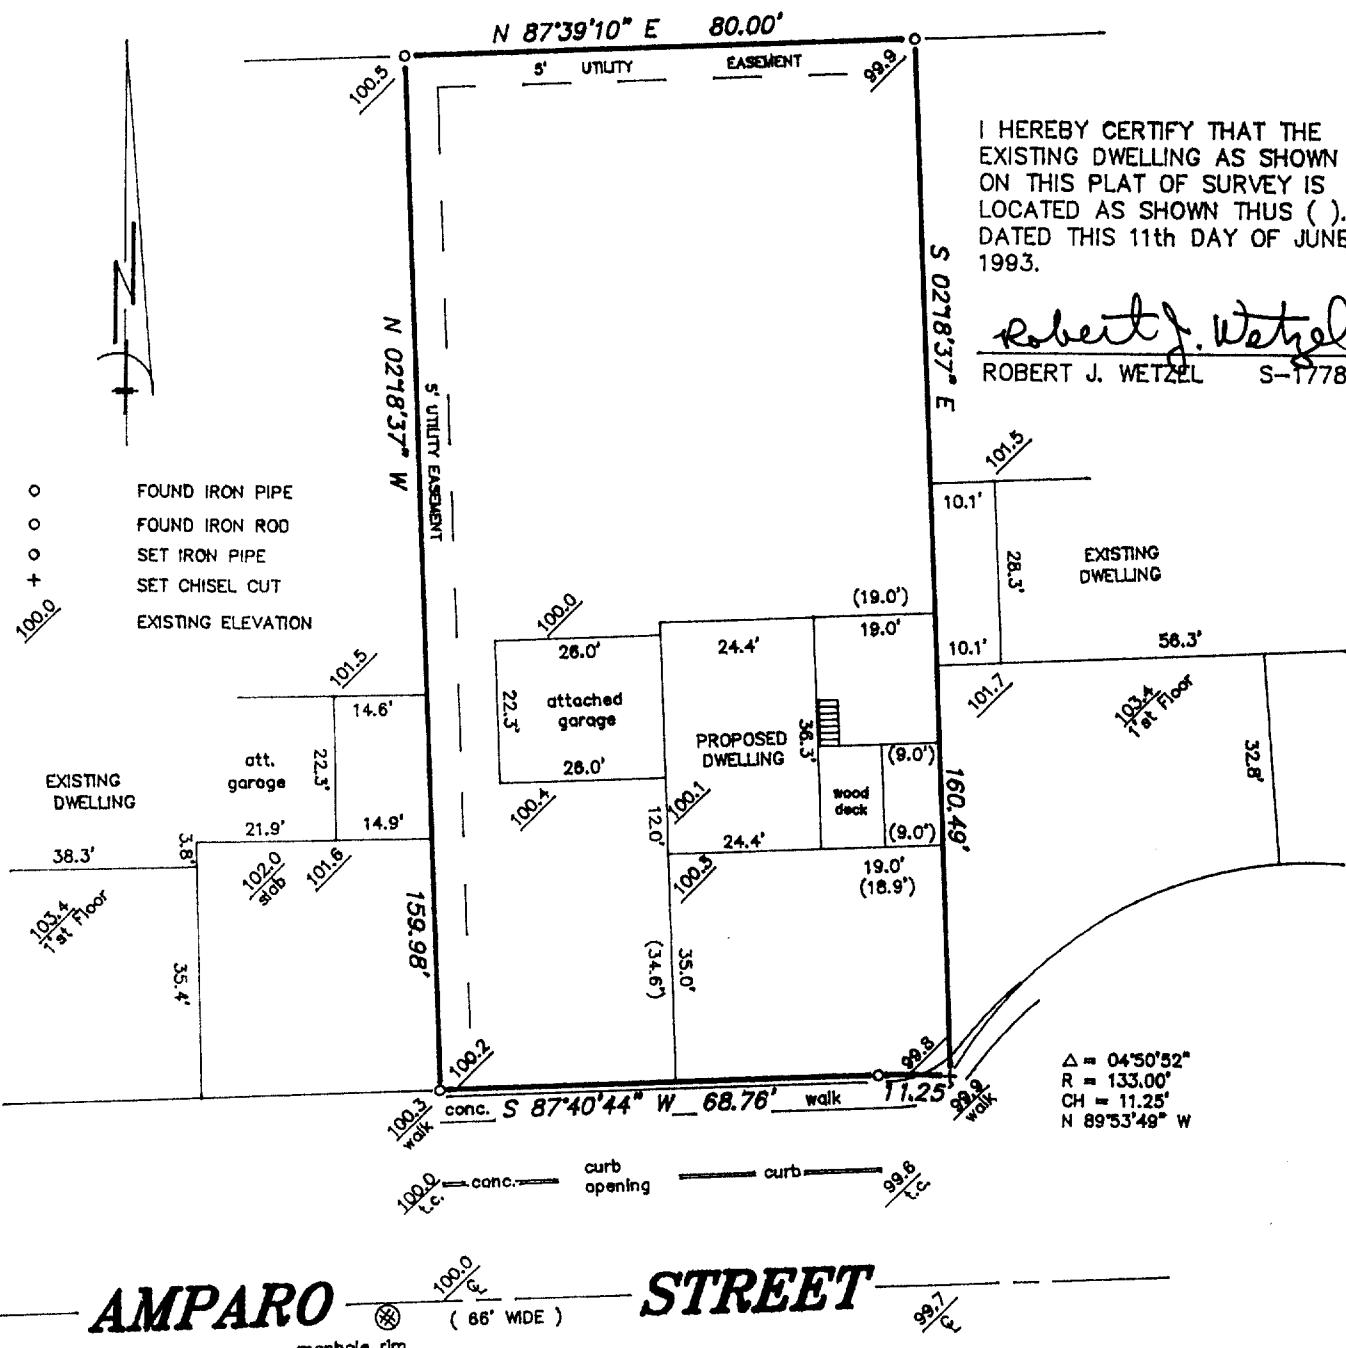

B.W. SURVEYING
Land Surveys
Mapping And Planning
35117 Academy Road
Burlington, Wisconsin 53105
(414) 534-4109

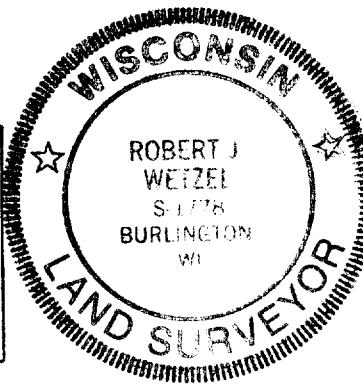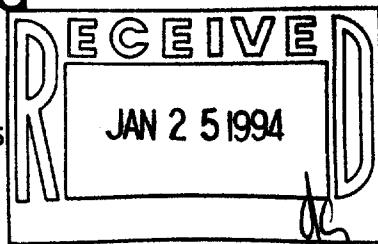

THIS IS NOT AN ORIGINAL PRINT
UNLESS THIS SEAL IS RED

Robert J. Wetzel
ROBERT J. WETZEL
REGISTERED LAND SURVEYOR - 1778

Revised: 2/3/93
12/14/92
DATE

1101
JOB NUMBER 4-835

"I hereby certify that I have surveyed the above described property and that the above map is a true representation thereof and shows the size and location of the property, its exterior boundaries, the location of all visible structures and dimensions of all principal buildings thereon, boundary fences, apparent easements, roadways and encroachments, if any."

"This survey is made for the use of the present owners of the property, and those who purchase, mortgage, or guarantee the title thereto within one year from date hereof."

YRE-7