
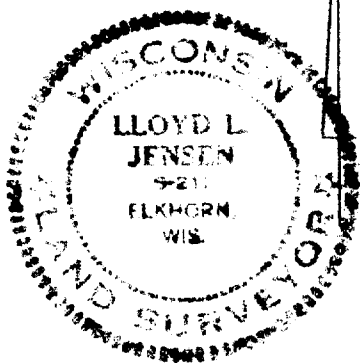


PLAT OF SURVEY OF

LOTS 3 & 4 BLOCK 18, ORIGINAL PLAT, CITY OF
ELKHORN, WALWORTH COUNTY, WISCONSIN

JEFFERSON ST.

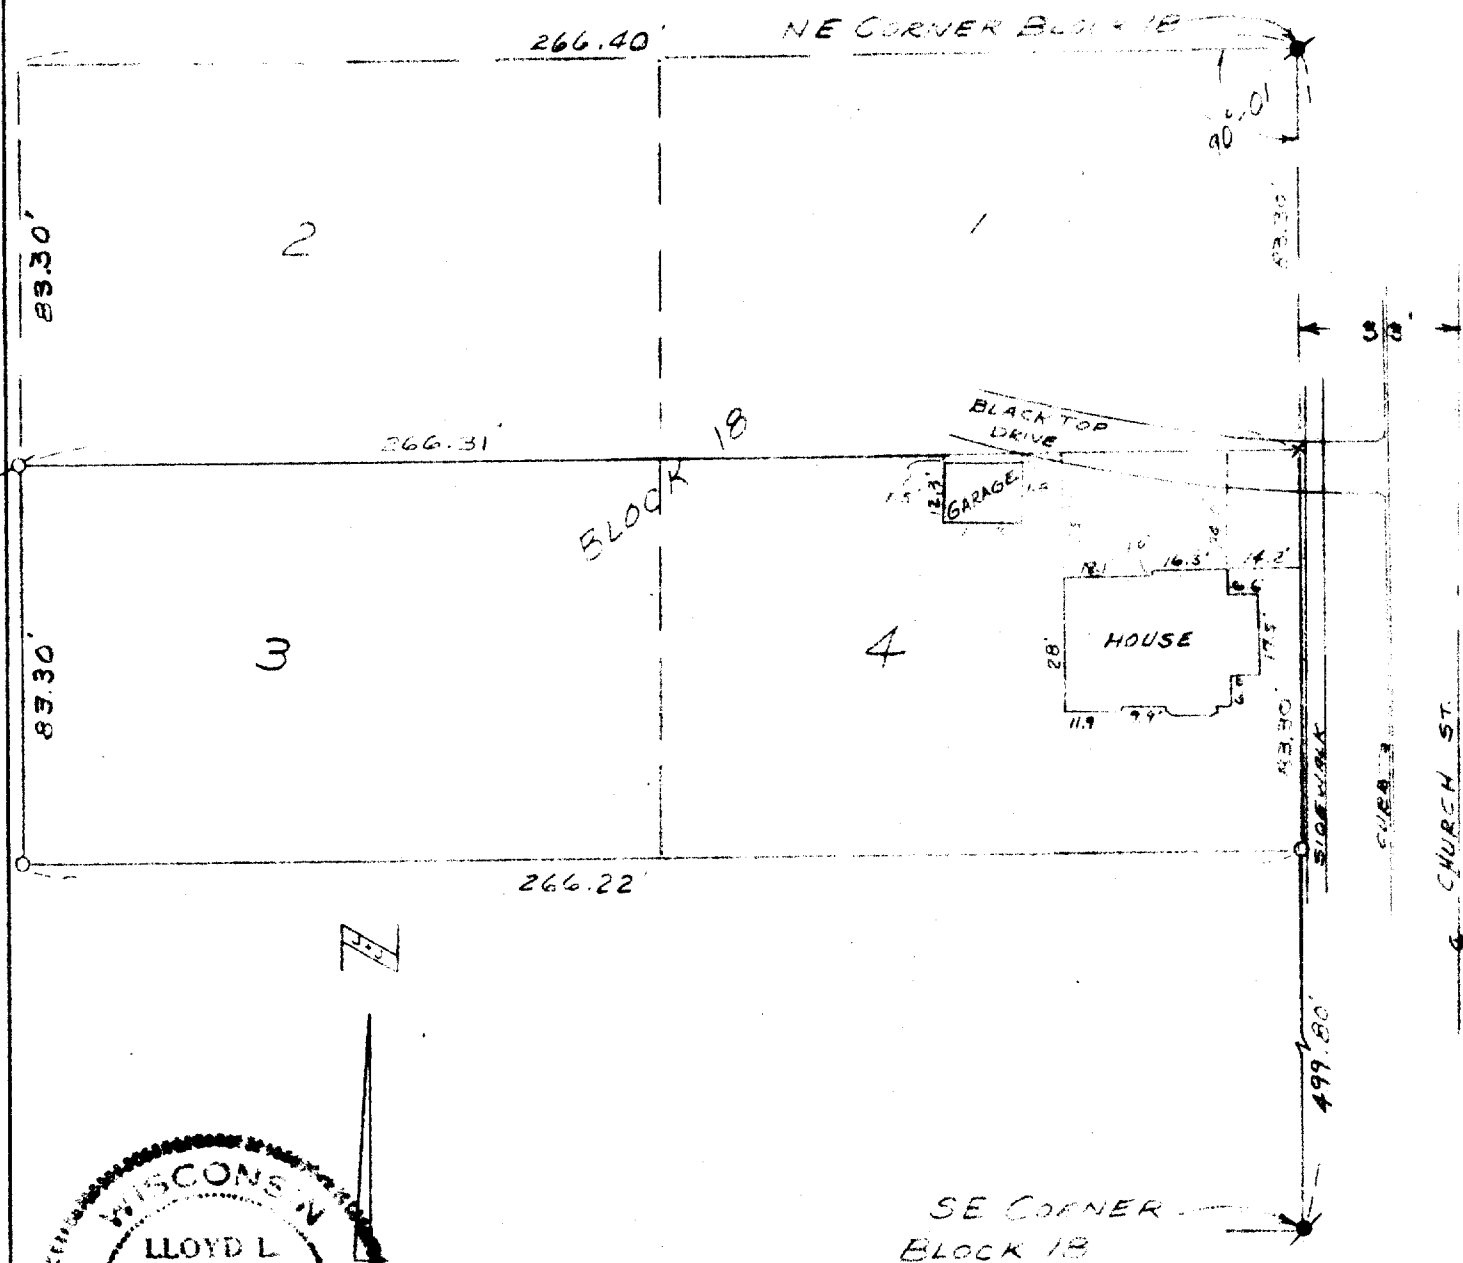

LEGEND

○ — Iron Pipe FOUND

● — Concrete Monument

Scale 1" = 40'

○ — IRON PIPE FOUND

○ — IRON PIPE SET

X — PK NAIL SET

VOR 128

WE CERTIFY: That we have surveyed the above described property and that the plat shown hereon is an accurate survey and a true representation thereof and correctly shows the exterior boundary lines and all divisions of said property.

Date FEB 1968

SURVEY AND PLAT BY

JENSEN & JOHNSON, INC.
CIVIL ENGINEERS AND SURVEYORS

Elkhorn, Wisconsin

Wisconsin Registered Land Surveyor, No. S

LLOYD L. JENSEN,

4-83J