



59-27

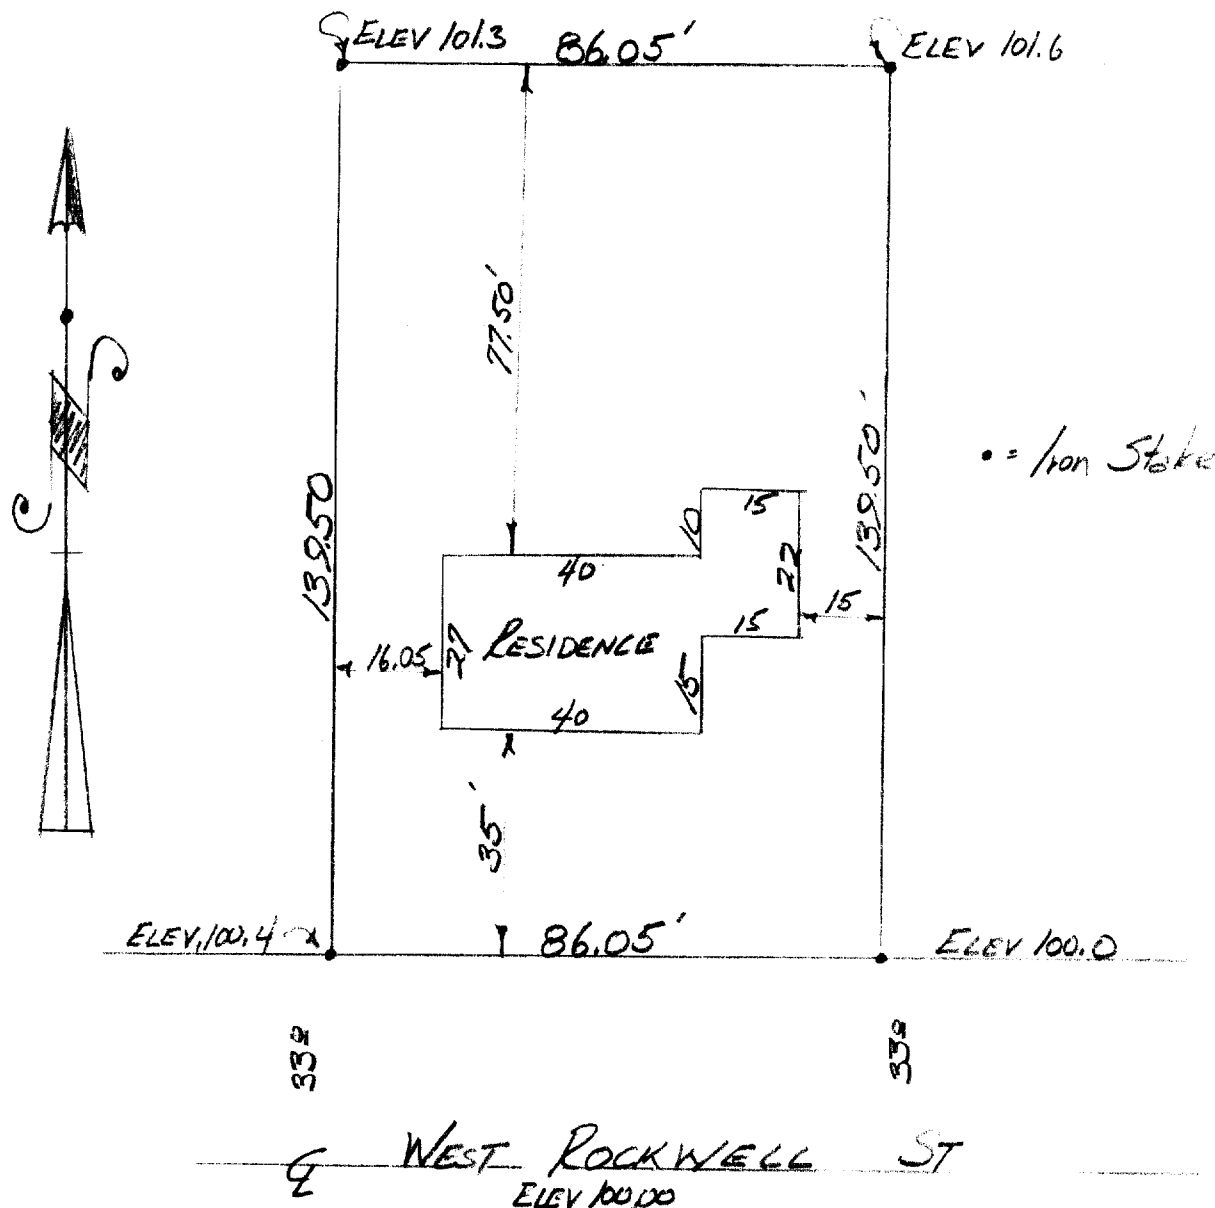

DESCRIPTION: The West 35 feet of Lot 13 and the East 51.05 feet of Lot 14 of James Jones 1st Addition to the City of Elkhorn, Walworth County, Wisconsin.

CERTIFICATE: I James F. Biagi, surveyor, do hereby certify that I have surveyed the property hereon described and that the measurements shown on the above drawing are true and accurate.

SIGNED AND SEALED THIS DAY OF JULY, 1959

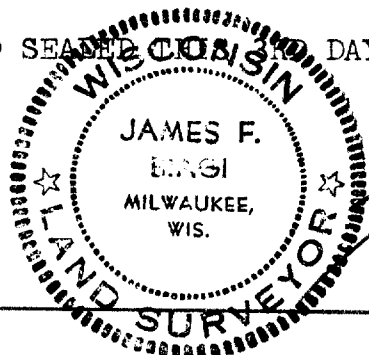

Surveyor (272)

JA-13

4-84 B